

37930

SPRINTER L-2563 G

These worksheets must be completed and signed by the installer.
Submit the originals with the packet.

Installer DAVID ALBRIGHT License # IHI 1129420

911 Address where home is being installed. 248 NW WHITNEY GLEN

Manufacturer LIVE OAK HOMES Length x width 28 x 56/60

NOTE: If home is a single wide fill out one half of the blocking plan
if home is a triple or quad wide sketch in remainder of home


I understand Lateral Arm Systems cannot be used on any home (new or used)
where the sidewall ties exceed 5 ft 4 in.

Installer's initials DA

Typical pier spacing

2' 5' lateral longitudinal

Show locations of Longitudinal and Lateral Systems
(use dark lines to show these locations)

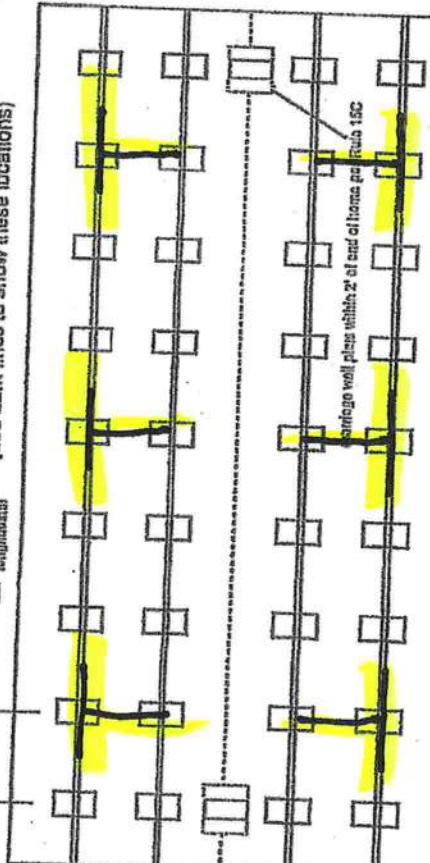

10-30-2020

page 1 of 2

New Home ☒ Used Home ☐

Home installed to the Manufacturer's Installation Manual

Home is installed in accordance with Rule 15-C

Single wide ☐

Wind-Zone II ☒

Wind Zone III ☐

Double wide ☒

Installation Decal # 72912

Triple/Quad ☐

Serial # LOHGA 21833618 AB

PIER SPACING TABLE FOR USED HOMES

Load bearing capacity	Footer size (sq in)	16" x 16" (256)	18 1/2" x 18 1/2" (342)	20" x 20" (400)	22" x 22" (484)	24" x 24" (576)	26" x 26" (676)
1000 dsf	3'	4'	5'	6'	7'	8'	8'
1500 dsf	4'	5'	6'	7'	8'	8'	8'
2000 dsf	5'	6'	7'	8'	8'	8'	8'
2500 dsf	6'	7'	8'	8'	8'	8'	8'
3000 dsf	7'	8'	8'	8'	8'	8'	8'
3500 dsf	8'	8'	8'	8'	8'	8'	8'

* Interpolated from Rule 15C-1 pier spacing table.

PIER PAD SIZES

I-beam pier pad size 17 x 22

Perimeter pier pad size 16 x 16

Other pier pad sizes (required by the mfg.) 23 x 31

Draw the approximate locations of marriage wall openings 4 foot or greater. Use this symbol to show the piers.

List all marriage wall openings greater than 4 foot and their pier pad sizes below.

Opening

Pier pad size

FACTORY

DIAGRAM

ANCHORS

4 ft ☒ 5 ft ☐ SHEARWALL

FRAME TIES

Within 2' of end of home spaced at 5' 4" oc

TIEDOWN COMPONENTS

Longitudinal Stabilizing Device (LSD) OTI

Longitudinal Stabilizing Device w/ Lateral Arms OTI

OTHER TIES

Number

13 PER SIDE

Longitudinal Marriage wall

Shearwall

Mobile Home Permit Worksheet

Application Number: _____

Date: _____

POCKET PENETROMETER TEST

The pocket penetrometer tests are rounded down to 1500 psf or check here to declare 1000 lb. soil _____ without testing.

X 1500 X 1700 X 1700

POCKET PENETROMETER TESTING METHOD

1. Test the perimeter of the home at 6 locations.
2. Take the reading at the depth of the footer.
3. Using 500 lb. increments, take the lowest reading and round down to that increment.

X 1500 X 1700 X 1500

TORQUE PROBE TEST

The results of the torque probe test is 285 inch pounds or check here if you are declaring 5' anchors without testing _____. A test showing 275 inch pounds or less will require 5 foot anchors.

Note: A state approved lateral arm system is being used and 4 ft. anchors are allowed at the sidewall locations. I understand 5 ft anchors are required at all centerline tie points where the torque test reading is 275 or less and where the mobile home manufacturer may require anchors with 4000 lb holding capacity.

Installer's initials DA

ALL TESTS MUST BE PERFORMED BY A LICENSED INSTALLER

Installer Name DAVID ALBRIGHT MOBILE HOME SVC

Date Tested _____

Electrical

Connect electrical conductors between multi-wide units, but not to the main power source. This includes the bonding wire between multi-wide units. Pg. 73-77

Plumbing

Connect all sewer drains to an existing sewer tap or septic tank. Pg. 79-80

Connect all potable water supply piping to an existing water meter, water tap, or other independent water supply systems. Pg. 78-110

Site Preparation

Debris and organic material removed X

Water drainage: Natural _____ Swale _____ Pad X _____ Other _____

Fastening multi wide units

Floor: _____ Type Fastener: LAGS _____ Length: 6" _____ Spacing: 2' _____
Walls: _____ Type Fastener: SCREWS _____ Length: 3" _____ Spacing: 18" _____
Roof: _____ Type Fastener: LAGS _____ Length: 6" _____ Spacing: 2' _____
For used homes a min. 30 gauge, 8" wide, galvanized metal strip will be centered over the peak of the roof and fastened with galv. roofing nails at 2" on center on both sides of the centerline.

Gasket (weatherproofing requirement)

I understand a properly installed gasket is a requirement of all new and used homes and that condensation, mold, mildew and buckled marriage walls are a result of a poorly installed or no gasket being installed. I understand a strip of floor tape will not serve as a gasket.

Installer's initials DA

Type gasket FACTORY

Pg. 41

Installed:

Between Floors Yes X

Between Walls Yes END WALLS

Bottom of ridgebeam Yes X

Weatherproofing


The bottomboard will be repaired and/or taped. Yes X Pg. 124
Siding on units is installed to manufacturer's specifications. Yes X
Fireplace chimney installed so as not to allow intrusion of rain water. Yes X

Miscellaneous

Skirting to be installed. Yes _____ No X
Dryer vent installed outside of skirting. Yes _____ N/A X
Range downflow vent installed outside of skirting. Yes _____ N/A X
Drain lines supported at 4 foot intervals. Yes X
Electrical crossovers protected. Yes X
Other: _____

Installer verifies all information given with this permit worksheet is accurate and true based on the manufacturer's installation instructions and or Rule 15C-1 & 2

Installer Signature David Albright Date _____

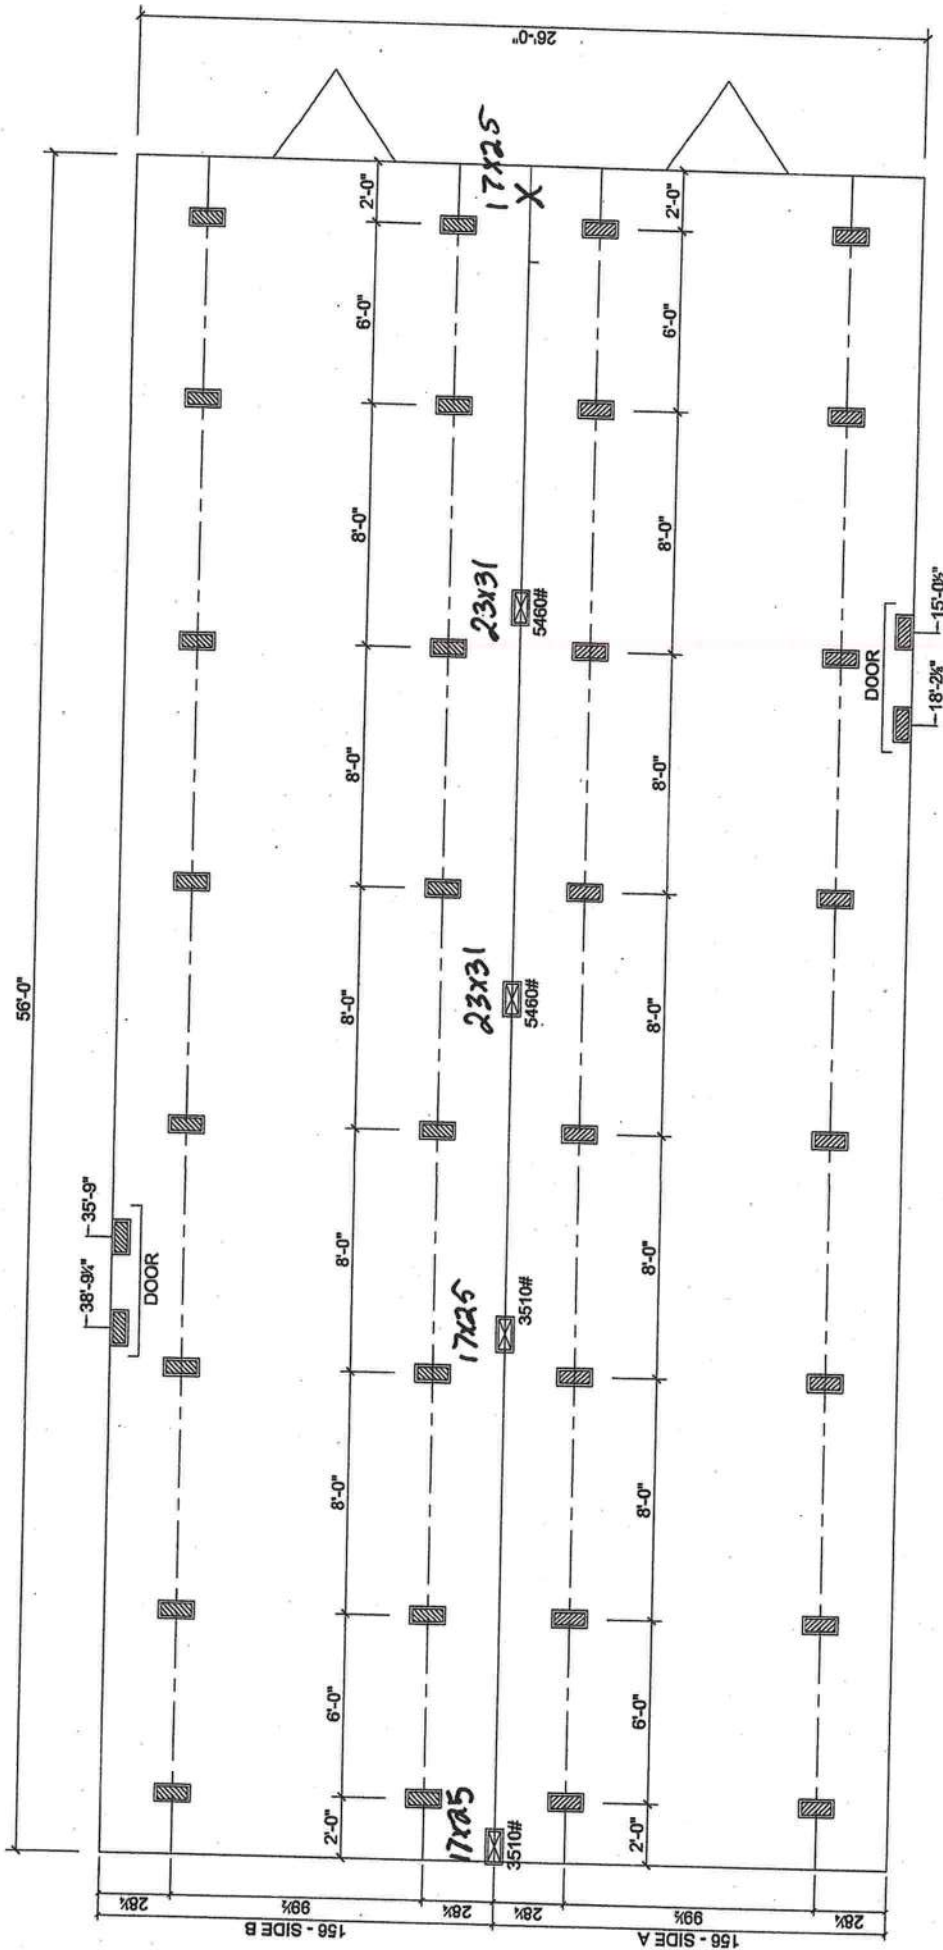

☒ MARRIAGE LINE OPENING SUPPORT PIERTYP.
☒ SUPPORT PIERTYP

FOUNDATION NOTES:

- THIS DRAWING IS DESIGNED FOR THE STANDARD WIND ZONE AND IS TO BE USED IN CONJUNCTION WITH THE INSTALLATION MANUAL AND ITS SUPPLEMENTS.
- FOOTINGS ARE SHOWN FOR EXAMPLE ONLY QUANTITY AND SPACING MAY VARY BASED ON PAD TYPE, SOIL CONDITION, ETC.
- FOOTINGS ARE REQUIRED AT SUPPORT POSTS, SEE INSTALLATION MANUAL FOR REQUIREMENTS.



1-9-2014

Live Oak Homes
MODEL: L-2563G - 28 X 56
3-BEDROOM / 2-BATH
SPRINTER

- | | |
|------------------------------|---|
| (A) MAIN ELECTRICAL | (G) DUCT CROSSOVER |
| (B) ELECTRICAL CROSSOVER | (H) SEWER DROPS |
| (C) WATER INLET | (I) RETURN AIR (W/OPT. HEAT PUMP OH DUCT) |
| (D) WATER CROSSOVER (IF ANY) | (J) SUPPLY AIR (W/OPT. HEAT PUMP OH DUCT) |
| (E) GAS INLET (IF ANY) | |
| (F) GAS CROSSOVER (IF ANY) | |

L-2563G

5'-8" **8'-7"** **8'-10"** **11'-10"** **8'-8"** **4'-9"** **10'-1"**

56'-0" 98" SIDEWALL

DORMERS SHOWN ARE OPTIONAL

#1 BATH

WASH DRY

W/H

REFER

OPT. STOVE

OPT. DW

3027

3053

DINING

#2 BATH

#2 BEDROOM
9'-7" x 12'-8"

3053E

#3 BEDROOM
9'-7" x 12'-8"

3053E

10'-0" **4'-8"**

24'-1" **17'-6"**

4053 **4053** **3690**

LIVING ROOM
23'-10" x 12'-8"

MASTER BEDROOM
17'-0" x 12'-8"



Date: 10-30-2013

* All room dimensions include closets and square footage figures are approximate.
* Transom windows are available on optional 9'-0" sidewall houses only.