


Mobile Home Permit Worksheet

Installer: Ernest Scott Johnson License # 141025249

Address of home being installed 1431 SW Montego Ave
Lake City FL 32024


Manufacturer Clayton Homes Length x width 32x76

NOTE: If home is a single wide fill out one half of the blocking plan. If home is a triple or quad wide sketch in remainder of home. Understand Lateral Arm Systems cannot be used on any home (new or used) where the sidewall ties exceed 5 ft 4 in.

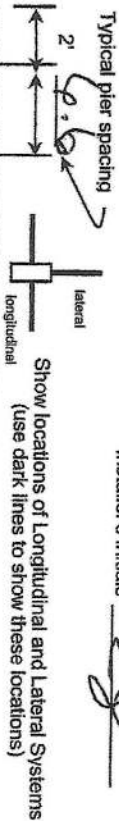

Installer's initials

[Handwritten initials]

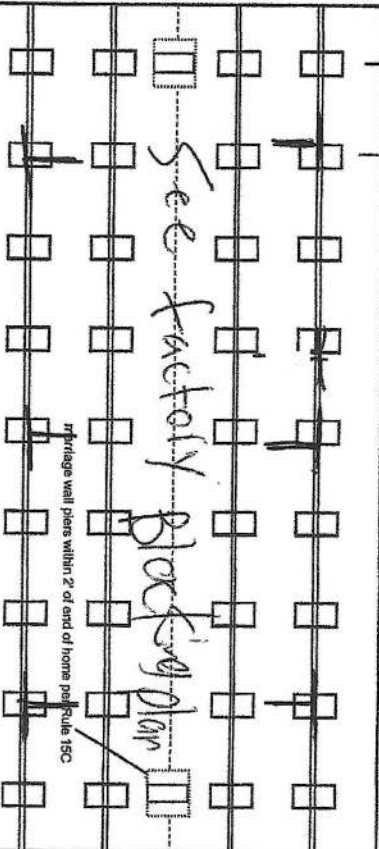

Application Number: 55343 Date: 10/27/22

New Home ☒ Used Home ☐

Home installed to the Manufacturer's Installation Manual ☒

Home is installed in accordance with Rule 15-C ☒

Single wide ☐ Wind Zone II ☒ Wind Zone III ☐

Double wide ☒ Installation Decal # 90750

Triple/Quad ☐ Serial # 27344

PIER SPACING TABLE FOR USED HOMES

Load bearing capacity (sq ft)	16' x 16" (256)	18' 1/2" x 18' (342)	20' x 20" (400)	22' x 22" (484)	24' x 24" (576)	26' x 26" (676)
1000 psf	3'	4'	5'	6'	7'	8'
1500 psf	4' 6"	6'	7'	8'	8'	8'
2000 psf	6'	8'	8'	8'	8'	8'
2500 psf	7' 6"	8'	8'	8'	8'	8'
3000 psf	8'	8'	8'	8'	8'	8'
3500 psf	8'	8'	8'	8'	8'	8'

* Interpolated from Rule 15C-1 pier spacing table.

PIER PAD SIZES

I-beam pier pad size 2-3X31 6x6

Perimeter pier pad size 8 1/4 x 10 3/4 x 11 1/4 x 17 1/2 x 5 1/2

Other pier pad sizes (required by the mfg.) _____

Draw the approximate locations of marriage wall openings 4 foot or greater. Use this symbol to show the piers.

List all marriage wall openings greater than 4 foot and their pier pad sizes below.

POPULAR PAD SIZES	Pad Size	Sq ft
	16 x 16	256
	16 x 18	288
	18.5 x 18.5	342
	16 x 22.5	360
	17 x 22	374
	13 1/4 x 26 1/4	348
	20 x 20	400
	17 3/16 x 25 3/16	441
	17 1/2 x 25 1/2	446
	24 x 24	576
	26 x 26	676

Opening Pier pad size

See factory

Blocking Plan

TIEDOWN COMPONENTS

Longitudinal Stabilizing Device (LSD)

Manufacturer _____

Longitudinal Stabilizing Device w/ Lateral Arms

Manufacturer Shire 1101V

ANCHORS

4 ft 5 ft

FRAME TIES

within 2' of end of home spaced at 5' 4" oc

OTHER TIES

Sidewall _____ Number 38

Longitudinal _____

Marriage wall _____

Shearwall 10

Mobile Home Permit Worksheet

POCKET PENETROMETER TEST

The pocket penetrometer tests are rounded down to _____ psf or check here to declare 1000 lb. soil ☒ without testing.

x 1000 x _____ x _____

POCKET PENETROMETER TESTING METHOD

1. Test the perimeter of the home at 6 locations.
2. Take the reading at the depth of the footer.
3. Using 500 lb. increments, take the lowest reading and round down to that increment.

x _____ x _____ x 1000

TORQUE PROBE TEST

The results of the torque probe test is _____ inch pounds or check here if you are declaring 5' anchors without testing. A test showing 275 inch pounds or less will require 5 foot anchors.

Note: A state approved lateral arm system is being used and 4 ft. anchors are allowed at the sidewall locations. I understand 5 ft anchors are required at all centerline tie points where the torque test reading is 275 or less and where the mobile home manufacturer may requires anchors with 4000 lb holding capacity.

Installer's Initials

ALL TESTS MUST BE PERFORMED BY A LICENSED INSTALLER

Installer Name Ernest Scott Johnson

Date Tested Assumed Olivera 11/11/14 USES 485 Scott Anchors

Electrical

Connect electrical conductors between multi-wide units, but not to the main power source. This includes the bonding wire between multi-wide units. Pg. _____

Plumbing

Connect all sewer drains to an existing sewer tap or septic tank. Pg. _____

Connect all potable water supply piping to an existing water meter, water tap, or other independent water supply systems. Pg. _____

Application Number: _____

Date: _____

Site Preparation

Debris and organic material removed _____
Water drainage: Natural _____ Swale _____ Pad X Other _____

Fastening multi wide units

Floor: Type Fastener: 1/4" x 5" Length: 7 Spacing: 20
Walls: Type Fastener: 1/4" x 5" Length: 7 Spacing: 10
Roof: Type Fastener: 1/4" x 5" Length: 7 Spacing: 20
For used homes a min. 30 gauge, 8" wide, galvanized metal strip will be centered over the peak of the roof and fastened with galv. roofing nails at 2' on center on both sides of the centerline.

Gasket (weatherproofing requirement)

I understand a properly installed gasket is a requirement of all new and used homes and that condensation, mold, mildew and buckled marriage walls are a result of a poorly installed or no gasket being installed. I understand a strip of tape will not serve as a gasket.

Installer's Initials

Type gasket factory

Pg. OR R 11
Installed: Between Floors Yes
Between Walls Yes
Bottom of ridgebeam Yes

Weatherproofing

The bottomboard will be repaired and/or taped. Yes Pg. _____
Siding on units is installed to manufacturer's specifications. Yes
Fireplace chimney installed so as not to allow intrusion of rain water. Yes

Miscellaneous

Skirting to be installed. Yes No
Dryer vent installed outside of skirting. Yes No N/A
Range downflow vent installed outside of skirting. Yes No N/A
Drain lines supported at 4 foot intervals. Yes No N/A
Electrical crossovers protected. Yes No N/A
Other: _____

Installer verifies all information given with this permit worksheet is accurate and true based on the manufacturer's installation instructions and or Rule 15C-1 & 2

Installer Signature Ernest Scott Johnson Date 11/27/14

Summit


GENERAL NOTES:
 1. THE INFORMATION ON THIS DRAWING IS FOR THE DESIGN OF THE
 STRUCTURE ONLY. IT IS NOT TO BE USED FOR ANY OTHER PURPOSE.
 2. THE DESIGNER IS NOT RESPONSIBLE FOR THE CONSTRUCTION OF THE
 STRUCTURE OR FOR THE SAFETY OF THE STRUCTURE OR FOR THE
 SAFETY OF THE PEOPLE WHO USE THE STRUCTURE.
 3. THE DESIGNER IS NOT RESPONSIBLE FOR THE CONSTRUCTION OF THE
 STRUCTURE OR FOR THE SAFETY OF THE STRUCTURE OR FOR THE
 SAFETY OF THE PEOPLE WHO USE THE STRUCTURE.
 4. THE DESIGNER IS NOT RESPONSIBLE FOR THE CONSTRUCTION OF THE
 STRUCTURE OR FOR THE SAFETY OF THE STRUCTURE OR FOR THE
 SAFETY OF THE PEOPLE WHO USE THE STRUCTURE.
 5. THE DESIGNER IS NOT RESPONSIBLE FOR THE CONSTRUCTION OF THE
 STRUCTURE OR FOR THE SAFETY OF THE STRUCTURE OR FOR THE
 SAFETY OF THE PEOPLE WHO USE THE STRUCTURE.

REVISIONS

NO.	DATE	DESCRIPTION
1	10/1/20	ISSUED FOR PERMIT
2	10/1/20	ISSUED FOR PERMIT
3	10/1/20	ISSUED FOR PERMIT
4	10/1/20	ISSUED FOR PERMIT
5	10/1/20	ISSUED FOR PERMIT

PROJECT INFORMATION

PROJECT NO.	10/1/20
CLIENT	10/1/20
DESIGNER	10/1/20
DATE	10/1/20

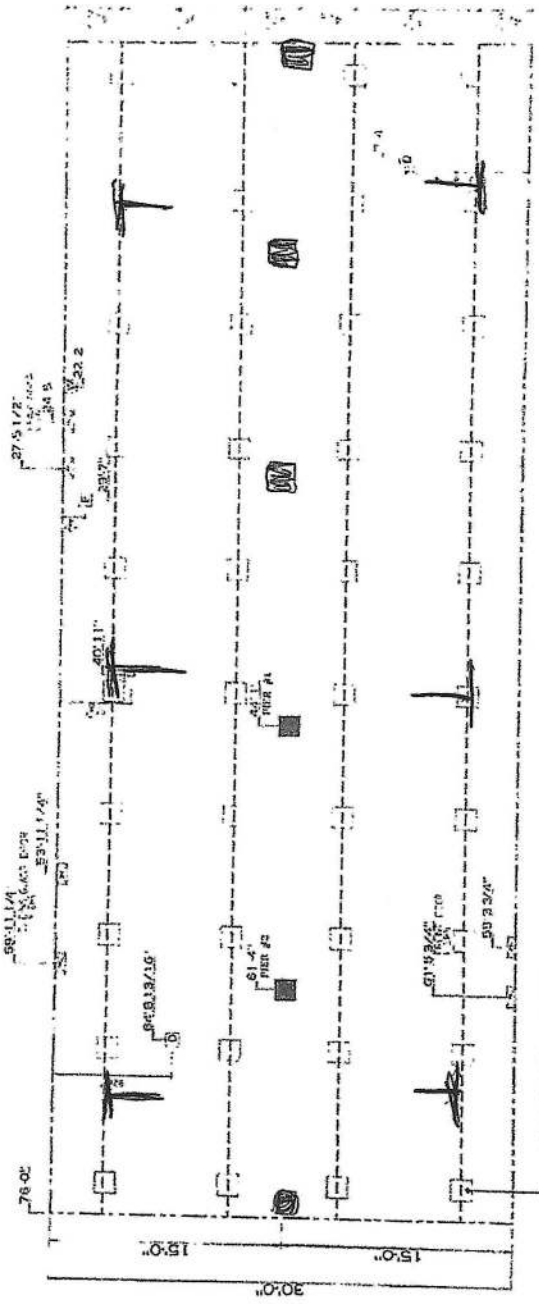

REINFORCEMENT SCHEDULE

NO.	DESCRIPTION	QUANTITY
1	Top Bars	10/1/20
2	Bottom Bars	10/1/20
3	Vertical Bars	10/1/20

REINFORCEMENT SCHEDULE

NO.	DESCRIPTION	QUANTITY
1	Top Bars	10/1/20
2	Bottom Bars	10/1/20
3	Vertical Bars	10/1/20

ERIC Collection

REV 1/22/2020 B 37 A4
 PIER LANS B 1/2"

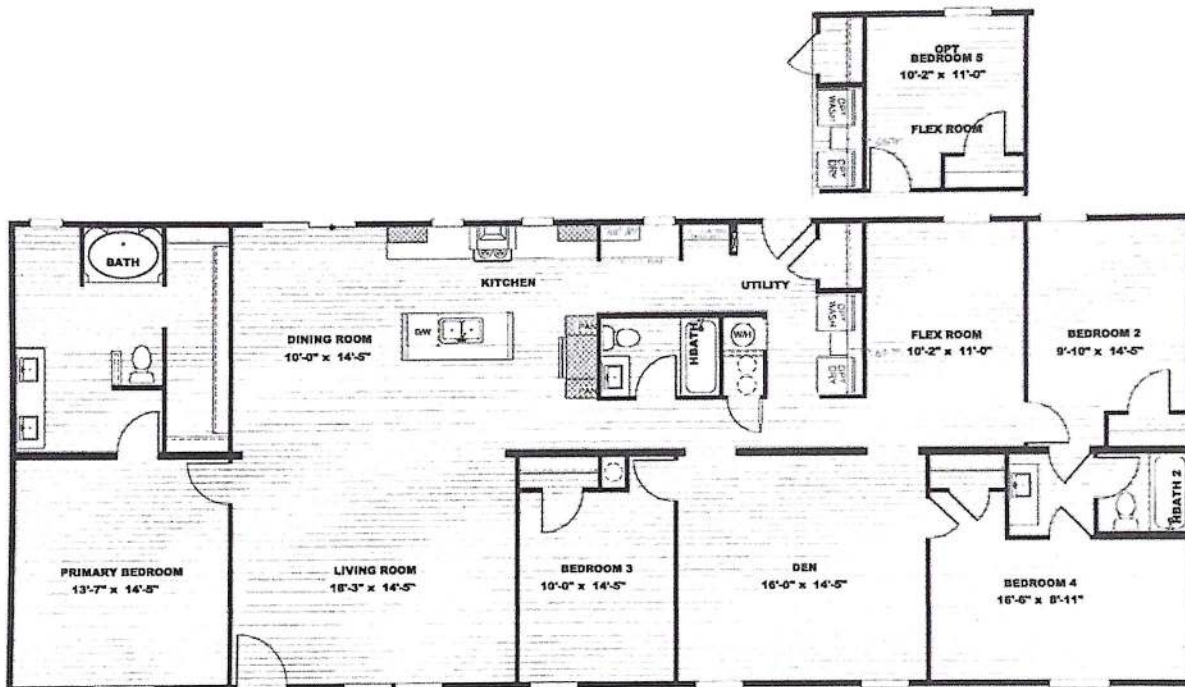

MODEL #CEE32764AH
DRAWING # CE-M030-76-4
32'x76' SUMMIT

*SCALE: 3/16"=1'-0"

Clayton Home