

Mobile Home Permit Worksheet

Installer Ernest S. Johnson License # TH1025249


Address of home being installed _____

Manufacturer Destiny Length x width 52 x 28

NOTE: If home is a single wide fill out one half of the blocking plan
If home is a triple or quad wide stretch in remainder of home
I understand Lateral Arm Systems cannot be used on any home (new or used)
where the sidewall ties exceed 5 ft 4 in.

Installer's initials [Signature]

Typical pier spacing 7.6
Show locations of Longitudinal and Lateral Systems
(use dark lines to show these locations)

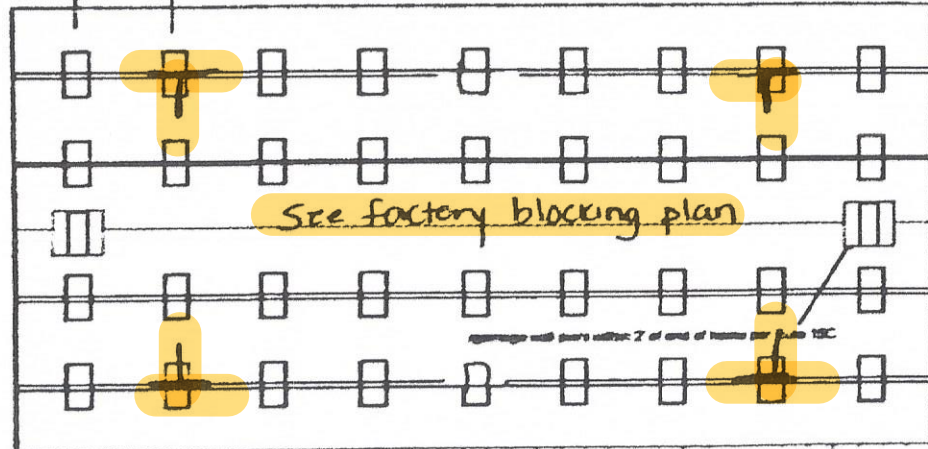

spacing wall piers within 2' of end of home per Rule 15C



[Signature]

01-25-2023

Application Number: _____ Date: _____

New Home ☒ Used Home ☐

Home installed to the Manufacturer's Installation Manual
Home is installed in accordance with Rule 15-C ☐

Single wide ☐ Wind Zone II ☒ Wind Zone III ☐

Double wide ☒ Installation Decal # 96446

Triple/Quad ☐ Serial # _____

PIER SPACING TABLE FOR USED HOMES

Load bearing capacity	Footer size (sq in)	16' x 16' (256)	18 1/2' x 18 1/2' (342)	20' x 20' (400)	22' x 22' (484)*	24' x 24' (576)*	28' x 28' (676)
1000 psf		3'	4'	5'	6'	7'	8'
1500 psf		4' 6"	6'	7'	8'	8'	8'
2000 psf		6'	8'	8'	8'	8'	8'
2500 psf		7' 6"	8'	8'	8'	8'	8'
3000 psf		8'	8'	8'	8'	8'	8'
3500 psf		8'	8'	8'	8'	8'	8'

* Interpolated from Rule 15C-1 pier spacing table.

PIER PAD SIZES

I-beam pier pad size 23 x 31 7.6
Perimeter pier pad size 17.5 x 25.5

Other pier pad sizes (required by the mfg.) _____

Draw the approximate locations of mamage wall openings 4 foot or greater. Use this symbol to show the piers.

List all mamage wall openings greater than 4 foot and their pier pad sizes below.

Opening _____ Pier pad size _____

See
factory
blocking plan

TIEDOWN COMPONENTS

Longitudinal Stabilizing Device (LSD)
Manufacturer _____
Longitudinal Stabilizing Device w/ Lateral Arms
Manufacturer Oliver 1101 v

POPULAR PAD SIZES

Pad Size	Sq In
15 x 16	256
16 x 18	288
18 5/8 x 18 5/8	342
16 x 22 5/8	360
17 x 22	374
13 1/4 x 25 1/4	348
20 x 20	400
17 3/16 x 25 3/16	441
17 1/2 x 25 1/2	446
24 x 24	576
26 x 26	676

ANCHORS

4 ft ☒ 5 ft ☒

FRAME TIES

within 2' of end of home
spaced at 5' 4" oc ☒

OTHER TIES

	Number
Sidewall	<u>24</u>
Longitudinal	<u>0</u>
Mamage wall	<u>6</u>
Shearwall	<u>2</u>

Mobile Home Permit Worksheet

POCKET PENETROMETER TEST

The pocket penetrometer tests are rounded down to _____ psf
or check here to declare 1000 lb soil without testing

x 1000 x 1000 x 1000

POCKET PENETROMETER TESTING METHOD

- 1 Test the penmeter of the home at 6 locations
- 2 Take the reading at the depth of the footer.
- 3 Using 500 lb. increments, take the lowest reading and round down to that increment

x 1000 x 1000 x 1000



TORQUE PROBE TEST

The results of the torque probe test is 275 inch pounds or check here if you are declaring 5' anchors without testing. A test showing 275 inch pounds or less will require 5 foot anchors

Note: A state approved lateral arm system is being used and 4 ft anchors are allowed at the sidewall locations. I understand 5 ft anchors are required at all centerline tie points where the torque test reading is 275 or less and where the mobile home manufacturer may require anchors with 4000 lb holding capacity.

Installer's initials

ALL TESTS MUST BE PERFORMED BY A LICENSED INSTALLER

Installer Name

Ernest S. Johnson

Date Tested

Assumed Oliver 11/01/01 uses 4' 5' anchors

Electrical

Connect electrical conductors between multi-wide units, but not to the main power source. This includes the bonding wire between multi-wide units. Pg _____

Plumbing

Connect all sewer drains to an existing sewer tap or septic tank. Pg _____

Connect all potable water supply piping to an existing water meter, water tap, or other independent water supply systems. Pg _____

Application Number: _____

Date: _____

Site Preparation

Debris and organic material removed ☒

Water drainage: Natural ☒ Swale ☐ Pad ☒ Other ☐

Fastening multi wide units

Floor:	Type Fastener:	<u>lags</u>	Length:	<u>6</u>	Spacing:	<u>20</u>
Walls:	Type Fastener:	<u>lags</u>	Length:	<u>4</u>	Spacing:	<u>10</u>
Roof:	Type Fastener:	<u>lags</u>	Length:	<u>6</u>	Spacing:	<u>20</u>

For used homes a min. 30 gauge, 8" wide, galvanized metal strip will be centered over the peak of the roof and fastened with galv. roofing nails at 2" on center on both sides of the centerline.

Gasket (weatherproofing requirement)

I understand a properly installed gasket is a requirement of all new and used homes and that condensation, mold, mildew and buckled marriage walls are a result of a poorly installed or no gasket being installed. I understand a strip of tape will not serve as a gasket.

Installer's initials

Type gasket R11
Pg _____

Installed:

Between Floors Yes ☒

Between Walls Yes ☐

Bottom of ridgebeam Yes ☒

Weatherproofing

The bottomboard will be repaired and/or taped. Yes ☒ Pg _____

Siding on units is installed to manufacturer's specifications. Yes ☒

Fireplace chimney installed so as not to allow intrusion of rain water. Yes ☒

Miscellaneous

Skirting to be installed Yes ☒ No ☐

Dryer vent installed outside of skirting Yes ☒ N/A ☐

Range downflow vent installed outside of skirting Yes ☒ N/A ☐

Drain lines supported at 4 foot intervals Yes ☒



Electrical crossovers protected Yes ☒

Other _____

Installer verifies all information given with this permit worksheet is accurate and true based on the manufacturer's installation instructions and or Rule 15C-1 & 2

Installer Signature Ernest S. Johnson Date _____

SOIL BEARING LOAD 1000LBS
 1500LBS=16"x16" ABS FOOTER
 3000LBS=17.5"x25.5" ABS FOOTER
 4000LBS=24"x24" ABS FOOTER

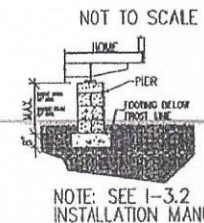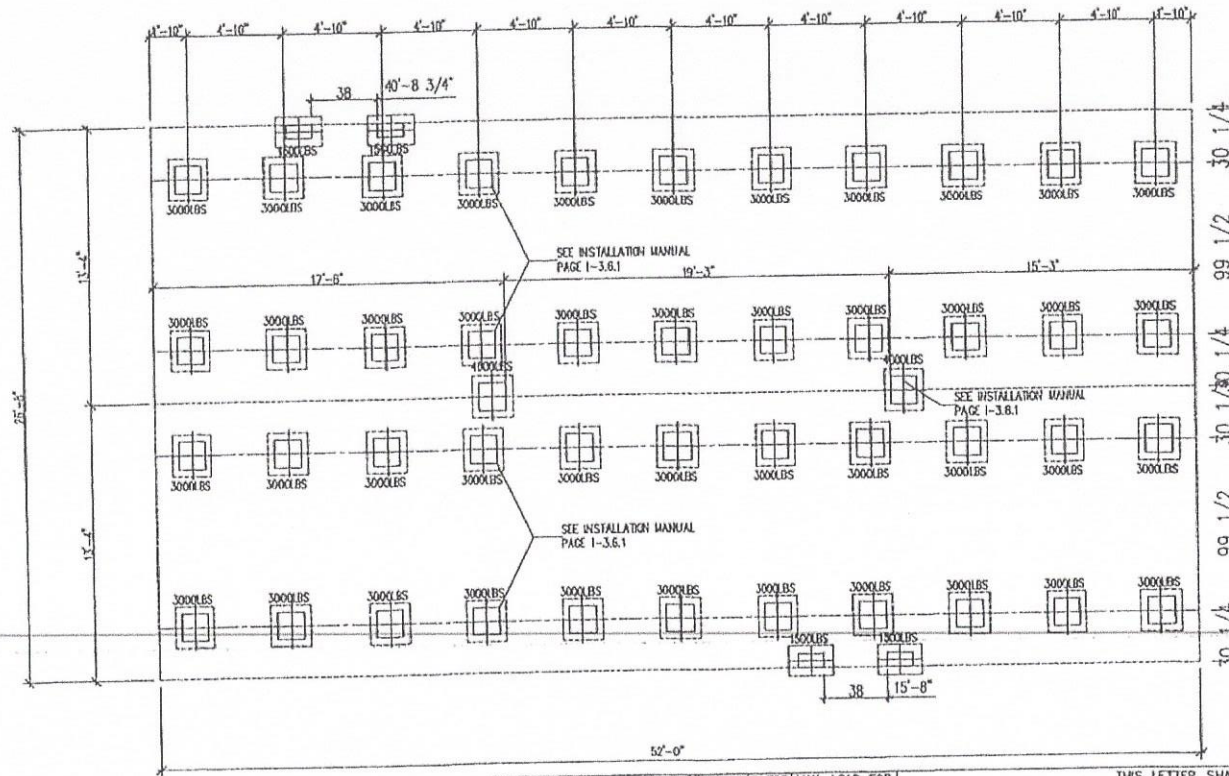

MAXIMUM SPAN BETWEEN PIERS UNDER I-BEAMS (FEET)							MAXIMUM CLEAR SPAN FOR MATING LINE SUPPORTS (FEET)							OVAL PAD SIZES		MAX. LOAD FOR 1000 PSF SOIL CAPACITY	MAX. LOAD FOR 1500 PSF SOIL CAPACITY	MAX. LOAD FOR 2000 PSF SOIL CAPACITY				
PAD SIZE	PAD AREA (SQ. FT.)	BOX WIDTH (IN.)					PAD SIZE	PAD AREA (SQ. FT.)	BOX WIDTH (IN.)					16" X 18.5"	17.5" X 25.5"	21" X 29"	23.25" X 31.25"	16" X 16"	13" X 26"	18.5" X 18.5"	20" X 20"	24" X 24"
		SINGLE WIDE	DOUBLE WIDE	SINGLE WIDE	DOUBLE WIDE	SINGLE WIDE			DOUBLE WIDE	SINGLE WIDE	DOUBLE WIDE											
16" X 18.5"	2.00	164	186	140	160	180	16" X 18.5"	2.00	N/A	N/A	11.43	10.00	8.89	23.25" X 31.25"	4,800	7,200	9,388	1,778	2,347	3,521	4,694	5,867
17.5" X 25.5"	3.00	4.95	4.45	5.66	5.06	4.58	17.5" X 25.5"	3.00	N/A	N/A	17.14	15.00	13.33					2,377	3,555	4,733	5,911	7,089
21" X 29"	4.00	6.61	5.93	7.54	6.75	6.10	21" X 29"	4.00	N/A	N/A	22.86	20.00	17.78					2,778	4,167	5,556	6,945	8,334
23.25" X 31.25"	4.80	7.93	7.12	9.05	8.09	7.32	23.25" X 31.25"	4.80	N/A	N/A	27.43	24.00	21.33					2,778	4,167	5,556	6,945	8,334
16" X 16"	1.78	2.94	2.64	3.35	3.00	2.71	16" X 16"	1.78	N/A	N/A	10.16	8.89	7.90					1,778	2,347	3,521	4,694	5,867
13" X 26"	2.35	3.88	3.48	4.42	3.96	3.58	13" X 26"	2.35	N/A	N/A	13.41	11.74	10.43					2,377	3,555	4,733	5,911	7,089
18.5" X 18.5"	2.38	3.93	3.53	4.48	4.01	3.63	18.5" X 18.5"	2.38	N/A	N/A	13.58	11.89	10.56					2,778	4,167	5,556	6,945	8,334
20" X 20"	2.78	4.59	4.12	5.24	4.68	4.24	20" X 20"	2.78	N/A	N/A	15.87	13.89	12.36					2,778	4,167	5,556	6,945	8,334
24" X 24"	4.00	6.61	5.93	7.54	6.75	6.10	24" X 24"	4.00	N/A	N/A	22.86	20.00	17.78					2,778	4,167	5,556	6,945	8,334

THIS LETTER SHALL CERTIFY THAT ABS FOUNDATION PADS MANUFACTURED BY OLIVER TECHNOLOGIES, INC. MAY BE USED IN THE LIEU OF POURED CONCRETE FOOTINGS AS A SUPPORT FOR SINGLE & DOUBLE STACKED FOUNDATION PIERS PROVIDED THE FOLLOWING CRITERIA ARE MET:

1. THE ABS PADS MUST BE INSTALLED PER OLIVER TECHNOLOGIES INSTALLATION INSTRUCTIONS.
2. THE PIER LOADS APPLIED TO THE ABS PADS MAY NOT EXCEED THE VALUES NOTED IN THE CHART BELOW.
3. THE ABS PADS MAY BE USED TO SUPPORT A CONTINUOUS FOUNDATION WALL. THE PADS MAY ONLY BE USED FOR INDIVIDUAL FOUNDATION PIERS.
4. ABS PADS MAY BE COMBINED TO COVER A LARGE AREA. IN THIS CASE THE MAX. ALLOWABLE LOADS MAYBE COMBINED AS WELL.
5. IF THE REQUIREMENTS OF DESTINY IND. INSTALLATION MANUAL CONFLICT WITH THE REQUIREMENTS OF THE OLIVER TECHNOLOGIES INSTALLATIONS, THE MORE STRINGENT REG. SHALL BE USED.

REVISIONS					


DRAWING TITLE
1000LBS ABS FOUNDATION PLAN

DRAWING FILE INFORMATION
 28'x52' 3BR~2BA


DRAWN BY:
 DONNY TRULL

PRODUCT	TIMBERLINE ELITE	MODEL NO.	290TE28523C
DATE:	9/29/2021	SO. FT.	1386
SHEET	1-C17	REVISED	-

SOIL BEARING LOAD 1000LBS
 1500LBS=16"x16" ABS FOOTER
 3000LBS=17.5"x25.5" ABS FOOTER
 4000LBS=24"x24" ABS FOOTER

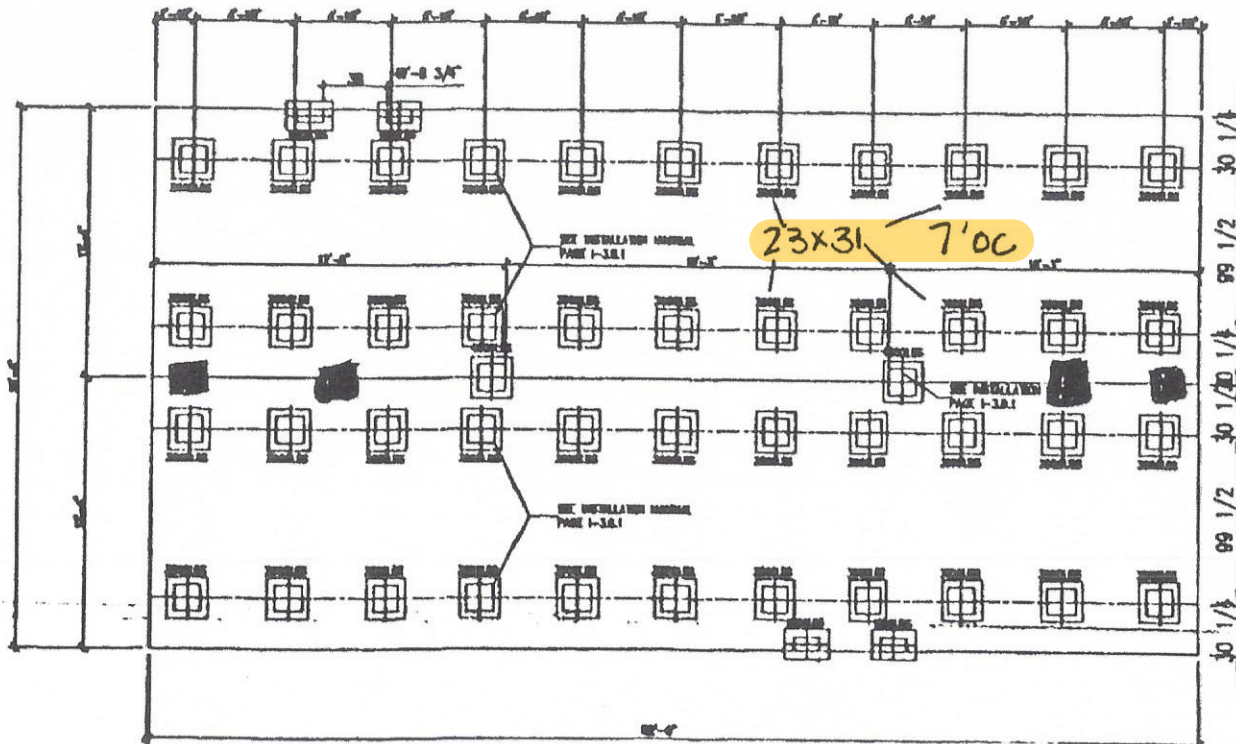


NOT TO SCALE

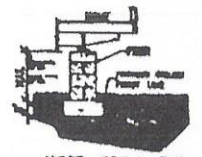

NOTE: SEE I-3.2
 INSTALLATION MANUAL

MIN SPAN BETWEEN PIERS UNDER I-BEAMS (FEET)										MAXIMUM CLEAR SPAN FOR MAINLINE SUPPORTS (FEET)										OVERLAP PAD SIZES			MAX. LOAD FOR 1000 PSF SOIL CAPACITY			MAX. LOAD FOR 1500 PSF SOIL CAPACITY			MAX. LOAD FOR 2000 PSF SOIL CAPACITY			THIS LETTER SHALL CERTIFY THAT ABS FOUNDATION PADS MANUFACTURED BY OLIVER TECHNOLOGIES, INC. MAY BE USED IN THE LULU OF Poured CONCRETE FOOTINGS AS A SUPPORT FOR SINGLE & DOUBLE STACKED FOUNDATION PIERS PROVIDED THE FOLLOWING CRITERIA ARE MET:		
SIZE	PAD AREA (SQ. FT.)	WIDTH (IN)	HEIGHT (IN)	LENGTH (IN)	THICKNESS (IN)	WEIGHT (LBS)	PAD SIZE	PAD AREA (SQ. FT.)	WIDTH (IN)	HEIGHT (IN)	LENGTH (IN)	THICKNESS (IN)	WEIGHT (LBS)	PAD SIZE	PAD AREA (SQ. FT.)	WIDTH (IN)	HEIGHT (IN)	LENGTH (IN)	THICKNESS (IN)	WEIGHT (LBS)	PAD SIZE	PAD AREA (SQ. FT.)	WIDTH (IN)	HEIGHT (IN)	LENGTH (IN)	THICKNESS (IN)	WEIGHT (LBS)	PAD SIZE	PAD AREA (SQ. FT.)	WIDTH (IN)	HEIGHT (IN)			LENGTH (IN)
24"x24"	5.76	24	4	24	4	100	16"x16"	2.56	N/A	N/A	11.5	15.0	8.0	17.5"x25.5"	4.00	N/A	N/A	17.5	25.5	15.5	24"x24"	5.76	24	4	24	4	100	16"x16"	2.56	N/A	N/A	11.5	15.0	8.0
24"x24"	5.76	24	4	24	4	100	17.5"x25.5"	4.00	N/A	N/A	17.5	25.5	15.5	24"x24"	5.76	24	4	24	4	100	16"x16"	2.56	N/A	N/A	11.5	15.0	8.0	17.5"x25.5"	4.00	N/A	N/A	17.5	25.5	15.5
24"x24"	5.76	24	4	24	4	100	24"x24"	5.76	24	4	24	4	100	24"x24"	5.76	24	4	24	4	100	16"x16"	2.56	N/A	N/A	11.5	15.0	8.0	17.5"x25.5"	4.00	N/A	N/A	17.5	25.5	15.5
24"x24"	5.76	24	4	24	4	100	24"x24"	5.76	24	4	24	4	100	24"x24"	5.76	24	4	24	4	100	16"x16"	2.56	N/A	N/A	11.5	15.0	8.0	17.5"x25.5"	4.00	N/A	N/A	17.5	25.5	15.5
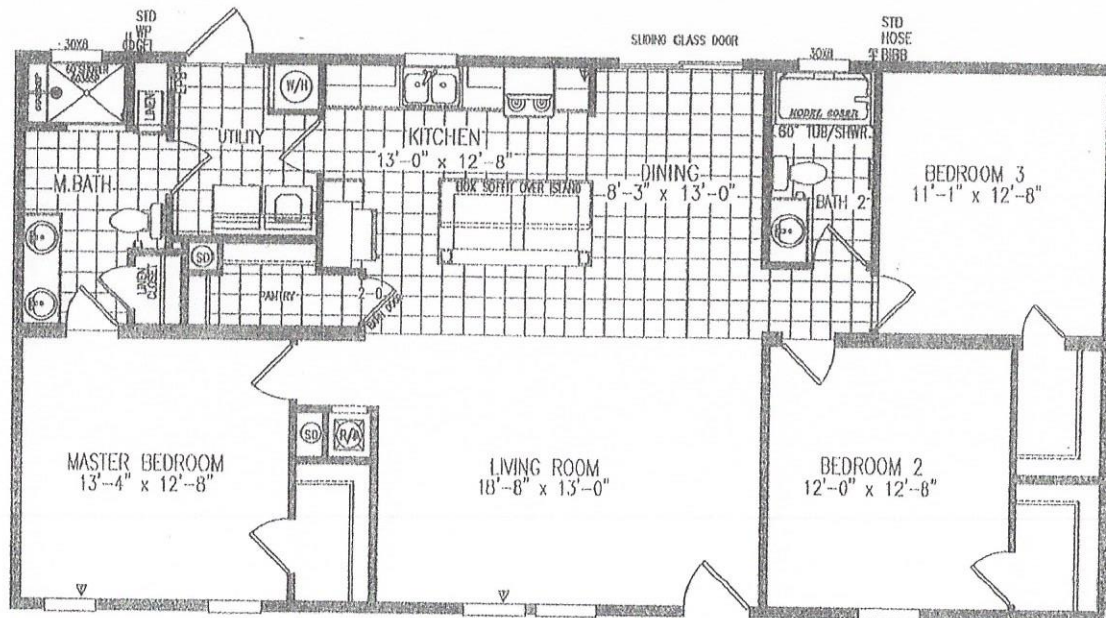

 **Destiny**
Industries, LLC
PHONE: 800-782-0000 FAX: 229-873-0020
www.destinyhomebuilders.com

MODEL 290 TE 285236 3BR ~ 2BTH
28' x 56' ~ 1386 SQ. FT.

 **Destiny**
Industries, LLC
250 R.W. BRYANT ROAD
MOLTRIE, GEORGIA 31768
PHONE: 1-866-702-6600

REVISIONS

DRAWING
TITLE

DRAWING FILE INFORMATION

28X58 3BR-2B

DRAWN BY: RYAN GOLDEN

PRODUCT	TIMBERLINE ELITE	MODEL NO.	DISH11488 D583-796-96
DATE:	07/20/2021	SQ. FT.	1458
SHEET	1-A1	REVISED	-