#### Anchor Rod Drawings 1) This drawing is for anchor rod placement only and is not foundation design. Foundation must be square and level with all anchor rods true in size, location, and projection. Projection shown must be held to keep threads clear of finished concrete. This structural design data includes magnitude and location of design loads and support conditions, material properties, and type and size of major structural members necessary to show compliance with the Order Documents at the time of this issue. Any change to building loads or dimensions may change structural member sizes and locations shown. This structural design data will be superseded and valided by any future mailing. Foundation must be square and level with all anchor rods true in size, location, 3 (5) 4 member sizes and locations shown. Inis structural design data will be superseded and voided by any future mailing. Anchor rod size is determined by shear and tension at the bottom of the base plate. The length of the anchor rod and method of load transfer to the foundation are to be determined by the foundation engineer, and are not provided by the manufacturer. 116'-0 OUT/OUT OF STEEL 14'-10 25'-0 24'-8 25'-0 25'-0 $23' - 9\frac{1}{2}$ Anchor rods are ASTM F1554 Gr. 36 material unless noted otherwise. 3000 psi concrete compressive strength (f'c) is assumed for the purpose of column base plate design unless otherwise noted. PORTAL FRAME FINISH FLOOR AT ELEVATION 100'-0 0'-104 16'-0 T/0UT OF 4'-104 $12' - 3\frac{1}{2}$ 31 $23' - 9\frac{1}{2}$ - REFERENCE LINE REFERENCE PORTAL FRAME 0 0'-11 ial AR 긭 4704 North 800–6 GE A-TON DR 32038 HERI BLD'G "A" SWC Drawn by: FEM 4/28/23 BLD'G "B" Checked by: JAQ 5/9/23 Project Engineer: MTS Job Number: 19-B-33112-1 Sheet Number: F1 of 6 The engineer whose seal appears hereon is an employee for the manufacturer for the BLD'G "A" EWE EWD materials described herein. Sa seal or certification is limited to the products designed and manufactured by manufacturer only. The undersigned engineer not the overall engineer of record for this project. SWA KEY PLAN M.W. CUSTER, P.E. This item has been electronically signed and sealed by M.W. Custer, PELORIDA Parts -00528755 e stamp show using a digital signature. Printed copies of this document are not considered signed and sealed and the signature by verified by a 3rd Party Certificate Authority on any electronic copy. considero tronic copy. LITTINIAN CUSTER CONTRACTOR CON ACCESSORY SCHEDULE MARK DESCRIPTION DETAIL QUAN. A 12'-0 X 12'-0 FRAMED OPENINGS **E** (K) 1 $\langle W \rangle \langle W \rangle$ 6'-0 X 7'-0 FRAMED OPENINGS (M) 3'-0 X 4'-0 FRAMED OPENINGS PORTAL FRAME E 12'-0 X 12'-0 FRAMED OPENINGS No. 52825 $23' - 9\frac{1}{2}$ ANCHOR BOLTS TO BE DESIGNED Aug 06, 26220 CORIDAGE BY FOUNDATION ENGINEER USING DIAMETERS SHOWN IN THIS TABLE. ANCHOR ROD SETTING PLAN ANCHOR ROD DESCRIPTION QUANTITY

DETAILS SUBJECT TO CHANGE BASED ON FINAL DESIGN. ISSUED FOR CONSTRUCTION DRAWINGS WILL REPLACE THE PERMIT DRAWINGS.


§ "ø DIAMETER X


1"Ø DIAMETER X

¾ "Ø DIAMETER X

68

52 32

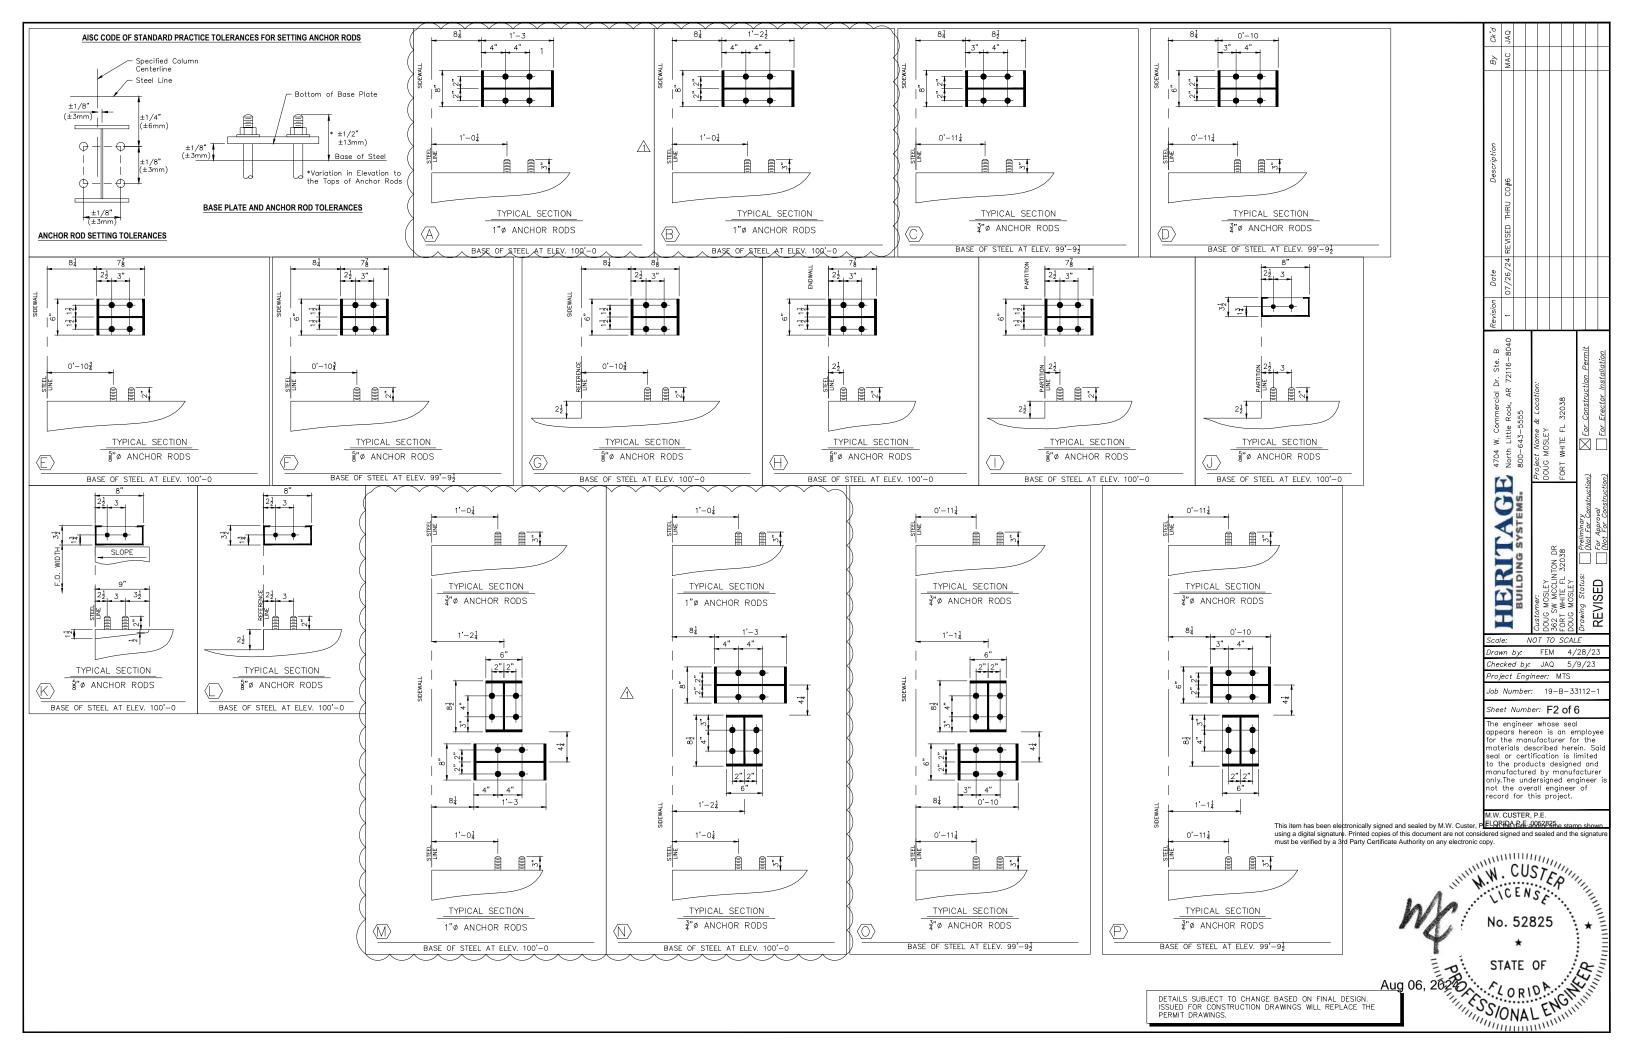

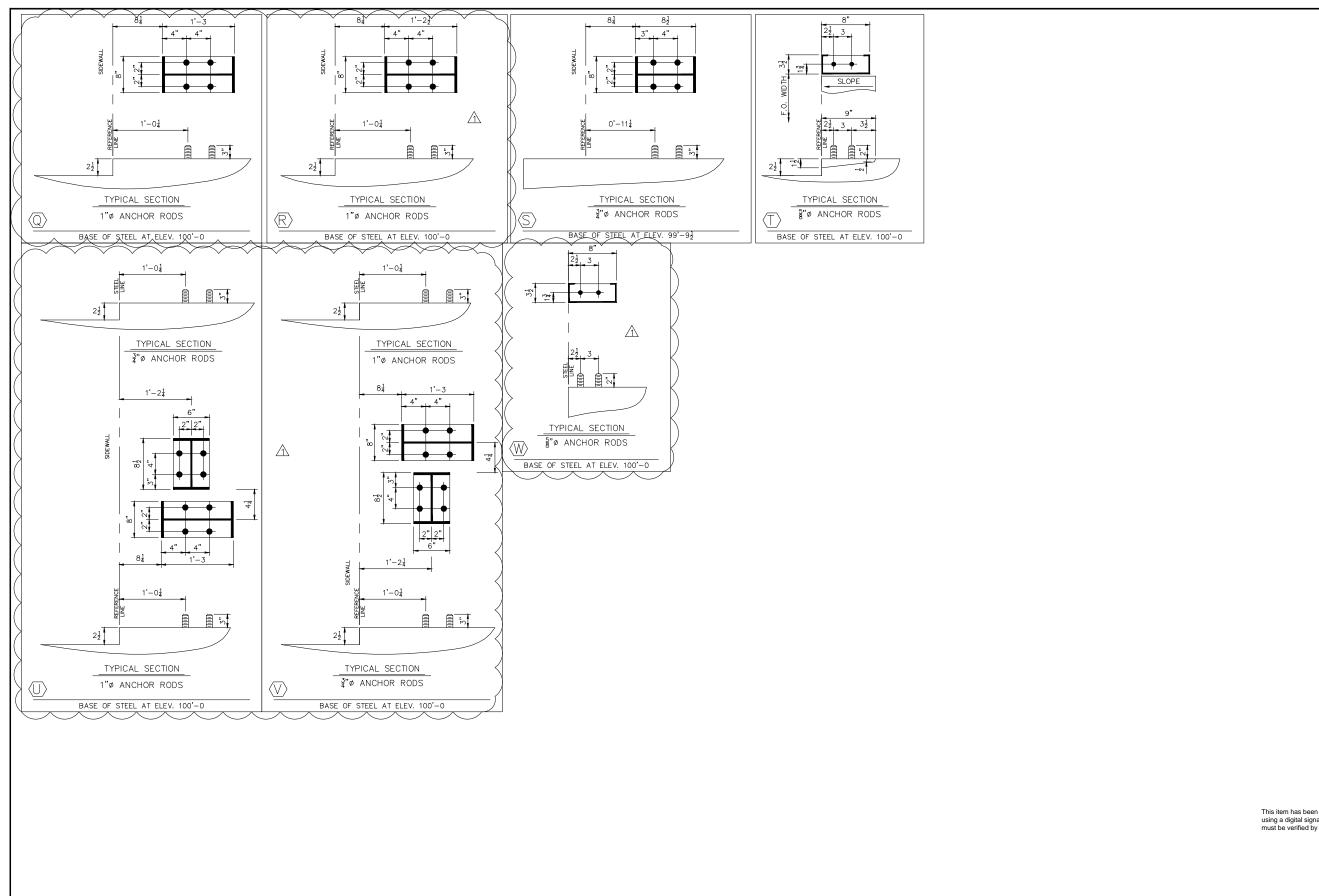

cial Dr. Ste. , AR 72116–8 4704 W. Com North Little F 800-643-55 AGE HERITA BUILDING SYS OSLEY MCCLINTON DR HITE FL 32038 OSLEY REVISED Drawn by: FEM 4/28/23 Checked by: JAQ 5/9/23 Project Engineer: MTS Job Number: 19-B-33112-1 Sheet Number: F3 of 6


The engineer whose seal appears hereon is an employee for the manufacturer for the materials described herein. Said seal or certification is limited to the products designed and manufactured by manufacturer only. The undersigned engineer is not the overall engineer of record for this project.

M.W. CUSTER, P.E.

This item has been electronically signed and sealed by M.W. Custer, P.E. GRIDANATE : 20022876 stamp shown using a digital signature. Printed copies of this document are not considered signed and sealed and the signature must be verified by a 3rd Party Certificate Authority on any electronic copy.

onic copy. No. 52825 Aug 06, 26270 CORIDAGE

DETAILS SUBJECT TO CHANGE BASED ON FINAL DESIGN. ISSUED FOR CONSTRUCTION DRAWINGS WILL REPLACE THE PERMIT DRAWINGS.

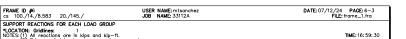

FRAME ID #5 cs 100./14./19.917 20./145. DATE: 07/12/24 PAGE: 5-3 FILE: frame\_2.fra USER NAME: mtsanchez JOB NAME: 33112A cs 100/14/19:917 20/140.

SUPPORT REACTIONS FOR EACH LOAD GROUP

\*LOCATION: Gridlines: 2

NOTES: (1) All reactions or a kips and kip-ft.

(3) Frimary wind load cases are not concurrent.

(3) Frimary wind fixed fixed

FRAME ID #4 cs 100./14./25. 20./121./0. USER NAME: mtsanchez JOB NAME: 33112A DATE: 07/12/24 PAGE: 4-3 FILE: frames 3-5, fra SUPPORT REACTIONS FOR EACH LOAD GROUP

\*LOCATIONS - GREATH LOAD GROUP

\*LOCATIONS - Gridlines: 3 4 5

NOTES: (1) All reactions or in kips and kip-ft.

(2) Primary wind load cases are not concurrent.
(3) X-bracking reactions (RBPULW and RBUPEQ) are combined withLWL and LEQ g TIME: 17: 48: 59

## REACTION NOTATIONS



LOAD GROUP REACTION TABLE GRIDLINES * = 1							
COLUMN		*-F			*-A		
LOAD GROUP	н	٧	L	н	٧	L	
DL	2.2	2.7	-0.0	-2.2	2.5	-0.0	
LL	8.8	9.8	-0.0	-8.8	8.6	-0.0	
COLL	0.4	0.5	-0.0	-0.4	0.4	-0.0	
WL1	-18.5	-25.1	-0.0	19.7	-19.2	-0.0	
WL2	-2.5	-5.0	-0.0	0.4	-0.5	-0.0	
LWL1	-15.8	-23.8	-0.0	19.9	-18.8	-0.0	
LWL2	-18.6	-20.9	-0.0	20.6	-23.3	-0.0	
LWL3	0.3	-3.6	-0.0	0.6	-0.0	-0.0	
LWL4	-2.5	-0.8	-0.0	1.3	-4.5	-0.0	
WL3	-19.0	-21.7	-0.0	21.9	-23.7	-0.0	
WL4	-2.9	-1.6	-0.0	2.5	-4.9	-0.0	

LOAD	GROUP	DESCRIPTION

Roof Dead Load
Roof Live Load
Roof Collateral Load
Wind from Left to Right with +GCpi
Wind from Left to Right with -GCpi DL LL COLL WL1 WL2 LWL1 LWL2 LWL3 LWL4 WL3 WI 4 Wind from Left to Right With -GCpi Windward Corner Left with +GCpi Windward Corner Right with +GCpi Windward Corner Left with -GCpi Windward Corner Right with -GCpi Wind from Right to Left With +GCpi Wind from Right to Left with -GCpi


### \*-A \*-F

LOAD GROUP	REACTION	N TABLE	GRIDLIN	ES * =	2			
COLUMN		*-F *-A						
LOAD GROUP	н	V	L	н	v	L		
DL	4.1	4.6	-0.0	-4.1	4.1	-0.0		
LL	21.5	22.8	-0.0	-21.6	19.9	-0.0		
COLL	1.1	1.1	-0.0	-1.1	1.0	-0.0		
WL1	-39.1	-47.2	-0.0	33.5	-36.9	-0.0		
WL2	3.7	0.5	-0.0	-4.9	5.9	-0.0		
LWL1	-35.5	-45.3	-0.0	32.8	-36.2	-0.0		
LWL2	-39.4	-41.3	-0.0	33.9	-42.4	-0.0		
LWL3	7.2	2.5	-0.0	-5.6	6.6	-0.0		
LWL4	3.4	6.4	-0.0	-4.5	0.4	-0.0		
WL3	-38.7	-42.0	-0.0	42.5	-43.6	-0.0		
WI 4	4.1	5.8	-0.0	4.1	-0.8	-0.0		

#### LOAD GROUP DESCRIPTION

REACTION NOTATIONS

Roof Dead Load Roof Live Load Roof Collateral Load Roof Colloteral Load Wind from Left to Right with +CCpi Wind from Left to Right with -CCpi Windward Corner Left with +CCpi Windward Corner Right with +CCpi Windward Corner Right with +CCpi Windward Corner Right with -CCpi Windward Corner Right with -CCpi Windward Corner Right with +CCpi Wind from Right to Left with +CCpi Wind from Right to Left with -CCpi

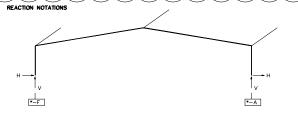

LOAD GROUP REACTION TABLE GRIDLINES * = 3 4 5							
COLUMN		*-F			*-A		
LOAD GROUP	н	v	L	н	v	L	
DL	4.9	5.4	-0.0	-4.9	4.9	-0.0	
LL	27.1	28.6	-0.0	-27.2	25.0	-0.0	
COLL	1.4	1.4	-0.0	-1.4	1.2	-0.0	
WL1	-21.7	-27.2	-0.0	18.0	-19.7	-0.0	
WL2	-9.4	-13.6	-0.0	7.0	-7.4	-0.0	
LWL1	-18.5	-25.5	-0.0	17.4	-19.1	-0.0	
LWL2	-21.9	-22.1	-0.0	18.4	-24.5	-0.0	
LWL3	-6.3	-11.9	-0.0	6.4	-6.8	-0.0	
LWL4	-9.6	-8.4	-0.0	7.3	-12.3	-0.0	
WL3	-21.3	-22.6	-0.0	25.9	-25.5	-0.0	
WL4	-9.0	-9.0	-0.0	14.9	-13.3	-0.0	

#### LOAD GROUP DESCRIPTION

SCRIPTON

Roof Dead Load

Roof Live Load

Roof Live Load

Roof Collateral Load

Wind from Left to Right with +GCpi

Windward Corner Left with +GCpi

Windward Corner Left with +GCpi

Windward Corner Right with +GCpi

Windward Corner Left with -GCpi


Windward Corner Left with -GCpi

Windward Corner Left with +GCpi

Wind from Right to Left with +GCpi

Wind from Right to Left with +GCpi

FRAME DESCRIPTION: FRAME DESCRIP	USER NAME: mjmenez JOB NAME: 33112A	DATE: 04/17/23 FILE: REW4BLDG1	PAGE: EW-2
SUPPORT REACTIONS FOR EACH LOAD GROUP		T	MF+17-13-17

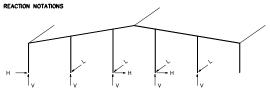

#### LOAD GROUP REACTION TABLE

COLUMN		6-A			6-B			6-C			6-D			6-E	
LOAD GROUP	н	٧	L	Н	٧	L	Н	٧	L	Н	٧	L	Н	٧	L
D	0.0	0.5	0.	0.	1.1	0.	0.	1.0	0.	0.	1.1	0.	0.	1.2	0.
С	0.0	0.1	0.	0.	0.3	0.	0.	0.2	0.	0.	0.2	0.	0.	0.3	0.
L	0.1	2.2	0.	0.	5.5	0.0	0.	5.0	0.0	0.	5.0	0.0	0.	5.5	0.0
W+	-0.1	-2.7	0.	0.	-6.3	3.7	0.	-8.2	4.4	0.	-8.2	4.4	0.	-6.3	3.7
W	-0.1	-2.7	0.	0.	-6.3	-4.1	0.	-8.2	-4.9	0.	-8.2	-4.9	0.	-6.3	-4.1
WR	-0.1	-2.7	0.	0.	-6.3	0.0	0.	-4.9	0.0	3.2	-11.6	0.0	0.	-6.3	0.0
144	~ -	0.7	^	^	0.7	~ ~		40.0	~ ~	_	7.7	~ ~	_	0.7	

#### LOAD GROUP DESCRIPTION

CRIPLION.

Dead load

Collateral load

Live load

Wind load as an inward acting pressure

Wind load as an outward acting suction
Wind force from the right

Wind force from the right

LOAD	GROUP	REACTION	TA

COLUMN	6-F					
LOAD GROUP	Н	v	L			
D	0.0	0.9	0.			
С	0.0	0.2	0.			
L	0.1	4.0	0.			
W+	-0.3	-7.0	3.4			
W-	-0.3	-7.0	-3.9			
WR	-0.3	-7.0	0.			
WL	-0.3	-7.0	0.			

PATH: R:\jobs\Active\Eng\19-B-33112\ver02-mjin

SUPPORT REACTIONS FOR EACH LOAD GROUP NOTE: All reactions are in kips and kip-ft.

REACTION NOTATIONS

#### LOAD GROUP DESCRIPTION

Dead load Collateral load

Wind load as an inward acting pressure Wind load as an outward acting suction

Wind force from the right Wind force from the left

NOTES

USER NAME: mjimenez DATE: 04/17/23 PAGE: EW-3
JOB NAME: 33112A FILE: REW4BLDG1

TIME: 17: 13: 17

1) THE REACTIONS PROVIDED ARE BASED ON THE ORDER DOCUMENTS AT 1) THE REACTIONS PROVIDED ARE BASED ON THE ORDER DOCUMENTS AT THE TIME OF MAILING, ANY CHANGES TO BUILDING LOADS OR DIMENSIONS MAY CHANGE THE REACTIONS. THE REACTIONS WILL BE SUPERSEDED AND VOIDED BY ANY FUTURE MAILING.

2) THE REACTIONS PROVIDED HAVE BEEN CREATED WITH THE FOLLOWING LAYOUT (UNLESS NOTED OTHERWISE).

3) A REACTION TABLE IS PROVIDED WITH THE REACTIONS FOR EACH LOAD GROUP.

b) RIGIGI FRAMES

(1) GABLED BUILDINGS

(2) LEFT AND RIGHT COLUMNS ARE DETERMINED AS IF WEWING THE LEFT SIDE OF THE BUILDING, AS SHOWN ON THE ANCHOR ROD DRAWING, FROM THE OUTSIDE OF THE BUILDING.

(b) INTERIOR COLUMNS ARE SPACED FROM LEFT SIDE TO RIGHT SIDE.

(2) SINGLE SLOPE BUILDINGS

(2) INTERIOR COUMING AIR SPACE IT YOU LET SIDE TO NIGHT SIDE.

(2) INCEL SLOPE BUILDINGS

(3) LEFT COLUMN IS THE LOW SIDE COLUMN.

(b) RIGHT COLUMN IS THE HIGH SIDE COLUMN.

(c) INTERIOR COLUMNS ARE SPACED FROM LOW SIDE TO HIGH SIDE.

(c) INTERIOR COLUMNS ARE SPACED FROM LOW SIDE TO HIGH SIDE.
(2) ENDWALLS
(1) LEFT AND RIGHT COLUMNS ARE DETERMINED AS IF WEWING THE
WALL FROM THE OUTSIDE.
(2) INTERIOR COLUMNS ARE SPACED FROM LEFT TO RIGHT.
A) ANCHOR ROD SIZE IS DETERMINED BY SHEAR AND TENSION AT THE
BOTTOM OF THE BASE PLATE. THE LENGTH OF THE ANCHOR ROD
AND METHOD OF LOAD TRANSFER TO THE FOUNDATION ARE TO BE
DETERMINED BY THE FOUNDATION ENGINEER.
9 ANCHOR RODS ARE ASTM F1554 GF. 36 MATERIAL UNLESS NOTED
OTHERWISE ON THE ANCHOR ROD LAYOUT DRAWING.

D) ANCHOR RODS ARE ASTM F1554 Gr. 36 MATERIAL UNLESS NOTED OTHERWISE ON THE ANCHOR ROD LAYOUT DRAWING.
 (1) X-BRACING
 (1) X-BRACING
 (1) THE ANCHOR ROD LAYOUT DRAWING.
 (1) ROD BRACING REACTIONS HAVE BEEN INCLUDED IN VALUES SHOWN IN THE REACTION TABLES.
 (2) FOR IBC AND UBG BASED BUILDING CODES, WHEN X-BRACING IS PRESENT IN THE SIDEWALL, INDIVIDUAL LONGITUDINAL SEISMIC LOADS (RBUPEQ AND RBDWCQ) DO NOT INCLUDE THE AMPLIFICATION FACTOR, Q,
 (3) FOR CANADA BUILDING CODE (NBC), WHEN X-BRACING IS PRESENT IN THE SIDEWALL OR ENDWALL, INDIVIDUAL LONGITUDINAL SEISMIC LOADS (RBUPEQ & RBDWCQ) ARE MULTIPLIED BY FORCE REDUCTION FACTOR, Rd, WHEN SPECIFIED SHORT-PERIOD SPECTRAL ACCELERATION RATIO | |F.SS(0.2) IS GREATER THAN 0.45.
 3) REACTIONS ARE PROVIDED AS UN-FACTORED FOR EACH LOAD GROUP APPLIED TO THE COLUMN. THE FOUNDATION ENGINEER WILL APPLY THE APPROPRIATE LOAD FACTORS AND COMBINE THE REACTIONS IN ACCORDANCE WITH THE BUILDING CODE AND DESIGN SPECIFICATIONS TO DETERMINE BEARING PRESSURES AND CONCRETE DESIGN. THE FACTORS SEPILED THAN THE FACTORS USED IN THE FOUNDATION DESIGN.
 (a) FOR PROJECTS USING ULTIMATE DESIGN WND SPEEDS SUCH AS 2012 IBC, 2015 IBC, 08 TACIORS USED IN THE FOUNDATION DESIGN.
 (b) FOR IBC CODES, THE SISSIMIC REACTIONS PROVIDED AND FACTOR A STRENGTH LEVEL AND DO NOT CONTAIN THE RHO FACTOR A STRENGTH LEVEL AND DO NOT CONTAIN THE RHO FACTOR.
 (c) FOR NBCC CODES, THE SISSIMIC REACTIONS PROVIDED AND A STRENGTH LEVEL AND DO NOT CONTAIN THE RHO FACTOR.
 (c) FOR NBCC CODES, THE SISSIMIC REACTIONS PROVIDED AND CONTAIN THE RHO FACTOR.
 (c) FOR NBCC CODES, THE SISSIMIC REACTIONS PROVIDED AND CONTAIN THE RHO FACTOR.
 (c) FOR NBCC CODES, THE SISSIMIC REACTIONS PROVIDED AND CONTAIN THE RHO FACTOR.
 (c) FOR NBCC CODES, THE SISSIMIC REACTIONS PROVIDED AND CONTAIN THE RHO FACTOR.
 (c) FOR NBCC CODES, THE SISSIMIC REACTIONS PRO

 $\triangle$ 

HERIT

Drawn by: FEM 4/28/23 Checked by: JAQ 5/9/23

Project Engineer: MTS

TED REACTIONS

a &

ial [

4704 North 800–6

GE

딭

TON DR 32038


Job Number: 19-B-33112-1 Sheet Number: F4 of 6

The engineer whose seal appears hereon is an employee for the manufacturer for the materials described herein. Sa

seal or certification is limited to the products designed and manufactured by manufacturer only. The undersigned engineer not the overall engineer of record for this project.

M.W. CUSTER, P.E.

This item has been electronically signed and sealed by M.W. Custer, PELORIDA Pate: 2005/97/fine stamp show using a digital signature. Printed copies of this document are not considered signed and sealed and the signatu must be verified by a 3rd Party Certificate Authority on any electronic copy.

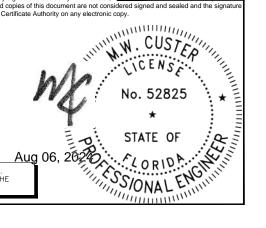


DETAILS SUBJECT TO CHANGE BASED ON FINAL DESIGN. ISSUED FOR CONSTRUCTION DRAWINGS WILL REPLACE TH PERMIT DRAWINGS.




FRAME ID #8 nf 25./14. main building at p USER NAME: mtsanchez JOB NAME: 33112A DATE: 07/12/24 PAGE: 8-2 FILE: pframe\_gridf\_bay3.fra SUPPORT REACTIONS FOR EACH LOAD GROUP ATRONEDays 3-(Gridline F)
SS(1) All reactions are in kips and kip-ft.
(2) Primary wind load cases are not concurrent.
(3) X-bracing reactions (RBPULW and RBUPEQ) are combined withLW, and LEQ groups of TIME: 17: 42: 4

•	•	•	•	•	•	•	•	•	•	•	•	•	•	•	~ \
FRAME ID #1 It 16./11.33		20./121./				NAME: 3	ntsanchez 3112A					DATE: 0	7/12/24 FILE: Itfral	PAGE: 1-1 1_1-5.fra	2
*LOCATION: C NOTES: (1) All (2) Pr (3) X-	Gridlines:	3	4 5 lps and l	dp-ft.	ent. Q) are c	ombined	withLWL a	nd LEQ	groups only	<i>ı</i> .				TIME: 17: 37	: 49

### REACTION NOTATIONS \*-LEFT \*-RIGHT

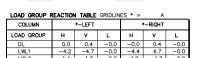


LOAD GROUP		COURTION
LUAD GROUP	DES	
DL		Roof Dead Load
LWL1	:	Wind from Left to Right with +GCpi
LWL2	:	Wind from Right to Left with -GCpi

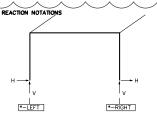

LOAD GROUP F	REACTION	N TABLE	GRIDLIN	ES * =	F	
COLUMN		*-LEFT	-RIGHT	RIGHT		
LOAD GROUP	н	V	L	Н	V	L
DL	0.0	0.5	-0.0	-0.0	0.5	-0.0
LWL1	-4.7	-5.3	-0.0	-4.9	5.3	-0.0
1.W1.2	4.0	6.7	-0.0	47	-6.3	-0.0

LOAD GROUP	DES	CRIPTION
DL	:	Roof Dead Load
LWL1	:	Wind from Left to Right with +GCpi
LWL2	:	Wind from Right to Left with -GCpi

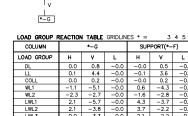


\*-F

REACTION NOTATIONS

LWL1		2.1	-5./	-0.0	4.3	-3./	-0.0
LWL2		2.1	-3.8	-0.0	3.7	-2.2	-0.0
LWL3		0.9	-3.3	-0.0	2.1	-2.2	-0.0
LWL4		0.9	-1.3	-0.0	1.5	-0.7	-0.0
WL3		1.7	-3.9	-0.0	3.2	-2.4	-0.0
WL4		0.5	-1.4	-0.0	1.1	-0.9	-0.0
LOAD GROU							
	P DES						
DL	P DES		<b>DN</b> Dead Lo	ad			
	P DES	Roof					
DL	:	Roof Roof	Dead Lo	ıd			
DL LL	:	Roof Roof Roof	Dead Lo Live Loc Collater	ıd	ght with	+GCpi	

Wind from Left to Right with +GCpi Windward Corner Left with +GCpi Windward Corner Right with +GCpi Windward Corner Left with -GCpi Windward Corner Right with -GCpi Wind from Right to Left with +GCpi Wind from Right to Left with -GCpi Wind from Right to Left with -GCpi

<b>\\\\</b>		<b>\\\\</b>

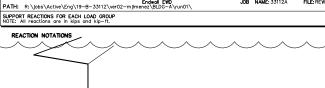

LOAD GROUP REACTION TABLE							
COLUMN	6-G						
LOAD GROUP	н	v	L				
D	0.0	0.5	0.				
С	0.0	0.1	0.				
L	-0.1	2.2	0.				
W+	0.1	-4.1	1.5				
W-	0.1	-4.1	-1.7				
WR	2.4	-4.1	0.				
WL	-2.5	-4.1	0.				

LOAD	GROUP	DESCRIPTION

Dead load Collateral load

Wind load as an inward acting pressure Wind load as an outward acting suction Wind force from the right Wind force from the left


USER NAME: mjimenez DATE: 04/17/23 PAGE: EW-4
JOB NAME: 33112A FILE: REW4BLDG2

FRAME ID #9
pf 25./11.333 leanto plane SW
SUPPORT REACTIONS FOR EACH LOAD GROUI DATE: 07/12/24 PAGE: 9-2 FILE: pframe\_gridg\_bay3.fra SACRAMONE NO. 3 — (Grédine C)

NOTES: (1) All reactions are in kips and kip—ft.

(3) Frimary wind load cases are not concurrent.

(3) Foreign resolutions (RSPULW and RBUPEQ) are combined with LML and LEQ groups only TIME: 17: 44: 49

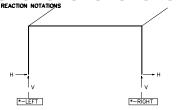

LOAD GROUP REACTION TABLE GRIDLINES * = G									
COLUMN		*-LEFT		,	-RIGHT				
LOAD GROUP	Н	٧	L	Н	٧	L			
DL	0.0	0.3	-0.0	-0.0	0.3	-0.0			
LWL1	-0.4	-0.4	-0.0	-0.4	0.4	-0.0			

#### LOAD GROUP DESCRIPTION

 $\wedge$ 

Roof Dead Load Wind from Left to Right with +GCpi Wind from Right to Left with -GCpi

NOTES

1) THE REACTIONS PROVIDED ARE BASED ON THE ORDER DOCUMENTS AT 1) THE REACTIONS PROVIDED ARE BASED ON THE ORDER DOCUMENTS AT THE TIME OF MAILING, ANY CHANGES TO BUILDING LOADS OR DIMENSIONS MAY CHANGE THE REACTIONS. THE REACTIONS WILL BE SUPERSEDED AND VOIDED BY ANY FUTURE MAILING.

2) THE REACTIONS PROVIDED HAVE BEEN CREATED WITH THE FOLLOWING LAYOUT (UNLESS NOTED OTHERWISE).

3) A REACTION TABLE IS PROVIDED WITH THE REACTIONS FOR EACH LOAD GROUP.

b) RIGIGI FRAMES

(1) GABLED BUILDINGS

(2) LEFT AND RIGHT COLUMNS ARE DETERMINED AS IF WEWING THE LEFT SIDE OF THE BUILDING, AS SHOWN ON THE ANCHOR ROD DRAWING, FROM THE OUTSIDE OF THE BUILDING.

(b) INTERIOR COLUMNS ARE SPACED FROM LEFT SIDE TO RIGHT SIDE.

(2) SINGLE SLOPE BUILDINGS

(2) INTERIOR COUMING AIR SPACE IT YOU LET SIDE TO NIGHT SIDE.

(2) INCEL SLOPE BUILDINGS

(3) LEFT COLUMN IS THE LOW SIDE COLUMN.

(b) RIGHT COLUMN IS THE HIGH SIDE COLUMN.

(c) INTERIOR COLUMNS ARE SPACED FROM LOW SIDE TO HIGH SIDE.

(c) INTERIOR COLUMNS ARE SPACED FROM LOW SIDE TO HIGH SIDE.
(2) ENDWALLS
(1) LEFT AND RIGHT COLUMNS ARE DETERMINED AS IF WEWING THE
WALL FROM THE OUTSIDE.
(2) INTERIOR COLUMNS ARE SPACED FROM LEFT TO RIGHT.
A) ANCHOR ROD SIZE IS DETERMINED BY SHEAR AND TENSION AT THE
BOTTOM OF THE BASE PLATE. THE LENGTH OF THE ANCHOR ROD
AND METHOD OF LOAD TRANSFER TO THE FOUNDATION ARE TO BE
DETERMINED BY THE FOUNDATION ENGINEER.
9 ANCHOR RODS ARE ASTM F1554 GF. 36 MATERIAL UNLESS NOTED
OTHERWISE ON THE ANCHOR ROD LAYOUT DRAWING.

Determined by The Condition Engineer.

ANCHOR RODS ARE ASTM F1534 Gr. 35 MATERIAL UNLESS NOTED OTHERWISE ON THE ANCHOR ROD LAYOUT DRAWING.

(1) X—BRACING

(1) ROD BRACING REACTIONS HAVE BEEN INCLUDED IN VALUES SHOWN IN THE REACTION TABLES.

(2) FOR IBC AND UBC BASED BUILDING CODES, WHEN X—BRACING IS PRESENT IN THE SIDEWALL, INDIVIDUAL LONGITUDINAL SEISMIC LOADS (RBUPEQ AND RBDWEQ) DO NOT INCLUDE THE AMPUFICATION FACTOR, Q.

(3) FOR CANADA BUILDING CODE (NBC), WHEN X—BRACING IS PRESENT IN THE SIDEWALL OR ENDWALL, INDIVIDUAL LONGITUDINAL SEISMIC LOADS (RBUPEQ & RBDWEQ) ARE MULTIPLIED BY FORCE REDUCTION FACTOR, Rd, WHEN SPECIFIED SHORT—PERIOD SPECTRAL ACCELERATION RATIO [167-83/40.2] IS GREATER THAN 0.45.

3) REACTIONS ARE PROVIDED AS UN-FACTORED FOR EACH LOAD GROUP APPLIED TO THE COLUMN. THE FOUNDATION ENGINEER WILL APPLY THE APPROPRIATE LOAD FACTORS AND COMBINE THE REACTIONS IN ACCORDANCE WITH THE BUILDING CODE AND DESIGN SPECIFICATIONS TO EXTERNIBLE BEARING PRESSURES AND CONCRETE DESIGN. THE FACTORS SPECIFICATIONS TO EXTERNIBLE BEARING PREACTORS USED IN THE FOUNDATION DESIGN MAY BE DIFFERENT THAN THE FACTORS USED IN THE FOUNDATION DESIGN.

(a) FOR PROJECTS USING ULTIMATE DESIGN WIND SPEEDS SUCH AS 2012 IBC, 2015 IBC, 2015 CHORD BE ALCOTIONS PROVIDED AS UNFORCED SUCH AS 2012 IBC, 2015 IBC, 2015 CHORD BE SIGN THE FOUNDATION THE REACTIONS PROVIDED AND A STRENGTH LEVEL AND DO NOT CONTAIN THE RHO FACTOR - CONTAIN THE R<sub>3</sub>-FACTOR.

FOR NEW FACTOR INSTRUMENT HE SEISMIC REACTIONS PROVIDED AND NOT CONTAIN THE RAPROPROVIDED MAY SETTED THE FOUNDATION ENGINEER TO DETERMINE THE APPLICABLE LOAD COMBINATION REACTIONS. PROVIDED MAY BE USED BY THE FOUNDATION DESIGN.


FOR NEW FACTORS HE SEISMIC REACTIONS PROVIDED AND FOUNDED AND THE FOUNDATION ENGINEER TO DETERMINE THE APPLICABLE LOAD COMBINATION FOR HIS/HER DESIGN PROCEDURES AND ALLOW FOR AN ECONOMICAL FOUNDATION DESIGN.

TED REACTIONS ial [ 딭 ĕ. <u>≒</u> 4704 North 800–6 GE TON DR 32038 HERIT Drawn by: FEM 4/28/23 Checked by: JAQ 5/9/23 Project Engineer: MTS Job Number: 19-B-33112-1 Sheet Number: F5 of 6 The engineer whose seal appears hereon is an employee for the manufacturer for the materials described herein. Sa seal or certification is limited to the products designed and manufactured by manufacturer

only. The undersigned engineer not the overall engineer of record for this project.

M.W. CUSTER, P.E.

This item has been electronically signed and sealed by M.W. Custer, PE-ORIDA Pare 2005/2875 estamp show using a digital signature. Printed copies of this document are not considered signed and sealed and the signatu must be verified by a 3rd Party Certificate Authority on any electronic copy.

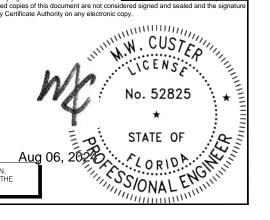

DETAILS SUBJECT TO CHANGE BASED ON FINAL DESIGN. ISSUED FOR CONSTRUCTION DRAWINGS WILL REPLACE TH PERMIT DRAWINGS.

ATH:	FRAME_DESCRIPTION: Endwall Partition 1 R: \jobs\Active\Eng\19-8-33112\ver02-mjimenz\ALDG-A\vun01\	USER NAME: mjimenez JOB NAME: 33112A	DATE: 04/11/23 FILE: REW3BLDG1	PAGE: EW-1

LOAD GROUP REACTION TABLE

COLUMN		2-E		2-D			2-C			2-B			
LOAD GROUP	Н	٧	L	Н	٧	L	Н	٧	L	Н	٧	L	
D	0.	0.2	0.	0.	0.2	0.	0.	0.2	0.	0.	0.2	0.	
W+	0.	0.	3.7	0.	0.	4.4	0.	0.	4.4	0.	0.	3.7	
W-	0.	0.	-4.1	0.	0.	-4.9	0.	0.	-4.9	0.	0.	-4.1	

#### LOAD GROUP DESCRIPTION

- Dead load Wind load as an inward acting pressure Wind load as an outward acting suction

- 1) THE REACTIONS PROVIDED ARE BASED ON THE ORDER DOCUMENTS AT THE TIME OF MAILING. ANY CHANGES TO BUILDING LOADS OR DIMENSIONS MAY CHANGE THE REACTIONS. THE REACTIONS WILL BE SUPERSEDED AND VOIDED BY ANY FUTURE MAILING.

  2) THE REACTIONS PROVIDED HAVE BEEN CREATED WITH THE FOLLOWING LAYOUT (UNLESS NOTED OTHERWISE).

  a) A REACTION TABLE IS PROVIDED WITH THE REACTIONS FOR EACH LOAD GROUP.
  b) RIGID FRAMES.

- b) RIGIO FRAMES

  (1) CABLED BUILDINGS

  (2) LEFT AND RIGHT COLUMNS ARE DETERMINED AS IF VIEWING THE LOWER THE BUILDING, AS SHOWN ON THE ANCHOR ROD DRAWING, FROM THE OUTSIDE OF THE BUILDING.
  (b) INTERIOR COLUMNS ARE SPACED FROM LEFT SIDE TO RIGHT SIDE.

  (2) SINGLE SLOPE BUILDINGS

  (a) LEFT COLUMN IS THE LOW SIDE COLUMN.
  (b) RIGHT COLUMN IS THE HIGH SIDE COLUMN.
  (c) NITERIOR COLUMNS ARE SPACED FROM LOW SIDE TO HIGH SIDE.

- (c) INTERIOR COLUMNS ARE SPACED FROM LOW SIDE TO HIGH SIDE.
  C) ENDWALLS
  (1) LEFT AND RIGHT COLUMNS ARE DETERMINED AS IF VIEWING THE
  WALL FROM THE OUTSIDE.
  (2) INTERIOR COLUMNS ARE SPACED FROM LEFT TO RIGHT.
  d) ANCHOR ROD SIZE IS DETERMINED BY SHEAR AND TENSION AT THE
  BOTTOM OF THE BASE PLATE. THE LENGTH OF THE ANCHOR ROD
  AND METHOD OF LOAD TRANSFER TO THE FOUNDATION ARE TO BE
  DETERMINED BY THE FOUNDATION ENGINEER.
  e) ANCHOR RODS ARE ASTIM FISSA Gr. 36 MATERIAL UNLESS NOTED
  OTHERWISE ON THE ANCHOR ROD LAYOUT DRAWING.
  f) X—BRACING
  (1) ROD BRACING REACTIONS HAVE BEEN INCLUDED IN VALUES SHOWN

- e) ANCHOR ROUS ARE ASIM F1554 GF. 36 MAIERIAL UNLESS NOTED OTHERWISE ON THE ANCHOR ROD LAYOUT DRAWING.

  f) X—BRACING
  (1) ROB BRACING REACTIONS HAVE BEEN INCLUDED IN VALUES SHOWN IN THE REACTION TABLES.

  (2) FOR IBC AND UBC BASED BUILDING CODES, WHEN X—BRACING IS PRESENT IN THE SIDEWALL, INDIVIDUAL LONGITUDINAL SEISMIC LOADS (RBUPEQ AND RBDWC) DO NOT INCLUDE THE AMPLIFICATION FACTOR, Q6.

  (3) FOR CANADA BUILDING CODE (NBC), WHEN X—BRACING IS PRESENT IN THE SIDEWALL OR ENDWALL, INDIVIDUAL LONGITUDINAL SEISMIC LOADS (RBUPEQ) AR BDWC) JAR MULTIPULED BY FORCE REDUCTION FACTOR, Q6. RBDWC) JAR MULTIPULED BY FORCE REDUCTION FACTOR, Q7. WHEN SPECIFIED SHORT—PERIOD SPECTRAL

  3.) REACTIONS ARE PROVIDED AS UN-FACTORED FOR EACH LOAD GROUP APPLIED TO THE COLUMN. THE FOUNDATION ENIBREE WILL APPLY THE APPROPRIATE LOAD FACTORS AND COMBINE THE REACTIONS IN CALEBRAINE WHICH A PROPERSION OF THE REACTION OF APPLIED TO LOAD GROUPS FOR THE STEEL COLUMN DESIGN MAY BE DIFFERENT THAN THE FACTORS APPLIED TO LOAD GROUPS FOR THE STEEL COLUMN DESIGN MAY BE DIFFERENT THAN THE FACTORS USED IN THE FOUNDATION DOSION MAY BE DIFFERENT THAN THE FACTORS USED IN THE FOUNDATION DOSION.

  9) FOR PROJECTS USING ULTIMATE DESIGN WIND SPEEDS SUCH AS 2012 IBC, 2015 IBC, 20

4704 W. Commercial Dr. Ste. B
HERRICAGE 4704  Customer:  Customer:  Succession of the project in poug Most Most Most Most Most Most Most Most

only. The undersigned engineer i not the overall engineer of record for this project.

M.W. CUSTER, P.E.

This item has been electronically signed and sealed by M.W. Custer, PELORIMA and Sealed by M.W. Custer using a digital signature. Printed copies of this document are not considered signed and sealed and the signatur must be verified by a 3rd Party Certificate Authority on any electronic copy.

A CONSIDENCE CORP.

CETORIC COPY.

CENSOR

CEN Aug 06, 2620 CORIDA CHE

DETAILS SUBJECT TO CHANGE BASED ON FINAL DESIGN. ISSUED FOR CONSTRUCTION DRAWINGS WILL REPLACE THE PERMIT DRAWINGS.

#### Builder/Contractor Responsibilities

<u>Drawing Validity</u> — These drawings, supporting structural calculations and design certification are based on the order documents as of the date of these drawings. These documents describe the material supplied by the manufacturer as of the date of these drawings. Any changes to the order documents after the date on these drawings may void these drawings, supporting structural calculations and design certification. The Builder/Contractor is responsible for notifying the building authority of all changes to the order documents which result in changes to the drawings, supporting structural calculations and design certification.

Builder Acceptance of Drawings — Approval of the manufacturer's drawings and design data affirms that the manufacturer has correctly interpreted and applied the requirements of the order documents and constitutes Builder/Contractor acceptance of the manufacturer's interpretations of the order documents and standard product specifications, including its design, fabrication and quality criteria standards and tolerances. (AISC COSP April 2010 Section 4.4.1)

 $\underline{\texttt{Code Official Approval}} - \texttt{It is the responsibility of the Builder/Contractor to ensure that all project}$ plans and specifications comply with the applicable requirements of any governing building authority.

The Builder/Contractor is responsible for securing all required approvals and permits from the

Building Erection — The Builder/Contractor is responsible for all erection of the steel and associated work in compliance with the Metal Building Manufacturers drawings. work in compliance with the Metal Building Manufacturers drawings. Temporary supports, such as temporary guys, braces, false work or other elements required for erection will be determined, furnished and installed by the erector (AISC COSP April 2010 Section 7.10.3).

<u>Discrepancies</u> — Where discrepancies exist between the Metal Building plans and plans for other trades, the Metal Building plans will govern. (AISC COSP April 2010 Section 3.3)

Materials by Others - All interface and compatibility of any materials not furnished by the manufacturer are the responsibility of and to be coordinated by the Builder/Contractor or A/E firm. Unless specific design criteria concerning any interface between materials if furnished as a part of the order documents, the manufacturers assumptions will govern.

 $\underline{\text{Modification of the Metal Building from Plans}} - \text{The Metal Building supplied by the manufacturer has}$ Modification of the Metal Building from Plans.— The Metal Building supplied by the manufacturer has been designed according to the Building Code and specifications and the loads shown on this drawing. Modification of the building configuration, such as removing wall panels or braces, from that shown on these plans could affect the structural integrity of the building. The Metal Building Manufacturer or a Licensed Structural Engineer should be consulted prior to making any changes to the building configuration shown on these drawings. The Metal Building Manufacturer will assume no responsibility for any loads applied to the building not indicated on these drawings.

Foundation Design
The Metal Building Manufacturer is not responsible for the design, materials and workmanship of the foundation. Anchor rod plans prepared by the manufacturer are intended to show only location, diameter and projection of the anchor rods required to attach the Metal Building System to the foundation. It is the responsibility of the end customer to ensure that adequate provisions are made for specifying rod embedment, bearing values, tie rods and or other associated items embedded in the concrete foundation, as well as foundation design for the loads imposed by the Metal Building System, other imposed loads, and the bearing capacity of the soil and other conditions of the building site. (MBMA 06 Sections 3.2.2 and A3)

Shimming - "In accordance with Section 6.10 of Chapter 4 Common Industry Practices in the Metal Building Systems Manual, shimming is a normal part of erection and is not subject to claim.

# RITAGE 4704 W. Commercial Dr. Ste. B North Little Rock AR 72116-804

BUILDING SYSTEMS.

North Little Rock, AR 72116-8040 800-643-5555

For questions or assistance Concerning Erection call or Email:

1-844-840-4603 Monday - Friday 7:30am to 5:00pm

Δ

FIELD.SERVICES@CORNERSTONE-BB.COM

#### ENGINEERING DESIGN CRITERIA

Roof Live Load .....: 20.00 psf no reduction

Wind

Ultimate Wind Speed (Vult) :: 120.00 mph
Nominal Wind Speed (Vasd) .: 92 mph (IBC section 1609.3.1)
Serviceability Wind Speed .: 76 mph
Ground Elevation Factor ...: 1.00 (0 ft ASL)
Wind Exposure Category ...: C
Exposure Coefficient (MWFRS): 0.849
Enclosure Classification ..: Enclosed Building (Bldg A)
Enclosure Classification ..: Partially Enclosed Building (Bldg B)
Internal Pressure Coef (GCpi): 0.18/-0.18 (Bldg A From FL-2 to FL-6)
...: 0.55/-0.55 (Bldg A From FL-1 to FL-2)
Wall Loads for components not provided by building manufacturer
Zone 5 Areas (within 5.60' of corner): 28.72 psf pressure -38.30 psf suction
Zone 4 Areas (away from corners)
128.72 psf pressure -31.12 psf suction
These values are the maximum values required based on a 10 sq ft area.
Components with larger areas may have lower wind loads.

#### DEFLECTION CRITERIA

The material supplied by the manufacturer has been designed with the following minimum deflection criteria. The actual deflection may be less depending on actual load and actual member length.

BUILDING DEFLECTION LIMITS .....: BLDG-A / BLDG-B

Roof Limits	Rafters	Purlins Panels	
Live: L/ Serviceability Wind: L/ Total Gravity: L/ Total Uplift: L/	180 180 120 N/A	180 60 180 60 120 60 N/A 60	
Frame Limits	Sidesway	Portal Frame Sidesway	
Live: H/ Serviceability Wind: H/ Portal Serviceability Wind: H/ Total Gravity: H/	60 60 N/A 60	60	
Wall Limits	Limit		
Total Wind Panels: L/ Total Wind Girts: L/ Total Wind EW Columns: L/	60 90 120		

#### PROJECT NOTES

Material properties of steel bar, plate, and sheet used in the fabrication of built-up structural framing members conform to ASTM A529, ASTM A572, or ASTM A1011 with 55 ksi min. yield, except flanges wider than 12° and thicker than 3/8°, are 50 ksi min. yield. Rod X-bracing conforms to ASTM A529 or ASTM A572 with 50 ksi min. yield. Rod X-bracing conforms to ASTM A959 or ASTM A572 with 50 ksi min. yield. Cable X-bracing conforms to ASTM A475 7 Strand Extra High-Strength grade. Hot rolled structural shapes conform to ASTM A992, ASTM A529, or ASTM A572 with 50 ksi min. yield. Hot rolled angles, other than flange braces, conform to ASTM A36 minimum. Round and rectangular HSS conforms to ASTM A500 Grade B. Cold-formed steel secondary framing Members conform to ASTM A1011 or ASTM A653 Grade 55 with 55 ksi min. yield. For Canada, material properties conform to CAN/CSA G40.20/G40.21 or equivalent.

Unless otherwise noted, special inspection of fabricated items is not required. Per IBC section 1704, 2.5.1, fabricator is approved to perform such work without special inspection through maintenance of IAS AC 472 certification MB-136.

All bolted joints with A325 Type 1 bolts are specified as snug-tightened joints in accordance with the most recent edition of the RCSC Specification for Structural Joints Using ASTM A325 or A490 Bolts. Pre-tensioning methods, including turn-of-nut, calibrated wrench, twist-off-type tension-control bolts or direct-tension-indicator are NOT required. Installation inspection requirements for Snug Tight Bolts (Specification for Structural Joints Section 9.1) is suggested.

Design criteria as noted is as given within order documents and is applied in general accordance with the applicable provisions of the model code and/or specification indicated. Neither the metal building manufacturer nor the certifying engineer declares or attests that the loads as designated are proper for local provisions that may apply or for site specific parameters. The design criteria is supplied by the builder, project owner, or an Architect and/or Engineer of Record for the overall construction project.

Building A is designed as an Enclosed Building. Exterior and/or operable components including, but not limited to, doors, windows, vents, etc. ('Components') must be designed to withstand the required component and cladding wind pressures specified by the building code. In order to maintain the metal building system's Enclosed Building condition, all Components shall be closed when wind velocities reach half the designed wind load for the metal building system as shown on the drawings and design criteria documentation. Failure to maintain the metal building system's Enclosed Building condition will violate and void all warranties and certifications applicable to the material supplied by the metal building manufacturer.

The framing at building A, gridline 1 and building B, gridline 1 is NOT designed to receive a future bay addition. Corresponding frame reactions are calculated based upon actual tributary area.

Framed openings, walk doors, and open areas shall be located in the bay and elevation as shown in the erection drawings. The cutting or removal of girts shown on the erection drawings due to the addition of framed openings, walk doors, or open areas not shown may void the design certifications supplied by the metal building manufacturer.

Roof and wall panels have been designed in accordance with section 2222.4 of the Florida Building Code, 7th Edition. Product approval numbers for the State of Florida, Department of Community Affairs per Product Rule 9B-72:

1. Panel Walls
Fli1917 PBR 26 gauge walls
2. Roofing Products
Fli1819 PBR 26 gauge roofs
3. Walk doors.

3. Walk doors FL17900.1 Telstar 3070, Wind-rated to +/- 50 psf, Impact-rate

# Plans Columbia pariment Reviewed for Code Compliance !

	Drawing index	ð	JAQ				
Page	Description	$\vdash$	->				
		By	MAC				
F1	Anchor Rod	È	Σ				
F2	Anchor Rod Details	1					
F3-F5	Reaction Drawings						
E1	Cover Sheet	ł					
E2	Primary Steel BLDGA	1					
E3	Roof Framing BLDGA	ا ۾					
E4	Roof Sheeting	b tic					
E5	Sidewall BLDGA WALLSWA	Description					
E6	Sidewall BLDGA WALLSWC BLDGB WALLSWC	De	9#00				
E7	Endwall BLDG A&B WALLEWB	1	⊋				
E8	Endwall BLDGA&B WALLEWD	1	THRU				
E9	Partition BLDGA WALLPL1	1	e				
E10-E15	Main Frame Cross Sections	1	ATED				
E16	Portal Frame Cross Section 13 FRAMELINEA—SWA		4 UPD,				
E17	Portal Frame Cross Section 13 FRAMELINEB—SWC	Date	30/24				
E18	Portal Frame Cross Section 23 FRAMELINEA—SWC	0	07/2				
		20					

Drawing Index

ERITAGE	ERITAGE 4704 W. Commercial Dr. Ste. B North Little Rock, AR 72116–8040 800–643–5555
er:	Project Name & Location:
IOSLEY	DOUG MOSLEY
MCCLINTON DR	
HITE FL 32038	FORT WHITE FL 32038
IOSLEY	
Status: Preliminary	Sectional Posts in

σ, σ,

HERI Drawn by: FEM 4/28/23


Checked by: JAQ 5/10/23 Project Engineer: MTS Job Number: 19-B-33112-1

Sheet Number: E1 of 18

The engineer whose seal appears hereon is an employe for the manufacturer for the materials described herein. Sa seal or certification is limited to the products designed and manufactured by manufacture only.The undersigned engineer not the overall engineer record for this project.

M.W. CUSTER, P.E.

This item has been electronically signed and sealed by M.W. Custer, PE-ORIDA Pare 2005/2875 estamp show using a digital signature. Printed copies of this document are not considered signed and sealed and the signatu must be verified by a 3rd Party Certificate Authority on any electronic copy.

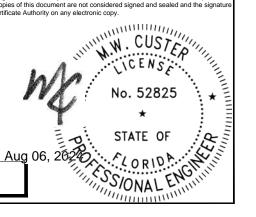

DETAILS SUBJECT TO CHANGE BASED ON FINAL DESIGN ISSUED FOR CONSTRUCTION DRAWINGS WILL REPLACE PERMIT DRAWINGS.




Download panel installation manuals from:


www.CBBmanuals.com

Descargue los manuales de instalación del panel desde: www.CBBmanuals.com

### BUILDING DESCRIPTIONS Building ID Width Length Height Slope Building A 100'-0 116'-0 14'-0 2:12 Building B 16'-0 116'-0 11'-4 2:12

	½"ø A325 BOL1	GRIP TABLE (UNLESS N	OTED)
GRIP	LENGTH	BOLT LENGTH	NOTE: FULL THREAD
0 TO 9/16"	1 1/4" F.T.		ENGAGEMENT IS DEEMED TO HAVE BEEN MET WHEN THE
Over 9/16" TO 1 1/16"	1 3/4" F.T.		END OF THE BOLT IS FLUSH
Over 1 1/16" TO 1 5/16"	2"		WITH THE FACE OF THE NUT.
Over 1 5/16" TO 1 9/16"	2 1/4"		
Over 1 9/16" TO 1 13/16"	2 1/2"		REQUIRED ONLY WHEN SPECIFIED.
Over 1 13/16" TO 2 1/16"	2 3/4"		MAY BE LOCATED UNDER HEAD UNDER NUT, OR AT BOTH AT
LOCATIONS OF BOLTS LONGE NOTED ON ERECTION DRAWIN		LOCATION ADD 5/3	NS NOTED ON ERECTION DRAWINGS. 32" FOR EACH WASHER TO
F.T. DENOTES FULLY THREAD	ED	MATERIA	L THICKNESS TO DETERMINE GRIP.

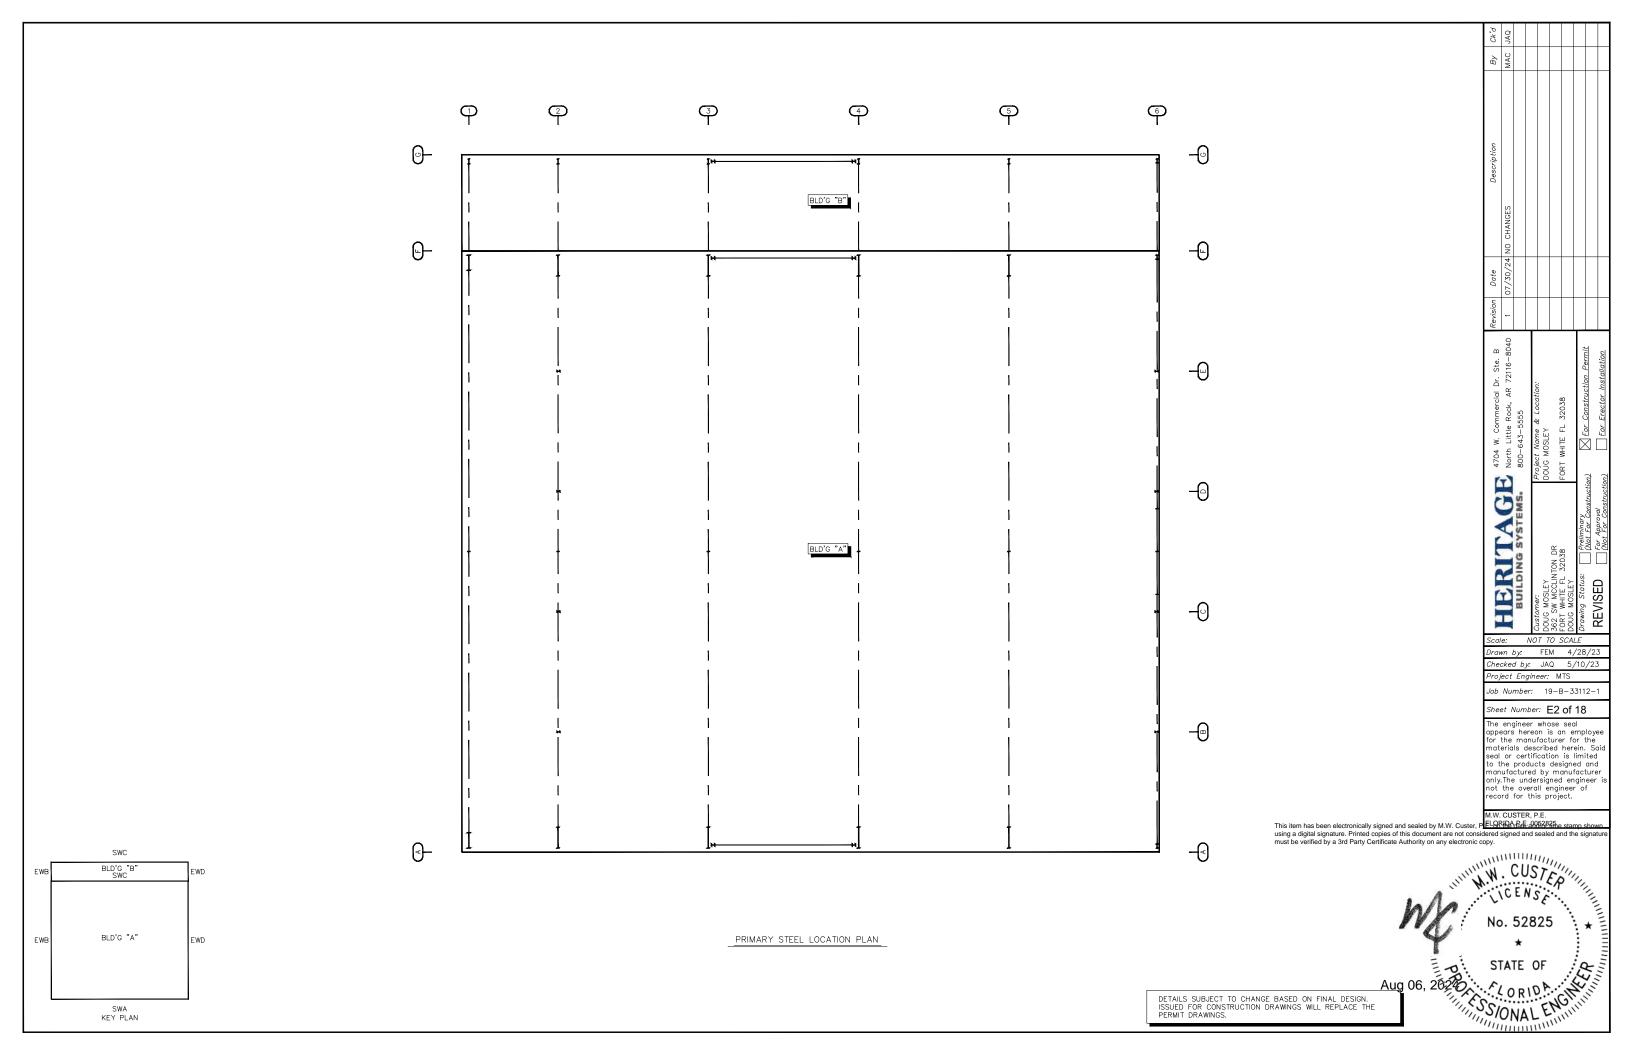

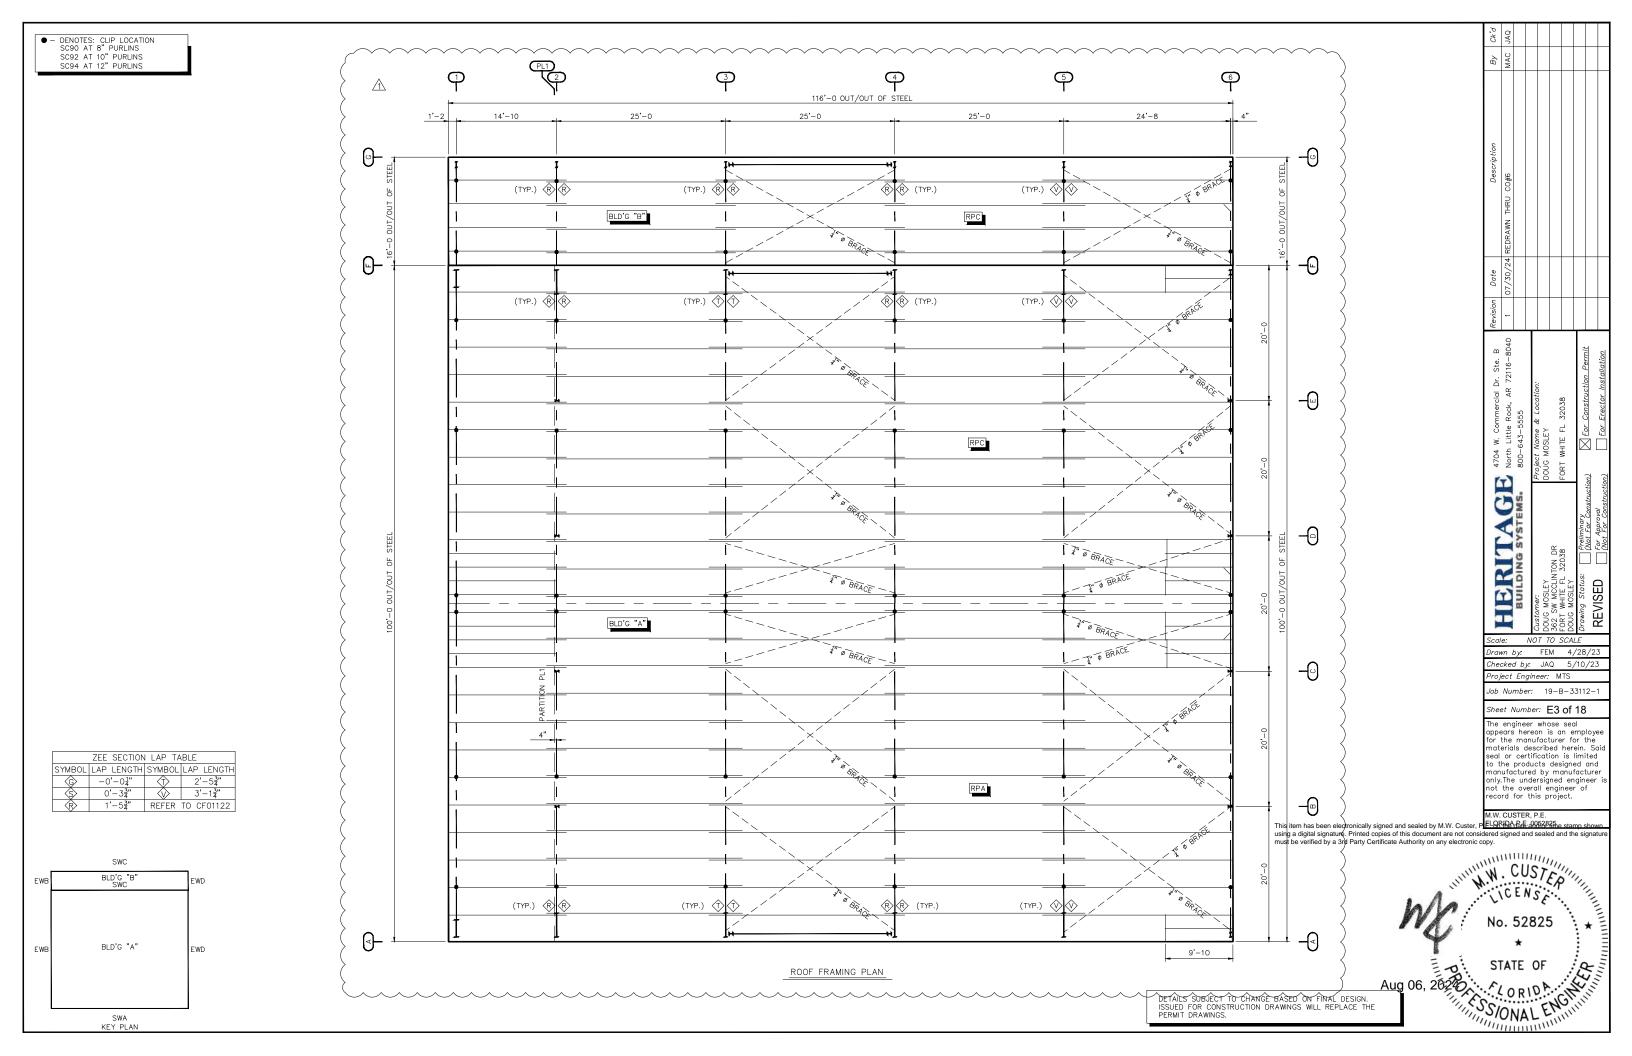

PBR ROOF PANELS ARE TO BE FIELD CUT IF THE PANELS EXTEND OUTSIDE OF THE ROOF PLANE, PANELS ARE NOT TO BE BACK LAPPED. Non-Standard PBR Roof Panel Fasteners ROOF SHEETING PLANE 2
PANEL TYPE = PBR (CHARCOAL GRAY)
PANEL OVERHANG = 516 #58 member fasteners are to be used for panel to secondary attachment in lieu of #3 shown on the R Drawings  $\triangle$ FROM OUTER STEEL 1'-0 BEYOND REDRAWN 41 Commercial Dr. St tle Rock, AR 7211 -5555 4704 W. Comi North Little R 800-643-555 ct Name & : MOSLEY WHITE FL HERITAGE BUILDING SYSTEMS. S MOSLEY SW MCCLINTON DR WHITE FL 32038 MOSLEY Drawn by: FEM 4/28/23 Checked by: JAQ 5/10/23 Project Engineer: MTS Job Number: 19-B-33112-1 Sheet Number: E4 of 18 The engineer whose seal appears hereon is an employee for the manufacturer for the materials described herein. Said seal or certification is limited to the products designed and manufactured by manufacturer only. The undersigned engineer is not the overall engineer of record for this project. M.W. CUSTER, P.E. This item has been electronically signed and sealed by M.W. Custer, PE-ORINA-ALE-ANDERSHEE stamp shown using a digital signature. Printed copies of this document are not considered signed and sealed and the signatur must be verified by a 3rd Party Certificate Authority on any electronic copy. SWC BLD'G "B" SWC BLD'G "A" EWB Aug 06, 2620 CORIDA CHANGE EWD ROOF SHEETING PLAN ROOF SHEETING PLANE 1 PANEL TYPE = PBR (CHARCOAL GRAY)
PANEL OVERHANG = 516 FROM OUTER STEEL DETAILS SUBJECT TO CHANGE BASED ON FINAL DESIGN. ISSUED FOR CONSTRUCTION DRAWINGS WILL REPLACE THE PERMIT DRAWINGS. SWA KEY PLAN


#### Non-Standard PBR Wall Panel Fasteners

#58 member fasteners are to be used for panel to secondary attachment in lieu of #17A shown on the R Drawings

#4 lap fasteners are to be used for panel to panel and panel to trim attachment in lieu of #4A shown on the R Drawings

	SCHEDULE OF ACCESSORIES											
NO. REQD	DESCRIPTION											
1	6'-0 X 7'-0 FIELD LOCATED FRAMED OPENING											
2	5'-0 X 3'-0 FACTORY LOCATED FRAMED OPENINGS											
2	12'-0 X 12'-0 FACTORY LOCATED FRAMED OPENINGS											
2	3'-0 X 4'-0 FIELD LOCATED FRAMED OPENINGS											
2	3070 KNOCK-DOWN WALK DOORS											

REFER TO DETAILS ON INSTALLATION OF WALK DOORS.
REFER TO DETAILS ON INSTALLATION OF FRAMED OPENINGS.
USE STANDARD WALL PROCEDURES TO ERECT THE SIDEWALL AND ENDWALL PANELS.

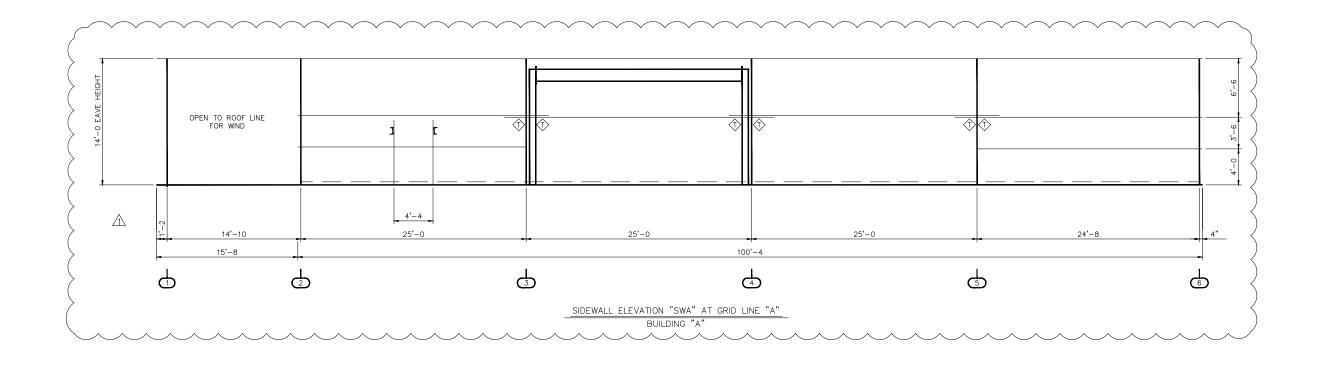

PBR WALL PANELS
PANEL COVERAGE = 3'-0
COLOR = ASH GRAY
PANEL PKG. REQ'D. = PBS-2
Field Cut Panel and Trim as
required per Construction Details

OPEN TO ROOF LINE FOR WIND	13'-11 <u>3</u>	13'-11½	13'-11½	13'-112	13'-112	13'-112	13'-11½	13'-112	13'-11½	13'-11 <u>‡</u>	13'-11½	13,-11,	13'-11½	13'-11½	13'-11½	13'-11½	13'-11½	13'-11½	13'-11½	13'-11½	13'-11½	13'-11½	13'-112	13'-11½	13'-112	13'-11½	13'-11½	13'-112	13'-11½	13'-11½	13'-11 <u>*</u>	13'-11½	13'-11 <u>3</u> 13'-11 <u>3</u>		
15'-8																																		4"	
																																	2'-0	BACKLAP	

EWB BLD'G "A" EWD

SWA KEY PLAN

SWC

	ZEE SECTION	I LAP IA	BLE
SYMBOL	LAP LENGTH	SYMBOL	LAP LENGTH
<b>\$</b>	-0'-0 <del>1</del> "	$\Diamond$	2'-5 <del>3</del> "
\$	0'-3 <mark>3</mark> "	$\Diamond$	3'-1 <del>3</del> "
₿	1'-5 <del>3</del> "	REFER	TO CF01122

WALL SHEETING ELEVATION "SWA"
BLDG "A"

ies of this document are not constituted.

CUST

CENS

No. 52825

STATE OF

Aug 06, 26280

No. 52825


DETAILS SUBJECT TO CHANGE BASED ON FINAL DESIGN. ISSUED FOR CONSTRUCTION DRAWINGS WILL REPLACE THE PERMIT DRAWINGS.


	07/30/24 REDRAWN TH								
Date	07/30/24								
Revision Date									
4704 W. Commercial Dr. Ste. B	いつい	800-643-5555	Project Name & Location.			58 FORT WHITE FL 32038	ninary	(Not For Construction) $\times$ For Construction Permit	[ For Approval (Not For Construction)
-		N c. by:	Customer.	DOUG MOSLEY	362 SW MCCLINTON I	FORT WHITE FL 3203	Drawing Status:		KEVISED
Scale	e:	Λ	0	T T	0.	SC/	LE	2 /0	7
Chec	n by ked	by:	_	JA	vi Q	5	/20 /10	)/2	.J 3
Chec Proje	ect E	ngi	ne	er:	N	ITS	, . `	, -	
	Num	ber.		19	9-6	3-:	331	12-	-1
Shee	t N	ımb	er			of			
Shee The	engir			who	se	se		_	
The appe for t mate	ars he r erials	neer here nan de	eo u1	n i fact	s c ure	in i er f hei	emp or rein	oloy the	ee aid

materials described herein. Said seal or certification is limited to the products designed and manufactured by manufacturer only. The undersigned engineer is not the overall engineer of record for this project.

M.W. CUSTER, P.E.

This item has been electronically signed and sealed by M.W. Custer, PELORIDA Late AMSASSIFIE stamp shown using a digital signature. Printed copies of this document are not considered signed and sealed and the signatur must be verified by a 3rd Party Certificate Authority on any electronic copy.

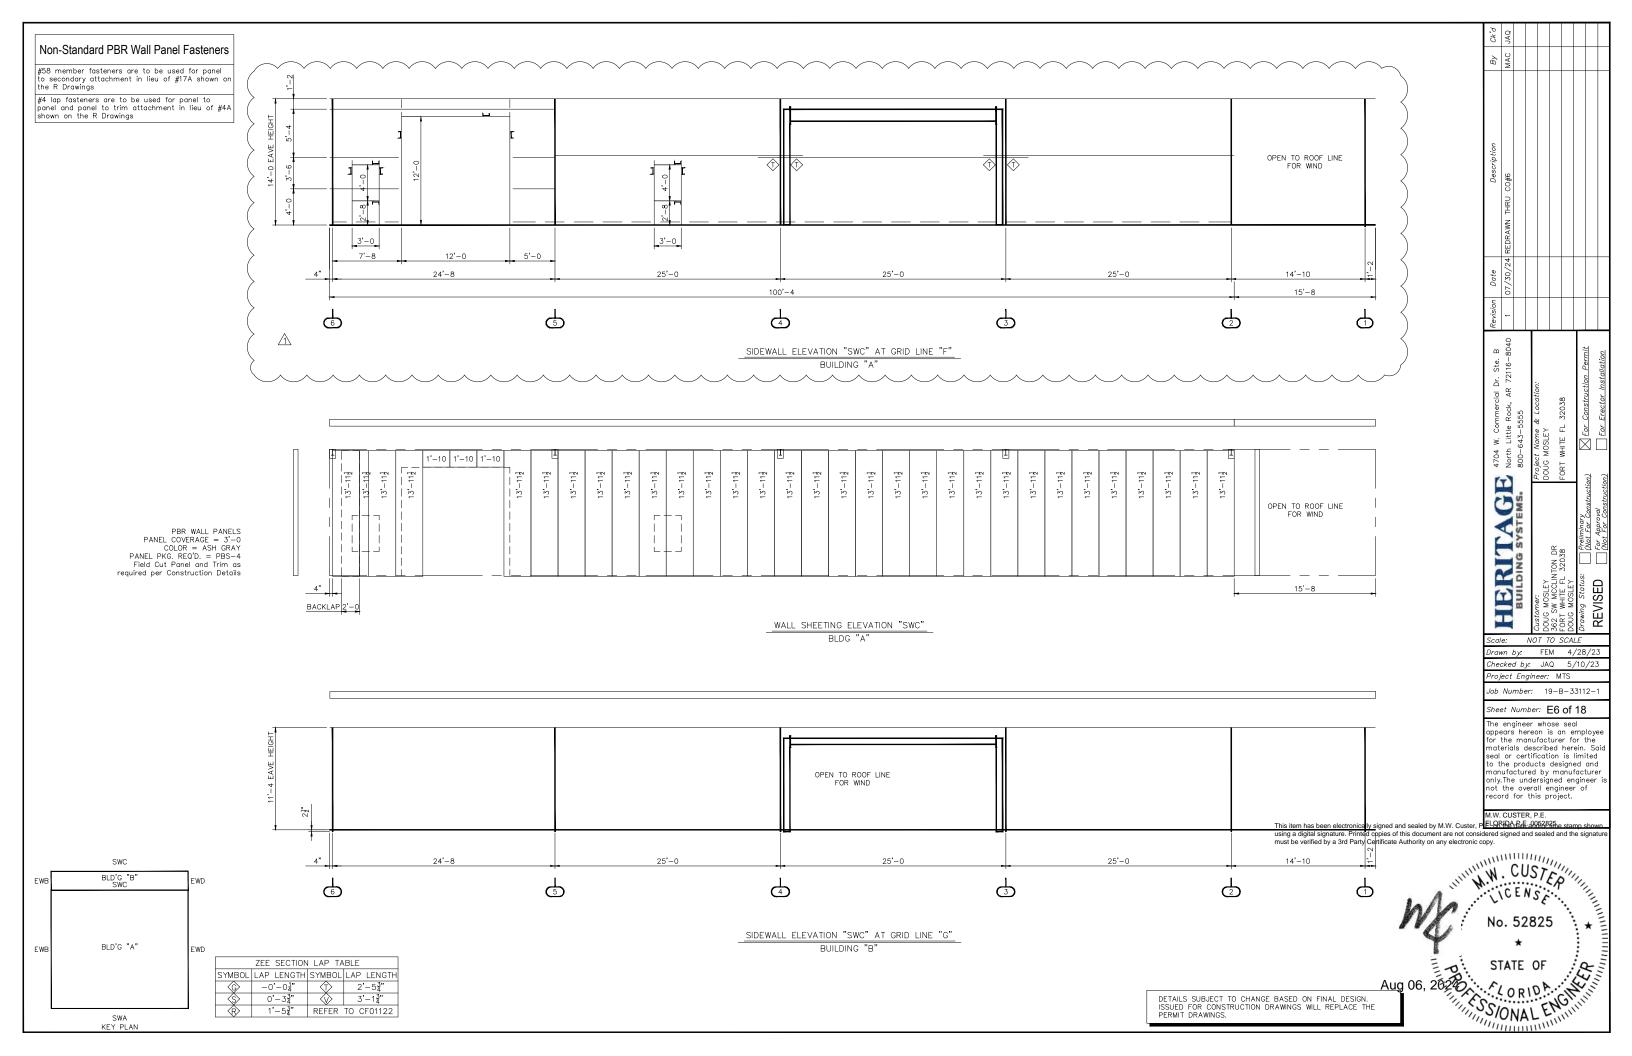

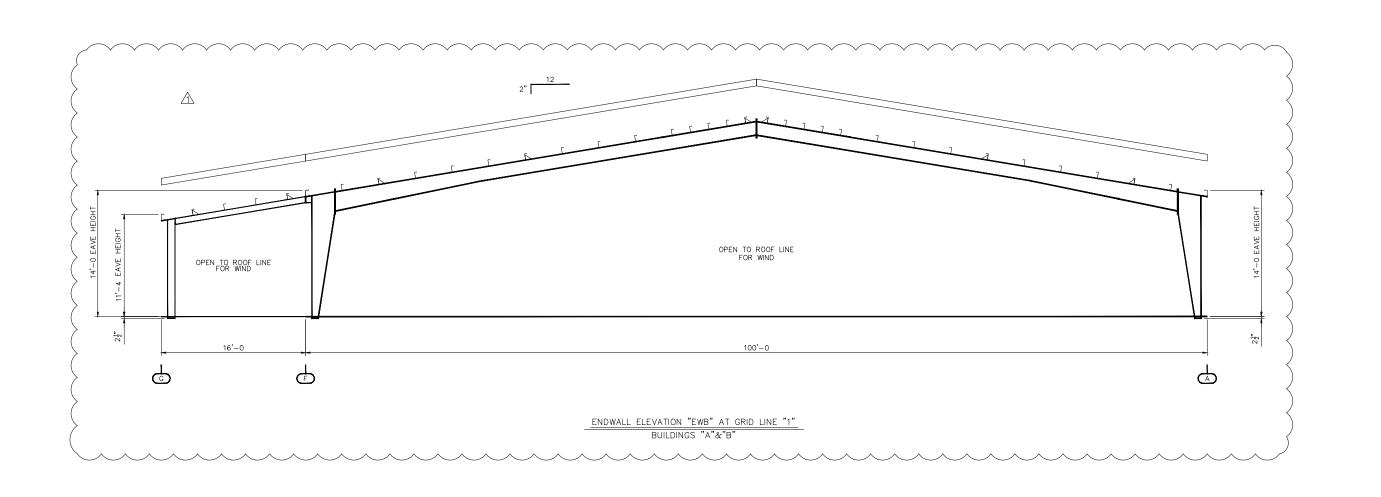

/24 REDRAWN THRU 4704 W. Commercial Dr. Ste. B North Little Rock, AR 72116-8040 800-643-5555 HERITAGE BUILDING SYSTEMS. DOUG MOSLEY 362 SW MCCLINTON DR FORT WHITE FL 32038 DOUG MOSLEY Drawn by: FEM 4/28/23 Checked by: JAQ 5/10/23 Project Engineer: MTS Job Number: 19-B-33112-1 Sheet Number: E7 of 18

The engineer whose seal appears hereon is an employee for the manufacturer for the materials described herein. Said seal or certification is limited to the products designed and manufactured by manufacturer only. The undersigned engineer is not the overall engineer of record for this project.


M.W. CUSTER, P.E.

This item has been electronically signed and sealed by M.W. Custer, P.E. GRIDANATE 200228 he stamp shown using a digital signature. Printed copies of this document are not considered signed and sealed and the signature must be verified by a 3rd Party Certificate Authority on any electronic copy.


SWC BLD'G "B" SWC BLD'G "A" EWB EWD SWA KEY PLAN

DETAILS SUBJECT TO CHANGE BASED ON FINAL DESIGN. ISSUED FOR CONSTRUCTION DRAWINGS WILL REPLACE THE PERMIT DRAWINGS.

CONSIDERED STORY OF THE STORY O Aug 06, 2020 STATE STORIDA CHE

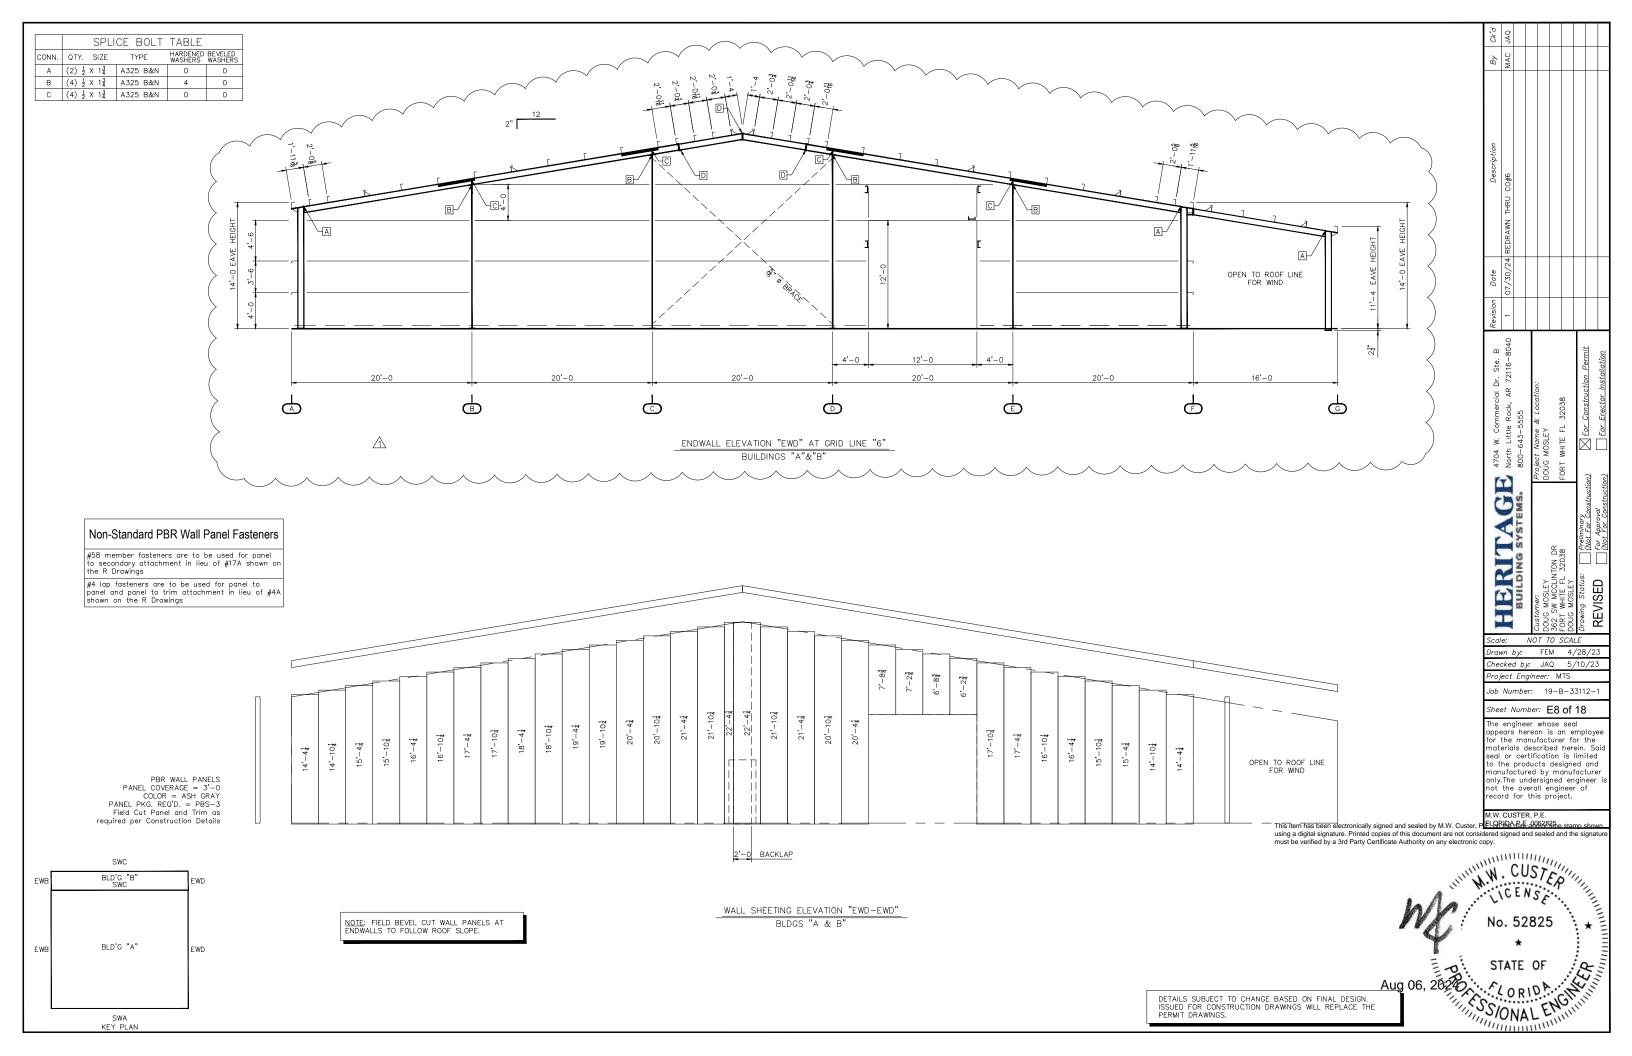



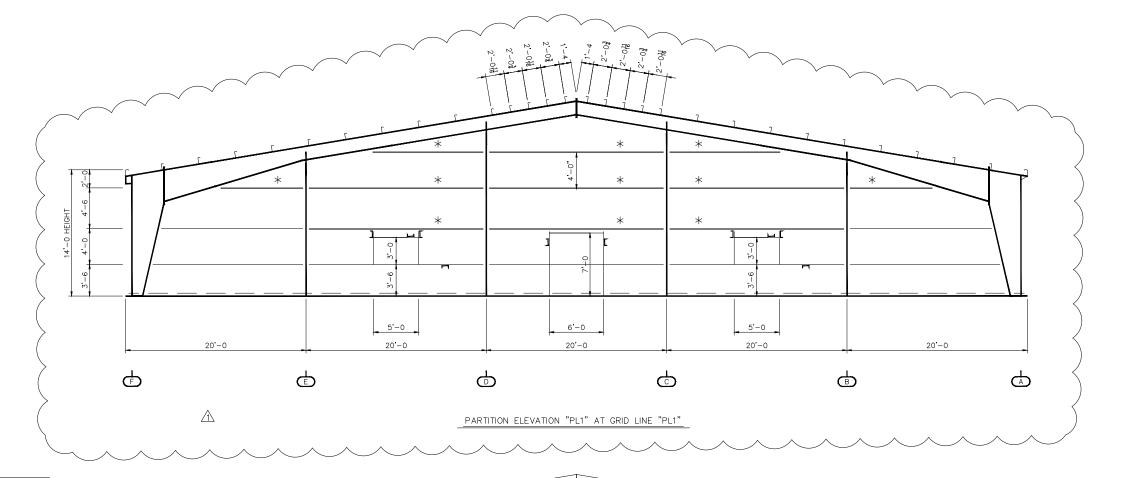

#### Non-Standard PBR Wall Panel Fasteners

#58 member fasteners are to be used for panel to secondary attachment in lieu of #17A shown on the R Drawings

#4 lap fasteners are to be used for panel to panel and panel to trim attachment in lieu of #4A shown on the R Drawings

PBR WALL PANELS
PANEL COVERAGE = 3'-0
TOP COLOR = ASH GRAY
BOTTOM COLOR = CHARCOAL GRAY
PANEL PKG. REQ'D. = PBS-1
Field Cut Panel and Trim as
required per Construction Details

																	<del></del>			<b>-</b>													
, j	22	11'-8\}	12'-24	12'-83	13'-2\$	13,-84	14'-23	14,-83	15'-24	15'-83	16'-2	16'–83	17, – 23	17'-8	18'-23	18′-64		18'-24	17'-8\$	17, – 23	16'–8¾	16'-2\$	15,-8}	15'-23	14,-83	14,-2\$	13'-84	13'-2\$	12'-8\$	12,-23	11,-83	11,-23	10'-83
	3-7	3,-7	3'-7	3'-7	3'-7	3'-7	3'-7	3'-7	3,-7	3'-7	3,-7	3'-7	3'-7	3,-7	3'-7	jo i	3'-7	L'E BACKLA	3,-7	3'-7	3'-7	3'-7	3,-7	3'-7	3'-7	3'-7	3'-7	3'-7	3'-7	3'-7	3'-7	3'-7	3,-7

WALL SHEETING ELEVATION "PL1"

NOTE: FIELD BEVEL CUT WALL PANELS AT ENDWALLS TO FOLLOW ROOF SLOPE.

| Project Number: | Project Nu

M.W. CUSTER, P.E.

nsidered sign...

nic copy.

CUSTEP

This item has been electronically signed and sealed by M.W. Custer, PELORIDA LE 2003 28 has stamp shown using a digital signature. Printed copies of this document are not considered signed and sealed and the signatur must be verified by a 3rd Party Certificate Authority on any electronic copy.

REDRAWN

DETAILS SUBJECT TO CHANGE BASED ON FINAL DESIGN.
ISSUED FOR CONSTRUCTION DRAWINGS WILL REPLACE THE PERMIT DRAWINGS.

