

Mobile Home Permit Worksheet

Application Number: _____

Date: _____

POCKET PENETROMETER TEST

The pocket penetrometer tests are rounded down to _____ psf or check here to declare 1000 lb. soil X without testing.

X 1000 X 1000 X 1000

POCKET PENETROMETER TESTING METHOD

1. Test the perimeter of the home at 6 locations.
2. Take the reading at the depth of the footer.
3. Using 500 lb. increments, take the lowest reading and round down to that increment.

X 1000 X 1000 X 1000

TORQUE PROBE TEST

The results of the torque probe test is _____ inch pounds or check here if you are declaring 5' anchors without testing _____ A test showing 275 inch pounds or less will require 5 foot anchors.

Note: A state approved lateral arm system is being used and 4 ft. anchors are allowed at the sidewall locations. I understand 5 ft anchors are required at all centerline tie points where the torque test reading is 275 or less and where the mobile home manufacturer may require anchors with 4000 lb holding capacity.

WHP Installer's initials

ALL TESTS MUST BE PERFORMED BY A LICENSED INSTALLER

Installer Name

William Price

Date Tested

6/14/25

Electrical

Connect electrical conductors between multi-wide units, but not to the main power source. This includes the bonding wire between multi-wide units. Pg. 1

Plumbing

Connect all sewer drains to an existing sewer tap or septic tank. Pg. 1

Connect all potable water supply piping to an existing water meter, water tap, or other independent water supply systems. Pg. 1

Site Preparation

Debris and organic material removed _____

Water drainage: Natural _____ Swale _____

Pad X Other _____

Fastening multi wide units

Floor: Type Fastener: LAGS Length: _____ Spacing: 18"
Walls: Type Fastener: LAGS Length: _____ Spacing: 16"
Roof: Type Fastener: metal screws Length: _____ Spacing: 18"

For used homes a min. 30 gauge, 8" wide, galvanized metal strip will be centered over the peak of the roof and fastened with galv. roofing nails at 2' on center on both sides of the centerline.

Gasket (weatherproofing requirement)

I understand a properly installed gasket is a requirement of all new and used homes and that condensation, mold, mildew and buckled marriage walls are a result of a poorly installed or no gasket being installed. I understand a strip of tape will not serve as a gasket.

Installer's initials

WHP

Type gasket

FOAM

Installed:

Between Floors Yes ✓

Between Walls Yes ✓

Bottom of ridgebeam Yes ✓

Weatherproofing

The bottomboard will be repaired and/or taped. Yes ✓ Pg. _____
Siding on units is installed to manufacturer's specifications. Yes ✓
Fireplace chimney installed so as not to allow intrusion of rain water. Yes ✓

Miscellaneous

Skirting to be installed. Yes ✓ No _____

Dryer vent installed outside of skirting. Yes ✓ N/A _____

Range downflow vent installed outside of skirting. Yes ✓ N/A _____

Drain lines supported at 4 foot intervals. Yes ✓ _____

Electrical crossovers protected. Yes ✓ _____

Other: _____

Installer verifies all information given with this permit worksheet is accurate and true based on the manufacturer's installation instructions and or Rule 15C-1 & 2

Installer Signature

William Price

Date

6/14/25

Mobile Home Permit Worksheet

Application Number: _____

Date: _____

Installer: William Price License # 1H-1041936

Address of home being installed

TBD SW Davis Rd

Law City FL 32024

Manufacturer



Legacy

Length x width

80x32

NOTE: if home is a single wide fill out one half of the blocking plan
if home is a triple or quad wide sketch in remainder of home
I understand Lateral Arm Systems cannot be used on any home (new or used)
where the sidewall ties exceed 5 ft 4 in.

Installer's Initials WP

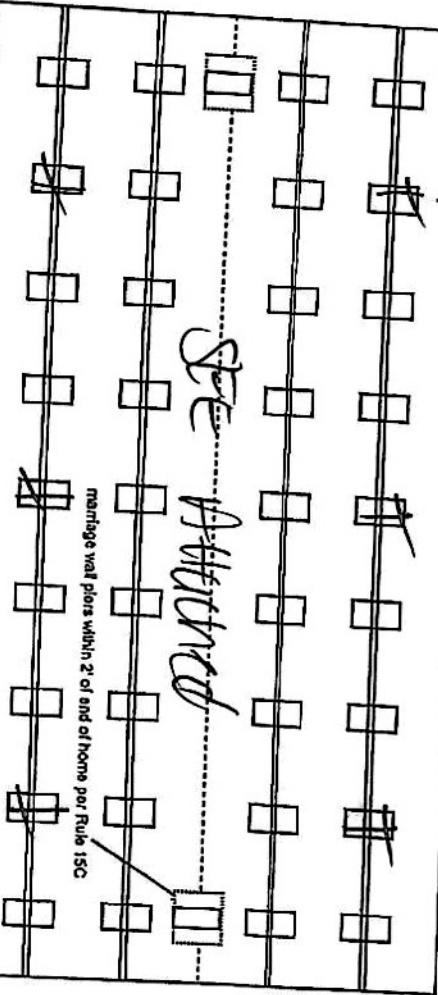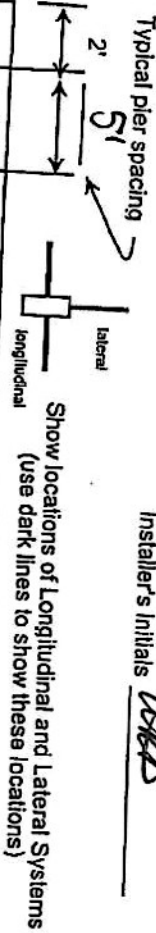

New Home ☒ Used Home ☐

Home installed to the Manufacturer's Installation Manual ☒

Home is installed in accordance with Rule 15-C ☒

Single wide ☐ Wind Zone II ☐ Wind Zone III ☒

Double wide ☒ Installation Decal # 119191

Triple/Quad ☐ Serial # 137389443

PIER SPACING TABLE FOR USED HOMES

Load bearing capacity (sq in)	16' x 16" (256)	18 1/2" x 18 1/2" (342)	20' x 20" (400)	22' x 22" (484)	24' x 24" (576)	26' x 26" (676)
1000 psf	3'	4'	5'	6'	7'	8'
1500 psf	4'6"	6'	7'	8'	8'	8'
2000 psf	6'	8'	8'	8'	8'	8'
2500 psf	7'6"	8'	8'	8'	8'	8'
3000 psf	8'	8'	8'	8'	8'	8'
3500 psf	8'	8'	8'	8'	8'	8'

* Interpolated from Rule 15C-1 pier spacing table.

PIER PAD SIZES

17x25

POPULAR PAD SIZES

Pad Size	Sq In
16 x 16	256
16 x 18	288
18.5 x 18.5	342
16 x 22.5	360
17 x 22	374
13 1/4 x 26 1/4	348
20 x 20	400
17 3/16 x 25 3/16	441
17 1/2 x 25 1/2	446
24 x 24	576
26 x 26	676

I-beam pier pad size

Perimeter pier pad size

14x16

Other pier pad sizes (required by the mfg.)

Draw the approximate locations of marriage wall openings 4 foot or greater. Use this symbol to show the piers.

List all marriage wall openings greater than 4 foot and their pier pad sizes below.

ANCHORS

Pier pad size

large

23x31

FRAME TIES

within 2' of end of home spaced at 5' 4" oc

TIEDOWN COMPONENTS

Longitudinal Stabilizing Device (LSD)

Manufacturer

Longitudinal Stabilizing Device w/ Lateral Arms

Manufacturer

OTHER TIES

Number


14

Longitudinal

Marriage wall

Shearwall

4/14/25

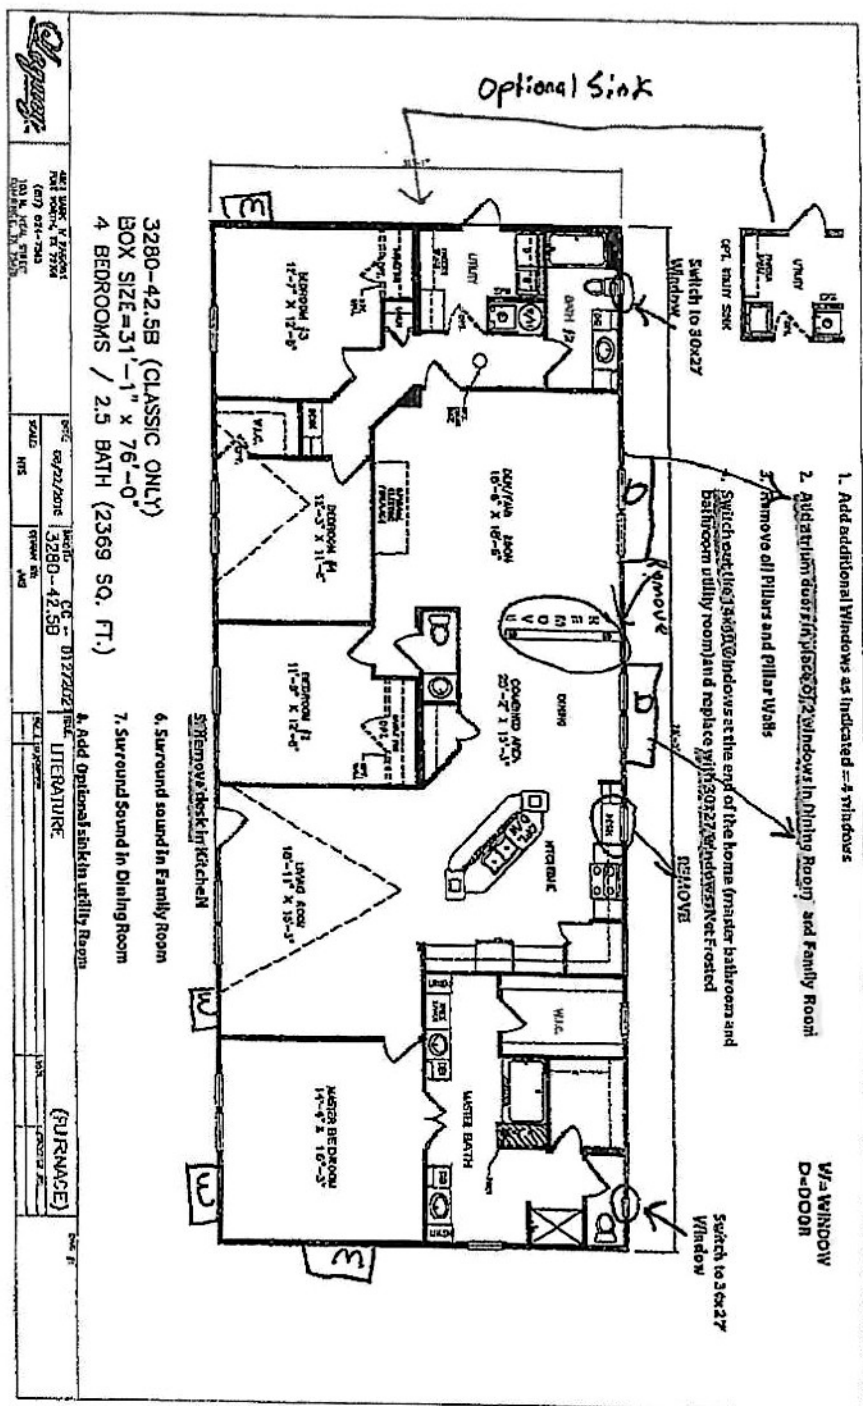

Prmbls

Burgess

32x80

Columbia

License Number: IH / 1041936 / 1 Name: WILLIAM R PRICE

Order #: 6570	Label #: 119191	Manufacturer:	(Check Size of Home)
Homeowner:		Year Model:	Single _____
Address:		Length & Width:	Double _____
City/State/Zip:		Type Longitudinal System:	Triple _____
Phone #:		Type Lateral Arm System:	HUD Label #:
Date Installed:		New Home: _____ Used Home: _____	Soil Bearing / PSF:
Installed Wind Zone:		Data Plate Wind Zone:	Torque Probe / in-lbs:
Note:			Permit #:

STATE OF FLORIDA
INSTALLATION CERTIFICATION LABEL

119191

LABEL #

DATE OF INSTALLATION

WILLIAM R PRICE

NAME

IH / 1041936 / 1

6570

LICENSE #


ORDER #

CERTIFIES THAT THE INSTALLATION OF THIS MOBILE HOME IS
IN ACCORDANCE WITH FLORIDA STATUTES 320.8249, 320.8325
AND RULES OF THE HIGHWAY SAFETY AND MOTOR VEHICLES.

INSTRUCTIONS

PLEASE WRITE DATE OF
INSTALLATION AND AFFIX
LABEL NEXT TO HUD LABEL.
USE PERMANENT INK PEN
OR MARKER ONLY.
COMPLETE INFORMATION
ABOVE AND KEEP ON FILE
FOR A MINIMUM OF 2 YEARS.
YOU ARE REQUIRED TO
PROVIDE COPIES WHEN
REQUESTED.

BURGESS
 73D DASH RD.
 LAKE CITY, FL 32024

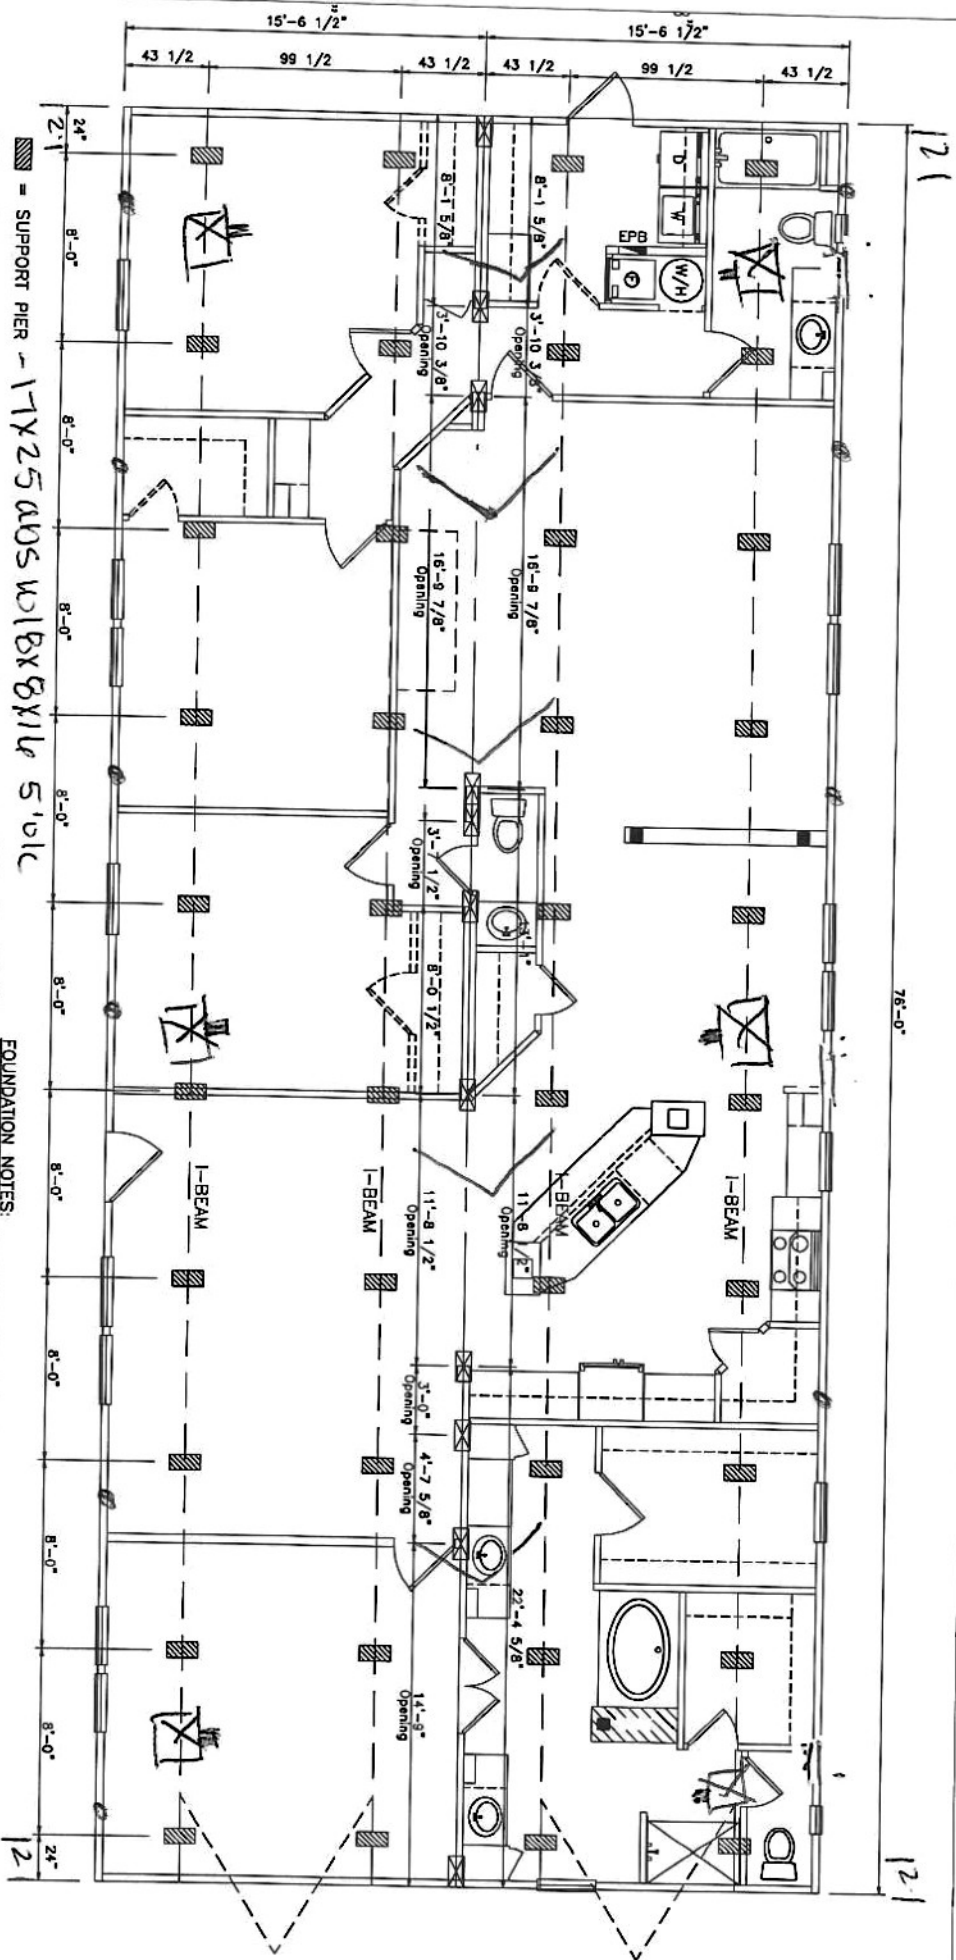

- FOUNDATION NOTES:**
1. PIER LOCATIONS INDICATED ARE FOR REFERENCE ONLY. REFER TO INSTALLATION MANUAL FOR ADDITIONAL REQUIRED LOCATIONS SUCH AS FOR OPTIONAL ITEMS LIKE FIREPLACES OR ALTERNATIVE PIER SPACINGS AND ROOF LOADS.
 2. SINGLE STACKED PIERS LESS THAN 36" HIGH.
 3. DOUBLE STACKED PIERS 36" TO 67" HIGH.
 4. UTILITY LOCATIONS ARE "GENERAL" AND IF AN EXACT DIMENSION IS REQUIRED PLEASE VERIFY WITH SPECIFIC HOME SERIAL NUMBER.

* SUPPORT PIER - 17x25 ANS w/ 18x6x16 5'0" tie down 48' anchor
 or triple stacked 17x25 5'0" tie down 48' anchor
 or double frame tie 48' anchor
 or from end then 12'0"

* All perimeter studs 16x16
 * All center line 1 shear wall anchors 40'

		4801 MARK N PARKWAY FORT WORTH, TX 76106 (817) 624-7865 101 N. NEAL STREET COMMERCE, TX 76428		DATE: 08/22/2016 SCALE: NTS MODEL: 3280-42.5B DRAWN BY: JMS	TITLE: FOUNDATION PLAN REV # DESCRIPTION DATE REVISION BY	DWG #
--	--	---	--	--	--	-------

5/30/25