Manufacturer Clayton Address of home being installed Installer: Wendell Crews Typical pier spacing NOTE: if home is a single wide fill out one half of the blocking plan if home is a triple or quad wide sketch in remainder of home lunderstand Lateral Arm Systems cannot be used on any home (new or used) where the sidewall ties exceed 5 ft 4 in... 30 Mobile Home Permit Worksheet 114 NEWY BY liprogradical Show locations of Longitudinal and Lateral Systems hute (use dark lines to show these locations) Installer's initials WC Length x width License #IH1025316 76x16 Application Number: capacity bearing interpolated from Rule 15C-1 pier spacing table Longitudinal Stabilizing Device w/ Lateral Arms Manufacturer Oliver 1101V Longitudinal Stabilizing Device (LSD) and their pier pad sizes below List all marriage wall openings greater than 4 fool Load Manufacturer (required by the mfq.) Perimeter pier pad size Home is installed in accordance with Rule 15-C Home installed to the Manufacturer's Installation Manual New Home Other pier pad sizes I-beam pier pad size Triple/Quad Double wide Single wide 2000 ps 500 500 pst Opening ps symbol to show the piers Footer wall openings 4 foot or greater. Use this Draw the approximate locations of marriage (sq in) Size TIEDOWN COMPONENTS 16" x 16" PIER PAD SIZES PIER SPACING TABLE FOR USED HOMES \times (256)6 O) Serial# Installation Decal # Wind Zone II Used Home 18 1/2" x 18 Pier pad size 1/2" (342) NA 16x16 Doors ∞ TBD 20" x 20" (400)TBD Wind Zone III 22" x 22" (484) 4 # Marriage wal within 2" of end of home spaced at 5" 4" oc N/A Shearwall Sidewall Longitudinal POPULAR PAD SIZES × 8.5 × 18 Pad Size 1/4 x 26 /16 × 25 1/2 × 25 24×24 OTHER TIES 16 x 18 16 x 1 24" X 24" FRAME TIES ANCHORS (576) 00 00 5 ft \times ANA Colivers Number golivers 5'4" oc 26" x 26" (676)676 œ 576

Mobile Home Permit Worksheet

X 1500 X 1500
--

here if you are declaring 5' anchors without testing showing 275 inch pounds or less will require 5 foot anchors The results of the torque probe test is N A inch pounds or check

Note: A state approved lateral arm system is being used and 4 ft reading is 275 or less and where the mobile home manufacturer may requires anchors with 4000 lb bedding capacity anchors are required at all centerline tie points where the torque test anchors are allowed at the sidewall locations. I understand 5 ft installer's initials

ALL TESTS MUST BE PERFORMED BY A LICENSED INSTALLER

Installer Name Wendell Crews

4/17/2023

Date Tested

Electrical

source. This includes the bonding wire between mult-wide units. Pq. N/A Connect electrical conductors between multi-wide units, but not to the main power

Plumbing

Connect all sewer drains to an existing sewer tap or septic tank. Pq. 39

independent water supply systems. Pg. 39 Connect all potable water supply piping to an existing water meter, water tap, or other

Appli	
catio	
Ň	
mbe	
ă I	

Site Preparation
Site Preparation

Fastening multi wide units

Pad X

Other

Debris and organic material removed X

Water drainage: Natural

Roof: Walls Floor roofing nails at 2" on center on both sides of the centerline will be centered over the peak of the roof and fastened with galv For used homes a min. 30 gauge, 8" wide, galvanized metal strip Type Fastener: N/A Type Fastener: N/A Type Fastener: N/A Length: -Length: -Length: -Spacing: -Spacing: -Spacing

Gasket (weatherproofing requirement)

of tape will not serve as a casket a result of a poorly installed or no gasket being installed. I understand a strip homes and that condensation, mold, meldew and buckled marriage walls are I understand a properly installed gasket is a requirement of all new and used

Installer's initials

Type gasket N/A Pq

Between Walls Yes N/A Between Floors Yes NA

Bottom of ridgebeam Yes N.A.

Weatherproofing

Siding on units is installed to manufacturer's specifications. Yes x Fireplace chimney installed so as not to allow intrusion of rain water The bottomboard will be repaired and/or taped. Yes X Yes

Miscellaneous

Other Electrical crossovers protected. Yes X Drain lines supported at 4 foot intervals. Yes X Skirting to be installed. Yes X Range downflow vent installed outside of skirting. Dryer vent installed outside of skirting. Yes X Yes NA N/A×

Installer verifies all information given with this permit worksheet manufacturer's installation instructions and or Rule 15C-1 & 2 is accurate and true based on the


Installer Signature L

Date 4-17-23

BLOCKING PLAN

Manufacturer Length x Width

= Carton

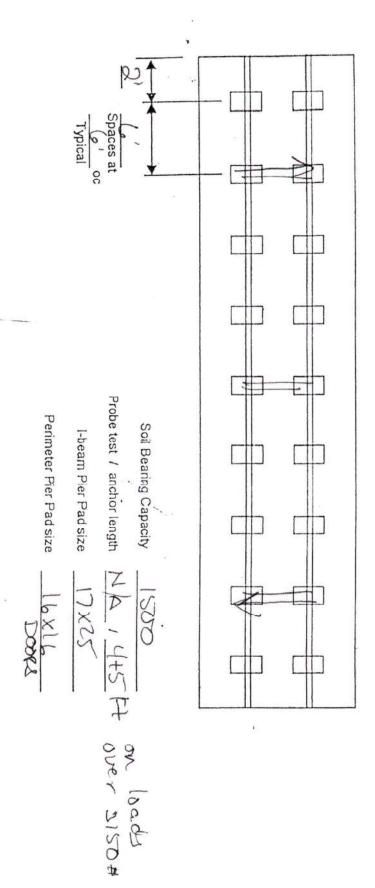

Pier Spacing based on Manual for 1500 PSF Soil.

Model 1100 All Steel Foundation system by Oliver Technologies.

4ft ground anchors except were loads exceed 3150 lbs. then 5 ft anchors.


SIDEWALL OPENING PIER LOAD 20 Ib ROOF LOAD 16' BOX WIDTH 1244 1413 1581 REQUIRED PIER LOAD (LBS) SIDEWALL OPENING (FT) 1750 0 2088 α 2425 10

FOR 30 to & 40 to ROOF LOAD REFER TO TABLES 7 & 78 IN THE INSTALLATION MANUAL

- MER PORCHRECESSED ENTRY IN WERPERMETER -PER MAN BEAM PIER LEGEND

> E -ELECTRICAL DROP SERVICE DROP LEGEND

G - GAN NLET DI - DINV PLUMBING DROP W -WITERING

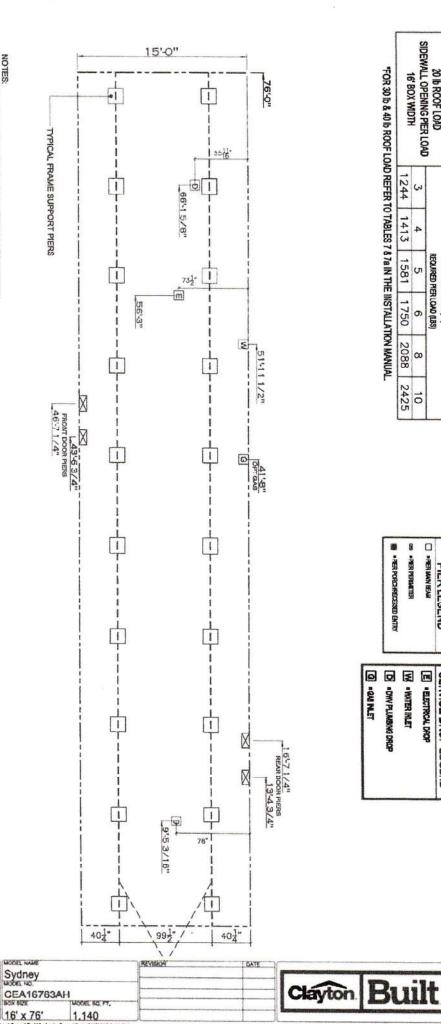

NOTES:

1. REFER TO TABLES 6 AND 8a IN THE INSTALLATION MANUAL
1. REFER TO TABLES 6 AND 8a IN THE INSTALLATION MANUAL
1. FOR LOAD ON FRAME PER FOOTINGS FOR HOMES THAT
1. DO NOT REQUIRE PERIMETER BLOCKING, REFER TO
1. DO NOT REQUIRE PERIMETER BLOCKING, REFER TO
1. TABLES 7 AND 7a IN THE INSTALLATION MANUAL FOR LOAD
1. ON FRAME PIER FOOTINGS FOR HOMES THAT REQUIRE
1. PERIMETER BLOCKING, REFER TO TABLES 10 AND 10a TO
1. DETERMINE FOOTING SIZE FOR ALL PIERS.
2. REFER TO TABLE 9 FOR PIER CONFIGURATION AND
1. REFER TO TABLE 9 FOR PIER CONFIGURATION AND
1. REFER TO TABLE 9 FOR PIER CONFIGURATION AND
1. REFER TO TABLE 9 FOR PIER CONFIGURATION AND
1. REFER TO TABLE 9 FOR PIER CONFIGURATION AND
1. THE MAXIMUM ALLOWABLE FLOOR
1. THE MAXIMUM ALLOWABLE FLOOR
1. THE MAXIMUM SPACING FOR FRAME SUPPORT PIERS FOR
1. SERVICE DROP LOCATIONS IDENTIFIED ARE
1. SERVICE DROP LOCATIONS IDENTIFIED ARE
1. SERVICE DROP LOCATIONS IDENTIFIED ARE

APPROXIMATE.

FLOOR WIDTH SHOWN IS FOR STANDARD PRODUCT ONLY.

CONTACT THE MFG FACILITY FOR SPECIFICATIONS OF

OPTIONS ORDERED.

99.5FRAME PIERS

SU-1.

P.W.HO 3/16"=1"

GUNEBA BLYC 11/25/2019 MAYOR BAY Alex Whaley

1.140

3/1/2022

CE-S010-78-3