

COLUMBIA COUNTY PERMIT WORKSHEET

page 1 of 2

These worksheets must be completed and signed by the installer.
Submit the originals with the packet.

Installer Rusty L. Kwones License # IA-1038219


911 Address where home is being installed 8483 SW SR 247

Manufacturer Live Oak Length x width 28 x 80

NOTE: if home is a single wide fill out one half of the blocking plan
if home is a triple or quad wide sketch in remainder of home

I understand Lateral Arm Systems cannot be used on any home (new or used)
where the sidewall ties exceed 5 ft 4 in

Installer's initials RLK

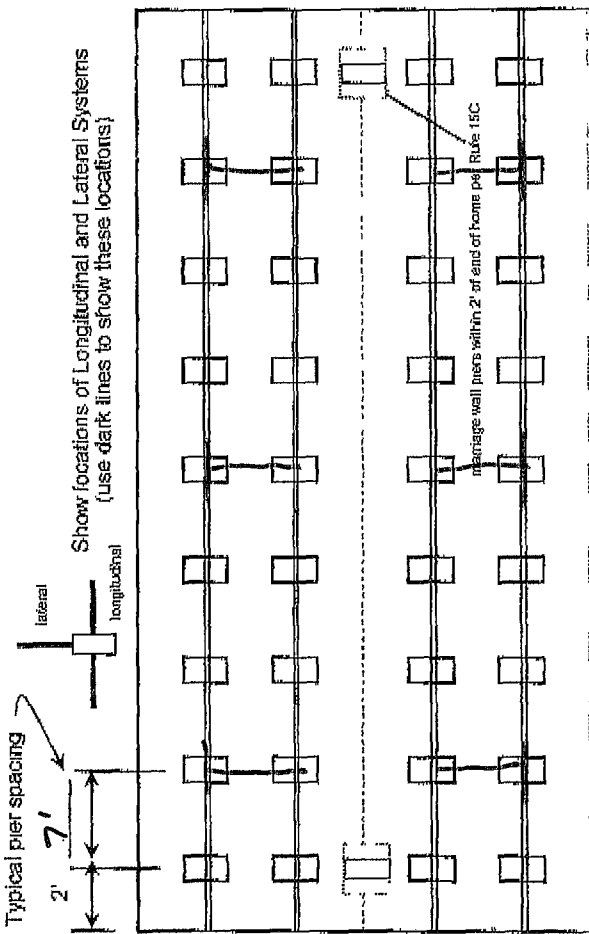

New Home ☒ Used Home ☐

Home installed to the Manufacturer's Installation Manual ☒

Home is installed in accordance with Rule 15-C ☐

Single wide ☐ Wind Zone II ☒ Wind Zone III ☐

Double wide ☒ Installation Decal # 20725

Triple/Quad ☐ Serial # LOHGA11314624A/B

PIER SPACING TABLE FOR USED HOMES

Load bearing capacity	Footer size (sq in)	16" x 16" (256)	18 1/2" x 18 1/2" (342)	20" x 20" (400)	22" x 22" (484)*	24" x 24" (576)*	26" x 26" (676)
1000 dsf	3'	4'	4'	5'	6'	7'	8'
1500 dsf	4' 6"	6'	6'	7'	8'	8'	8'
2000 dsf	6'	8'	8'	8'	8'	8'	8'
2500 dsf	7' 6"	8'	8'	8'	8'	8'	8'
3000 dsf	8'	8'	8'	8'	8'	8'	8'
3500 dsf	8'	8'	8'	8'	8'	8'	8'

* Interpolated from Rule 15C-1 pier spacing table

POPULAR PAD SIZES

Pad Size	Sq In
16 x 16	256
18 x 18	324
18.5 x 18.5	342
16 x 22.5	360
17 x 22	374
13 1/4 x 26 1/4	343
20 x 20	400
17 3/16 x 25 3/16	441
17 1/2 x 25 1/2	446
24 x 24	576
26 x 26	676

I-beam pier pad size 23 1/4 x 3 1/4

Perimeter pier pad size N/A

Other pier pad sizes (required by the mfg.) 16 x 16

Draw the approximate locations of marriage wall openings 4 foot or greater. Use this symbol to show the piers.

List all marriage wall openings greater than 4 foot and their pier pad sizes below.

Opening 20' Pier pad size 2-24x24

4 ft 5 ft

FRAME TIES

within 2' of end of home spaced at 5' 4" oc

TIEDOWN COMPONENTS

Longitudinal Stabilizing Device (LSD) Manufacturer Oliver Tech

Longitudinal Stabilizing Device w/ Lateral Arms Manufacturer Oliver Tech

OTHER TIES

Number 28

Sidewall Longitudinal Marriage wall Shearwall

COLUMBIA COUNTY PERMIT WORKSHEET

page 2 of 2

POCKET PENETROMETER TEST

The pocket penetrometer tests are rounded down to _____ psf or check here to declare 1000 lb soil ☒ without testing.

x 1.0 x 1.0 x 1.0

POCKET PENETROMETER TESTING METHOD

- Test the perimeter of the home at 6 locations.
- Take the reading at the depth of the footer.
- Using 500 lb increments, take the lowest reading and round down to that increment.

TORQUE PROBE TEST

The results of the torque probe test is NA using 110 lb inch pounds or check here if you are declaring 5' anchors without testing. A test showing 275 inch pounds or less will require 5 foot anchors

Note A state approved lateral arm system is being used and 4 ft. anchors are allowed at the sidewall locations. I understand 5 ft anchors are required at all centerline tie points where the torque test reading is 275 or less and where the mobile home manufacturer may requires anchors with 4000 lb holding capacity

RLK Installer's initials

ALL TESTS MUST BE PERFORMED BY A LICENSED INSTALLER

Installer Name Rushy L. Knowles

Date Tested 2-18-14

Electrical

Connect electrical conductors between multi-wide units, but not to the main power source. This includes the bonding wire between multi-wide units. Pg. 152.1

Plumbing

Connect all sewer drains to an existing sewer tap or septic tank. Pg. 152.1

Connect all potable water supply piping to an existing water meter, water tap, or other independent water supply systems. Pg. 152.1

Site Preparation

Debris and organic material removed ☒ Swale ☐ Pad ☒ Other ☐

Fastening multi wide units

	Type Fastener	Length	Spacing
Floor	<u>LAGS</u>	<u>6"</u>	<u>20"</u>
Walls	<u>Spacers</u>	<u>4"</u>	<u>24"</u>
Roof:	Type Fastener: <u>5/16x3</u>	Length: <u>1 1/4"</u>	Spacing: <u>48"</u>

For used homes a min. 30 gauge, 8" wide, galvanized metal strip will be centered over the peak of the roof and fastened with galv roofing nails at 2" on center on both sides of the centerline

Gasket (weatherproofing requirement)

I understand a properly installed gasket is a requirement of all new and used homes and that condensation, mold, mildew and buckled mamage walls are a result of a poorly installed or no gasket being installed I understand a strip of tape will not serve as a gasket.

Installer's initials RLK

Type gasket factory Installed ☐

Between Floors Yes ☐

Between Walls Yes ☐

Bottom of ridgebeam Yes ☐

Weatherproofing

The bottomboard will be repaired and/or taped. Yes ☒ Pg. 152.1

Siding on units is installed to manufacturer's specifications. Yes ☒

Fireplace chimney installed so as not to allow intrusion of rain water Yes ☐

Miscellaneous

Skirting to be installed Yes ☐ No ☒

Dryer vent installed outside of skirting. Yes ☐ No ☒

Range downflow vent installed outside of skirting Yes ☐ No ☒

Drain lines supported at 4 foot intervals. Yes ☐ No ☒

Electrical crossovers protected. Yes ☐ No ☒


Other ☐

Installer verifies all information given with this permit worksheet is accurate and true based on the

Installer Signature [Signature] Date 2-18-14

53

✗ - 6-1101V All steel foundations from Oliver trach
 ▯ - I Beam piers 7' O.C. using 23 1/4 x 3 1/4 AB spads

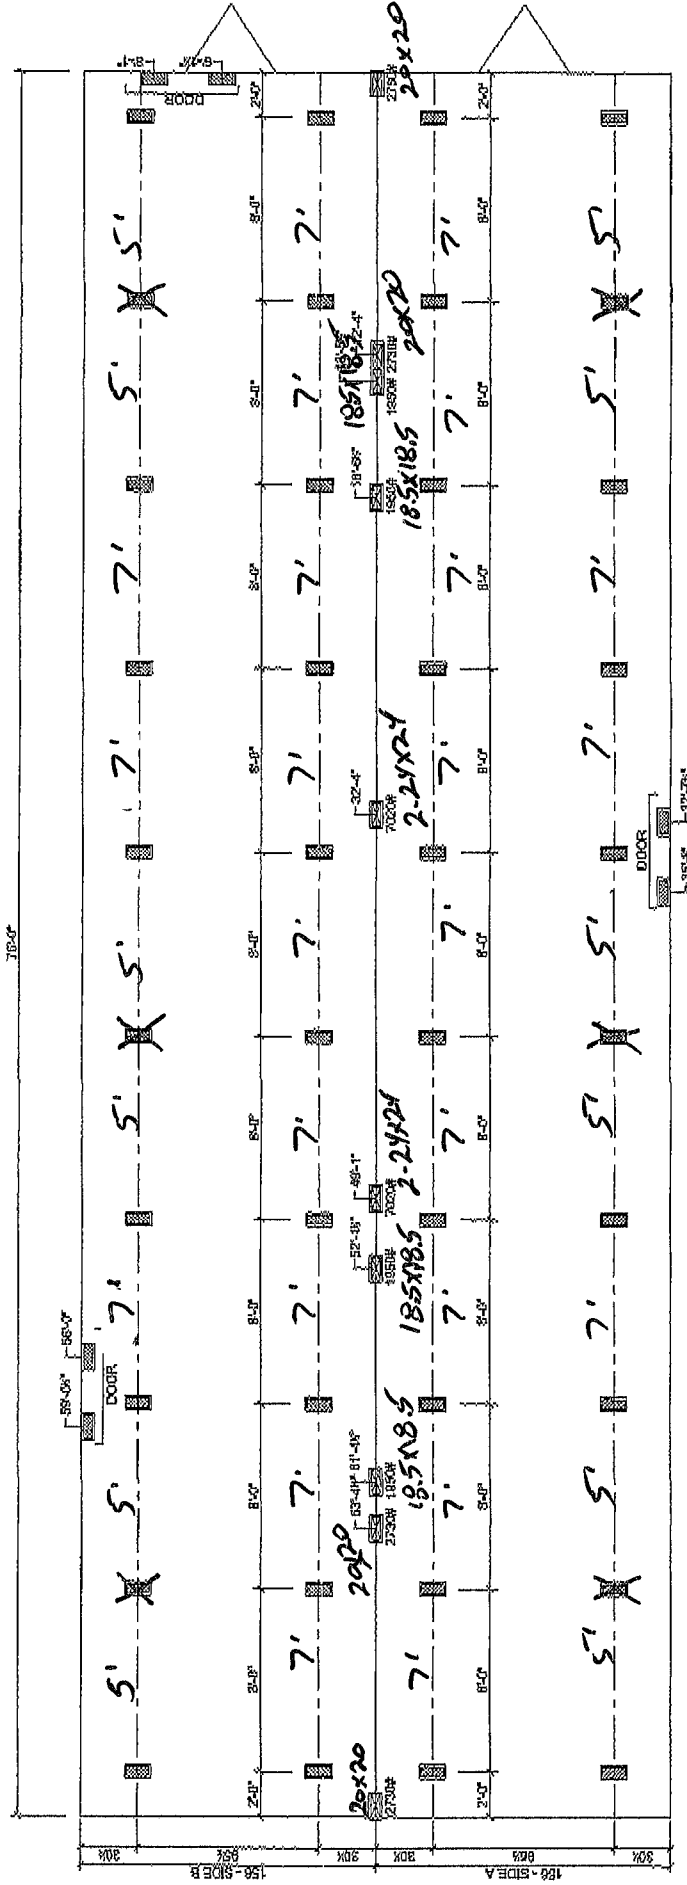

TIEDOWN LOCATIONS
 ✗ MARRIAGE LINE OPENING SUPPORT PIERTYP.

▯ SUPPORT PIERTYP

FOUNDATION NOTES:

- THIS DRAWING IS DESIGNED FOR THE STANDARD WIND ZONE AND IS TO BE USED IN CONJUNCTION WITH THE INSTALLATION MANUAL AND ITS SUPPLEMENTS.
 - FOOTINGS ARE SHOWN FOR EXAMPLE ONLY. QUANTITY AND SPACING MAY VARY BASED ON PAD TYPE, SOIL CONDITION, ETC.
 - FOOTINGS ARE REQUIRED AT SUPPORT POSTS, SEE INSTALLATION MANUAL FOR REQUIREMENTS.

Live Oak Homes
MODEL: L-2764D - 28 X 80
4-BEDROOM / 2-BATH

- (A) MAIN ELECTRICAL
- (B) ELECTRICAL CROSSOVER
- (C) WATER INLET
- (D) WATER CROSSOVER (IF ANY)
- (E) GAS INLET (IF ANY)
- (F) GAS CROSSOVER (IF ANY)
- (G) DUCT CROSSOVER
- (H) SEWER DROPS
- (I) RETURN AIR (W/OUT HEAT PUMP OR DUCT)
- (J) SUPPLY AIR (W/OUT HEAT PUMP OR DUCT)

L-2764D

53