

Mobile Home Permit Worksheet


Installer: Ernest S. Johnson License # IH1025249

Address of home being installed _____

Manufacturer: Scot B. H. Length x width 48x28

NOTE: if home is a single wide fill out one half of the blocking plan
if home is a triple or quad wide sketch in remainder of home
I understand Lateral Arm Systems cannot be used on any home (new or used)
where the sidewall ties exceed 5 ft 4 in.

Installer's initials ESJ

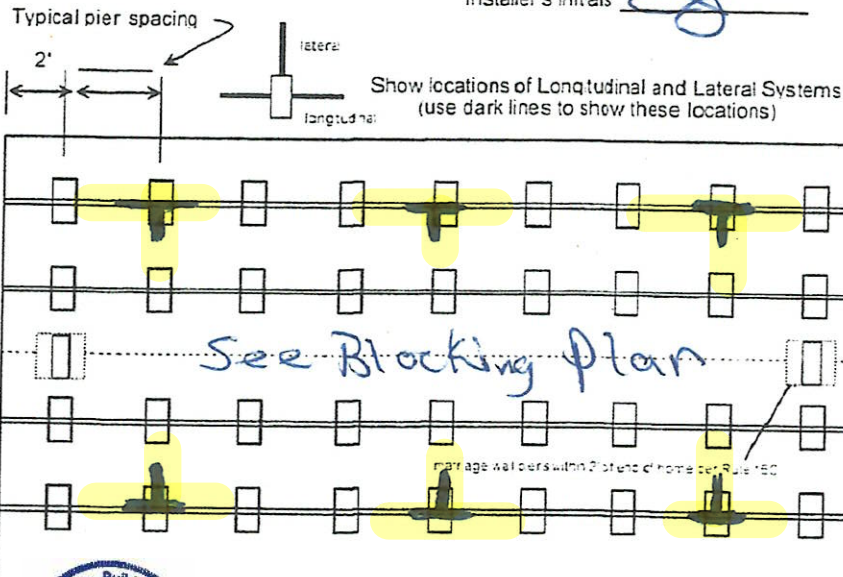

Laurie Hodson

Digitally signed
by Laurie Hodson
Date: 2020.10.23
12:11:22 -04'00'

Application Number: _____ Date: _____

New Home ☒ Used Home ☐

Home installed to the Manufacturer's Installation Manual
Home is installed in accordance with Rule 15-C

Single wide ☐ Wind Zone II ☒ Wind Zone III ☐

Double wide ☒ Installation Decal # 74426

Triple/Quad ☐ Serial # _____

PIER SPACING TABLE FOR USED HOMES

Load bearing capacity	Footer size (sq in)	16' x 16' (256)	18 1/2' x 18 1/2' (342)	20' x 20' (400)	22' x 22' (484)	24' x 24' (576)	26' x 26' (676)
1000 psf		3'	4'	5'	6'	7'	8'
1500 psf		4' 6"	6'	7'	8'	8'	8'
2000 psf		6'	8'	8'	8'	8'	8'
2500 psf		7' 6"	8'	8'	8'	8'	8'
3000 psf		8'	8'	8'	8'	8'	8'
3500 psf		8'	8'	8'	8'	8'	8'

* Interpolated from Rule 15C-1 pier spacing table.

PIER PAD SIZES

I-beam pier pad size 23x31 70c

Perimeter pier pad size Oliver 1055-11 OR 16x18

Other pier pad sizes (required by the mfg.) _____

Draw the approximate locations of marriage wall openings 4 foot or greater. Use this symbol to show the piers.

List all marriage wall openings greater than 4 foot and their pier pad sizes below

Opening	Pier pad size
<u>17.5x25.5</u>	<u>17.5x25.5</u>

TIEDOWN COMPONENTS

Longitudinal Stabilizing Device (LSD)
Manufacturer _____
Longitudinal Stabilizing Device w/ Lateral Arms
Manufacturer _____

POPULAR PAD SIZES

Pad Size	Sq In
16 x 16	256
16 x 18	288
18.5 x 18.5	342
16 x 22.5	360
17 x 22	374
13 1/4 x 26 1/4	348
20 x 20	400
17 3/16 x 25 3/16	441
17 1/2 x 25 1/2	446
24 x 24	576
26 x 26	676

ANCHORS

4' 5'

FRAME TIES

within 2' of end of home
spaced at 5' 4" oc

OTHER TIES

	Number
Sidewall	<u>26</u>
Longitudinal	<u>0</u>
Marriage wall	<u>6</u>
Shearwall	<u>2</u>

Oliver 1102 V

Mobile Home Permit Worksheet

Application Number: _____ Date: _____

POCKET PENETROMETER TEST

The pocket penetrometer tests are rounded down to _____ psf
or check here to declare 1000 lb. soil _____ without testing

X 1000 X 1000 X 1000

POCKET PENETROMETER TESTING METHOD

1. Test the perimeter of the home at 6 locations
2. Take the reading at the depth of the footer
3. Using 500 lb. increments, take the lowest reading and round down to that increment

X 1000 X 1000 X 1000

TORQUE PROBE TEST

The results of the torque probe test is _____ inch pounds or check
here if you are declaring 5' anchors without testing A test:
showing 275 inch pounds or less will require 5 foot anchors.

Note: A state approved lateral arm system is being used and 4 ft
anchors are allowed at the sidewall locations. I understand 5 ft
anchors are required at all centerline tie points where the torque test
reading is 275 or less and where the mobile home manufacturer may
requires anchors with 4000 lb holding capacity.

Installer's initials

ALL TESTS MUST BE PERFORMED BY A LICENSED INSTALLER

Installer Name Ernest S. Johnson

Date Tested Assumed Oliver 1101 V uses

485 foot Anchors Both

Electrical

Connect electrical conductors between multi-wide units, but not to the main power
source. This includes the bonding wire between multi-wide units. Pg _____

Plumbing

Connect all sewer drains to an existing sewer tap or septic tank. Pg _____

Connect all potable water supply piping to an existing water meter, water tap, or other
independent water supply systems. Pg _____

Site Preparation

Debris and organic material removed _____
Water drainage: Natural Swale Pad Other _____

Fastening multi wide units

Floor: Type Fastener: 1095 Length: 7 Spacing: 24
Walls: Type Fastener: 1095 Length: 4 Spacing: 12
Roof: Type Fastener: 1095 Length: 7 Spacing: 24
For used homes a min. 30 gauge, 8" wide, galvanized metal strip
will be centered over the peak of the roof and fastened with galv.
roofing nails at 2" on center on both sides of the centerline.

Gasket (weatherproofing requirement)

I understand a properly installed gasket is a requirement of all new and used
homes and that condensation, mold, mildew and buckled marriage walls are
a result of a poorly installed or no gasket being installed. I understand a strip
of tape will not serve as a gasket.

Installer's initials

Type gasket
Pg. R11

Installed:
Between Floors Yes
Between Walls Yes
Bottom of ridgebeam Yes

Weatherproofing

The bottomboard will be repaired and/or taped. Yes Pg. _____
Siding on units is installed to manufacturer's specifications Yes
Fireplace chimney installed so as not to allow intrusion of rain water. Yes


Miscellaneous

Skirting to be installed. Yes _____ No Yes
Dryer vent installed outside of skirting. Yes _____ N/A
Range downflow vent installed outside of skirting. Yes _____ N/A
Drain lines supported at 4 foot intervals. Yes _____
Electrical crossovers protected. Yes _____
Other _____

Installer verifies all information given with this permit worksheet
is accurate and true based on the
manufacturer's installation instructions and or Rule 15C-1 & 2

Installer Signature Ernest S. Johnson Date _____

HITCH-END

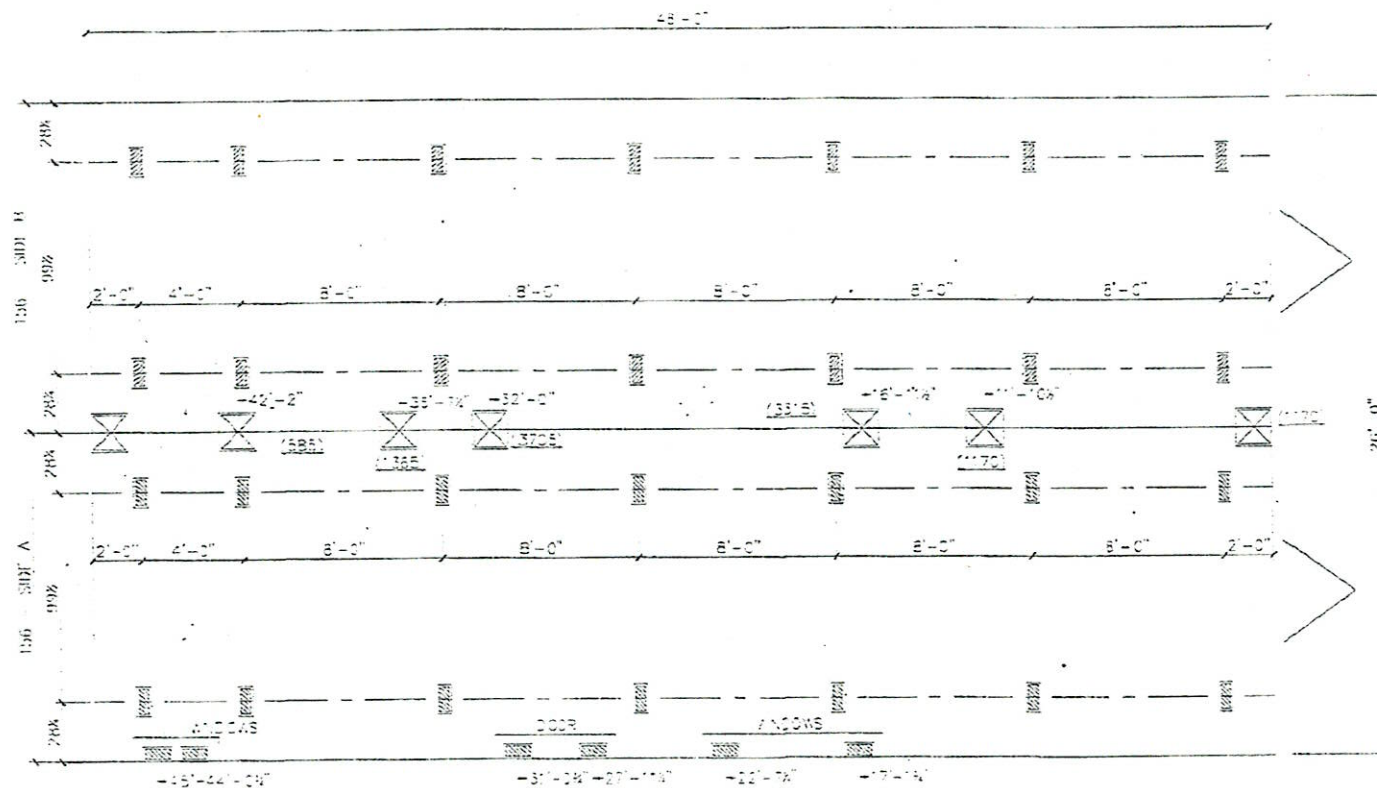

1. OVERHEAD LINE DRIVING SUPPORT DEVICES

2. OVERHEAD LINE DRIVING SUPPORT DEVICES

3. OVERHEAD LINE DRIVING SUPPORT DEVICES

4. OVERHEAD LINE DRIVING SUPPORT DEVICES



DATE: 05/03/2018

VERSION B 09/28/2018

REFERENCE: M302

AREA

TOTAL: 1,248 ft²

LIVING SPACE: 1,248 ft²

PORCH: 0 ft²

UNIT SPECIFICATIONS:

GRAND SLAM



28' X 52'
3 BEDROOM / 2 BATH

DRAWING/MODEL NUMBER:

2848302GSM

ScotBilt
HOMES, INC.

HITCH-END

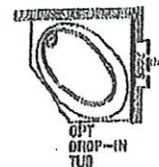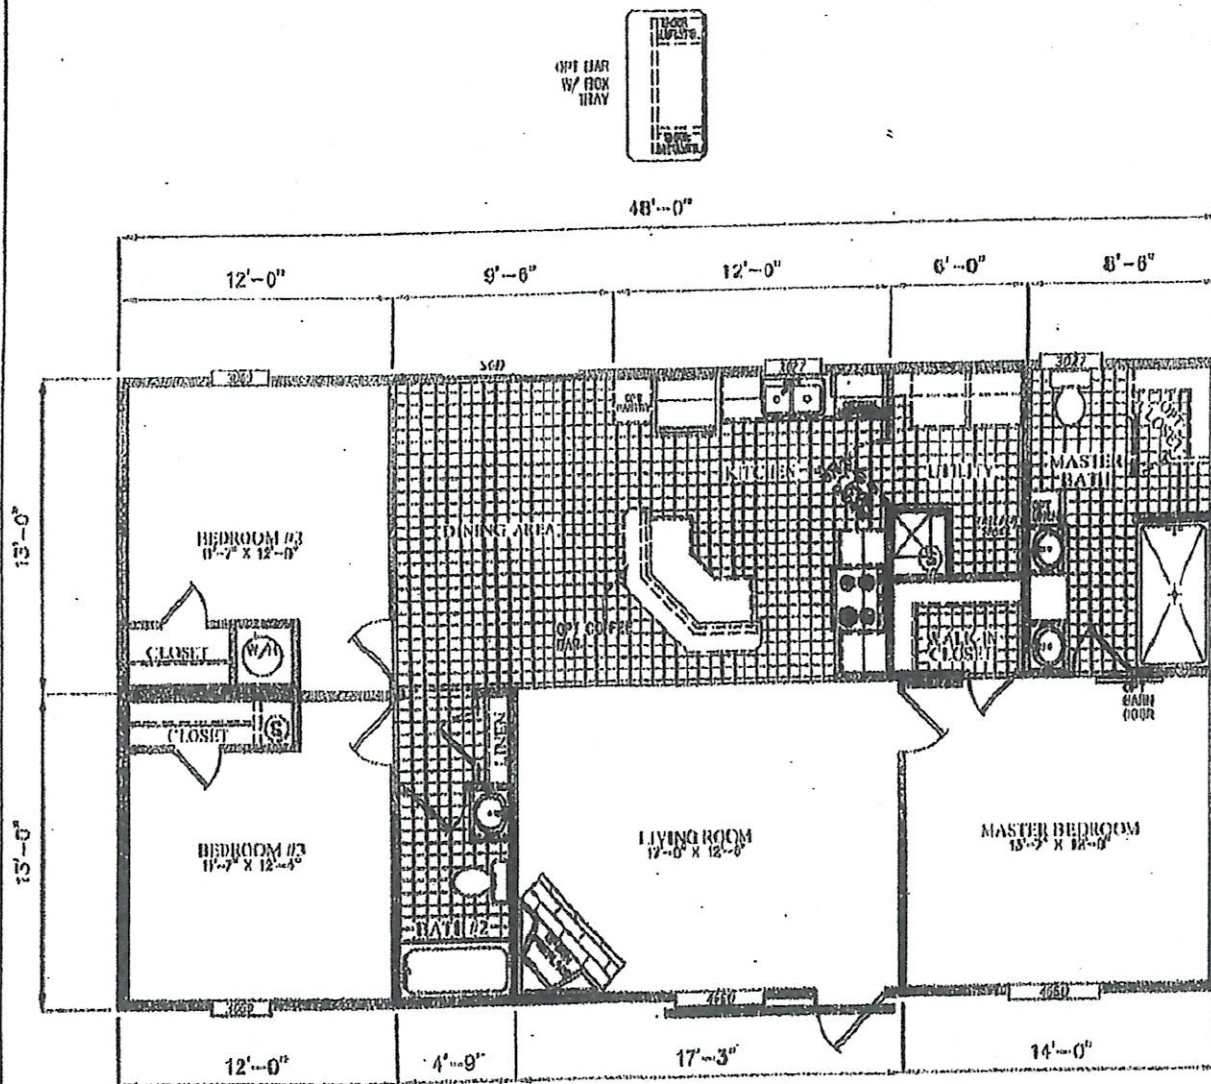

DATE: 05/03/2010	TOTAL: 1,240 ft ²	UNIT SPECIFICATIONS:	DRAWING/MODEL NUMBER:
VERSION: 0 05/28/2010	LIVING SPACE: 1,240 ft ²	GRAND SLAM 29' X 62' 1 BEDROOM / 2 BATH	2848302GSM

ScotBilt
HOMES, INC.