

COLUMBIA COUNTY PERMIT WORKSHEET

page 1 of 2

These worksheets must be completed and signed by the installer.
Submit the originals with the packet.



Installer Kenneth Nicks License # 2H/MS/1421
911 Address where home is being installed 347 SW Lakeland Ave
Manufacturer Home Mart Length x width 28x64
L.C. # 32024

New Home ☐ Used Home ☒
Home installed to the Manufacturer's Installation Manual ☒
Home is installed in accordance with Rule 15-C ☐
Single wide ☐ Wind Zone II ☒ Wind Zone III ☐
Double wide ☐ Installation Decal # 178277
Triple/Quad ☐ Serial # FLHML2F163728075A

NOTE: if home is a single wide fill out one half of the blocking plan
if home is a triple or quad wide sketch in remainder of home

I understand Lateral Arm Systems cannot be used on any home (new or used)
where the sidewall ties exceed 5 ft 4 in

Installer's initials KN

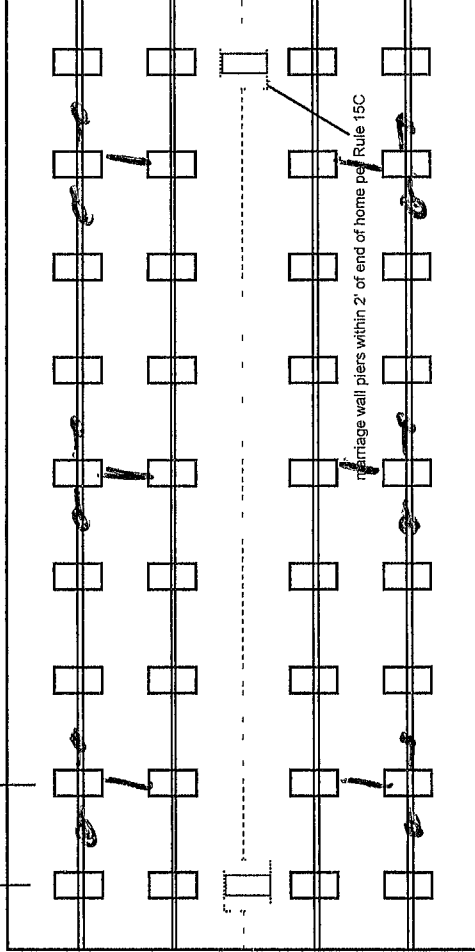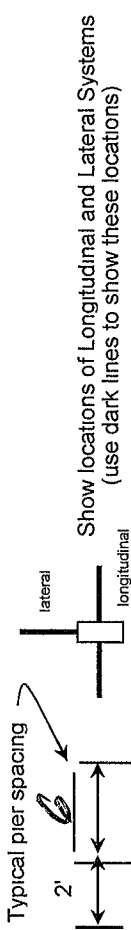

PIER SPACING TABLE FOR USED HOMES

Load bearing capacity	Footer size (sq in)	16" x 16" (256)	18 1/2" x 18 1/2" (342)	20" x 20" (400)	22" x 22" (484)*	24" x 24" (576)*	26" x 26" (676)
1000 psf	3'		4'	5'	6'	7'	8'
1500 psf	4' 6"		6'	7'	8'	8'	8'
2000 psf	6'		8'	8'	8'	8'	8'
2500 psf	7' 6"		8'	8'	8'	8'	8'
3000 psf	8'		8'	8'	8'	8'	8'
3500 psf	8'		8'	8'	8'	8'	8'

* interpolated from Rule 15C-1 pier spacing table

PIER PAD SIZES

I-beam pier pad size 17x25
Perimeter pier pad size NP
Other pier pad sizes (required by the mfg) 16x4

Draw the approximate locations of marriage wall openings 4 foot or greater Use this symbol to show the piers

List all marriage wall openings greater than 4 foot and their pier pad sizes below

Opening	Pier pad size
8	17x25
7	16x16
4	16x16

TIEDOWN COMPONENTS

Longitudinal Stabilizing Device (LSD)
Manufacturer
Longitudinal Stabilizing Device w/ Lateral Arms
Manufacturer

POPULAR PAD SIZES

Pad Size	Sq In
16 x 16	256
16 x 18	288
18 5/8 x 18 5/8	342
16 x 22 5/8	360
17 x 22	374
13 1/4 x 26 1/4	348
20 x 20	400
22 3/16 x 25 3/16	441
17 1/2 x 25 1/2	446
24 x 24	576
26 x 26	676

ANCHORS

4 ft 4 5 ft

FRAME TIES

within 2' of end of home spaced at 5' 4" oc

OTHER TIES

Number
Sidewall 26
Longitudinal 26
Marriage wall 26
Shearwall 26

COLUMBIA COUNTY PERMIT WORKSHEET

page 2 of 2

POCKET PENETROMETER TEST

The pocket penetrometer tests are rounded down to 1500 psf
or check here to declare 1000 lb soil 1500 without testing 1500 x 1500

POCKET PENETROMETER TESTING METHOD

- 1 Test the perimeter of the home at 6 locations
- 2 Take the reading at the depth of the footer
- 3 Using 500 lb increments, take the lowest reading and round down to that increment

1500 x 1500 x 1500

TORQUE PROBE TEST

The results of the torque probe test is 200 inch pounds or check here if you are declaring 5' anchors without testing 200 A test showing 275 inch pounds or less will require 5 foot anchors

Note: A state approved lateral arm system is being used and 4 ft anchors are allowed at the sidewall locations. I understand 5 ft anchors are required at all centerline tie points where the torque test reading is 275 or less and where the mobile home manufacturer may require anchors with 4000 lb holding capacity

Installer's initials

ALL TESTS MUST BE PERFORMED BY A LICENSED INSTALLER

Installer Name

Date Tested

Electrical

Connect electrical conductors between multi-wide units, but not to the main power source This includes the bonding wire between multi-wide units Pg

Plumbing

Connect all sewer drains to an existing sewer tap or septic tank. Pg
Connect all potable water supply piping to an existing water meter, water tap, or other independent water supply systems Pg

Site Preparation

Debris and organic material removed ✓
Water drainage Natural ✓ Swale ✓ Pad ✓ Other ✓

Fastening multi wide units

Floor Type Fastener 3/8" Length 6" Spacing 24"
Walls Type Fastener 3/8" Length 6" Spacing 16"
Roof Type Fastener 3/8" Length 6" Spacing 16"
For used homes a min 30 gauge, 8" wide, galvanized metal strip will be centered over the peak of the roof and fastened with galv roofing nails at 2" on center on both sides of the centerline

Gasket (weatherproofing requirement)

I understand a properly installed gasket is a requirement of all new and used homes and that condensation, mold, mildew and buckled marriage walls are a result of a poorly installed or no gasket being installed I understand a strip of tape will not serve as a gasket.

Installer's initials

Type gasket

Installed

Between Floors Yes

Between Walls Yes

Bottom of ridgebeam Yes

Weatherproofing

The bottomboard will be repaired and/or taped Yes Pg
Siding on units is installed to manufacturer's specifications Yes
Fireplace chimney installed so as not to allow intrusion of rain water Yes

Miscellaneous

Skirting to be installed Yes No
Dryer vent installed outside of skirting Yes N/A
Range downflow vent installed outside of skirting Yes N/A
Drain lines supported at 4 foot intervals Yes
Electrical crossovers protected Yes
Other

Installer verifies all information given with this permit worksheet is accurate and true based on the

Installer Signature

Date

2-26-03