

License Number: IH / 1129420 / 1 Name: DAVID E ALBRIGHT		
Order #: 5763	Label #: 98745	Manufacturer: <u>LIVE OAK</u>
Homeowner: <u>DERON</u>	Year Model: <u>2024</u>	(Check Size of Home) Single _____ Double _____ Triple <u>X</u>
Address: <u>588 SW CHAIET TER.</u>	Length & Width: <u>76' x 45'</u>	HUD Label #:
City/State/Zip: <u>FORT WHITE FL 32038</u>	Type Longitudinal System: <u>8 OTI</u>	Soil Bearing / PSF:
Phone #:	Type Lateral Arm System: <u>8 OTI</u>	Torque Probe / in-lbs:
Date Installed:	New Home: <u>X</u> Used Home: _____	Permit #:
Installed Wind Zone: <u>II</u>	Data Plate Wind Zone: <u>II</u>	
Note:		

**STATE OF FLORIDA
INSTALLATION CERTIFICATION LABEL**

98745

LABEL #

DATE OF INSTALLATION

DAVID E ALBRIGHT

NAME

IH / 1129420 / 1

5763

LICENSE #

ORDER #

CERTIFIES THAT THE INSTALLATION OF THIS MOBILE HOME IS
IN ACCORDANCE WITH FLORIDA STATUTES 320.8249, 320.8325
AND RULES OF THE HIGHWAY SAFETY AND MOTOR VEHICLES.

INSTRUCTIONS

PLEASE WRITE DATE OF
INSTALLATION AND AFFIX
LABEL NEXT TO HUD LABEL.
USE PERMANENT INK PEN
OR MARKER ONLY.
COMPLETE INFORMATION
ABOVE AND KEEP ON FILE
FOR A MINIMUM OF 2 YEARS.
YOU ARE REQUIRED TO
PROVIDE COPIES WHEN
REQUESTED.

Mobile Home Permit Worksheet

Installer: DAVID AIBRIGHT License # 1H-1129420

Address of home being installed

588 SW Chalet Ter Fort White FL 32038

Manufacturer LIVE OAK Length x width 76x45

NOTE: If home is a single wide fill out one half of the blocking plan. If home is a triple or quad wide sketch in remainder of home. I understand Lateral Arm Systems cannot be used on any home (new or used) where the sidewall ties exceed 5 ft 4 in.



Installer's initials DA

PIER SPACING TABLE FOR USED HOMES

Load bearing capacity	Footer size (sq in)	16" x 16" (256)	18 1/2" x 18 1/2" (342)	20" x 20" (400)	22" x 22" (484)*	24" x 24" (576)*	26" x 26" (676)
1000 psf	3'	3'	4'	5'	6'	7'	8'
1500 psf	4' 6"	4' 6"	6'	7'	8'	9'	10'
2000 psf	6'	6'	8'	9'	10'	11'	12'
2500 psf	7' 6"	7' 6"	9'	10'	11'	12'	13'
3000 psf	8'	8'	10'	11'	12'	13'	14'
3500 psf	8'	8'	10'	11'	12'	13'	14'

* Interpolated from Rule 15C-1 pier spacing table.

PIER PAD SIZES

I-beam pier pad size 17x26

Perimeter pier pad size 16x16

Other pier pad sizes (required by the mfg.) 23x31

Draw the approximate locations of marriage wall openings 4 foot or greater. Use this symbol to show the piers.

List all marriage wall openings greater than 4 foot and their pier pad sizes below.

Opening FACTORY Pier pad size DIAGRAM

ANCHORS

4 ft 5 ft

FRAME TIES

within 2' of end of home spaced at 5' 4" oc

TIEDOWN COMPONENTS

Longitudinal Stabilizing Device (LSD)
Manufacturer OLIVER TECHNOLOGIES

Longitudinal Stabilizing Device w/ Lateral Arms
Manufacturer OLIVER TECHNOLOGIES

OTHER TIES

Number 38

Sidewall 3

Longitudinal 3

Marriage wall 19570-4

Shearwall 13

Mobile Home Permit Worksheet

Application Number: DW

Date: 1

POCKET PENETROMETER TEST

The pocket penetrometer tests are rounded down to per or check here to declare 1000 lb. soil X without testing.

X X X

POCKET PENETROMETER TESTING METHOD

1. Test the perimeter of the home at 6 locations.
2. Take the reading at the depth of the footer.
3. Using 500 lb. increments, take the lowest reading and round down to that increment.

X X X

TORQUE PROBE TEST

The results of the torque probe test is 2.55 inch pounds or check here if you are declaring 5' anchors without testing . A test showing 275 inch pounds or less will require 5 foot anchors.

Note: A state approved lateral arm system is being used and 4 ft. anchors are allowed at the sidewall locations. I understand 5 ft anchors are required at all centerline tie points where the torque test reading is 275 or less and where the mobile home manufacturer may require anchors with 4000 loading capacity.

Installer's Initials

ALL TESTS MUST BE PERFORMED BY A LICENSED INSTALLER

Installer Name DAVID HIBBERT MOBILE HOME SVC

Date Tested

Electrical

Connect electrical conductors between multi-wide units, but not to the main power source. This includes the bonding wire between multi-wide units. Pg. 64-68

Plumbing

Connect all sewer drains to an existing sewer tap or septic tank. Pg. 70

Connect all potable water supply piping to an existing water meter, water tap, or other independent water supply systems. Pg. 107

Site Preparation

Debris and organic material removed
Water drainage: Natural Swale Pad Other

Fastening multi wide units

Floor: Type Fastener: LAG Length: 6" Spacing: 2'
Walls: Type Fastener: LAG Length: 4" Spacing: 18"
Roof: Type Fastener: LAG Length: 6" Spacing: 2'
For used homes a min. 30 gauge, 8" wide, galvanized metal strip will be centered over the peak of the roof and fastened with galv. roofing nails at 2' on center on both sides of the centerline.

Gasket (weatherproofing requirement)

I understand a properly installed gasket is a requirement of all new and used homes and that condensation, mold, mildew and buckled marriage walls are a result of a poorly installed or no gasket being installed. I understand a strip of tape will not serve as a gasket.

Installer's Initials

Type gasket
Pg. 36

Installed:
Between Floors Yes X
Between Walls Yes END WALLS
Bottom of ridgebeam Yes X

Weatherproofing

The bottomboard will be repaired and/or taped. Yes X Pg. 119
Siding on units is installed to manufacturer's specifications. Yes
Fireplace chimney installed so as not to allow intrusion of rain water. Yes

Miscellaneous

Stirring to be installed. Yes No X
Dryer vent installed outside of stirring. Yes No X
Range downflow vent installed outside of stirring. Yes No X
Drain lines supported at 4 foot intervals. Yes X No
Electrical crossovers protected. Yes X No
Other:

Installer verifies all information given with this permit worksheet is accurate and true based on the manufacturer's installation instructions and or Rule 15C-1-2-2



Installer Signature David Hibbert Date

[illegible]

REV: 02/27/22

FOUNDATION NOTES:

THIS DRAWING IS DESIGNED FOR THE STANDARD WIND ZONE AND IS TO BE USED IN CONJUNCTION WITH THE INSTALLATION MANUAL AND ITS SUPPLEMENTS.
FOOTINGS ARE SHOWN FOR EXAMPLE ONLY. QUANTITY AND SPACING MAY VARY BASED ON PAD TYPE, SOIL CONDITION, ETC. FOOTINGS ARE REQUIRED AT SUPPORT POSTS. SEE INSTALLATION MANUAL FOR REQUIREMENTS.

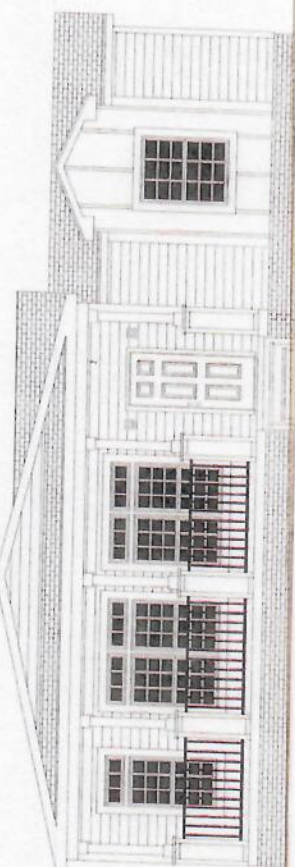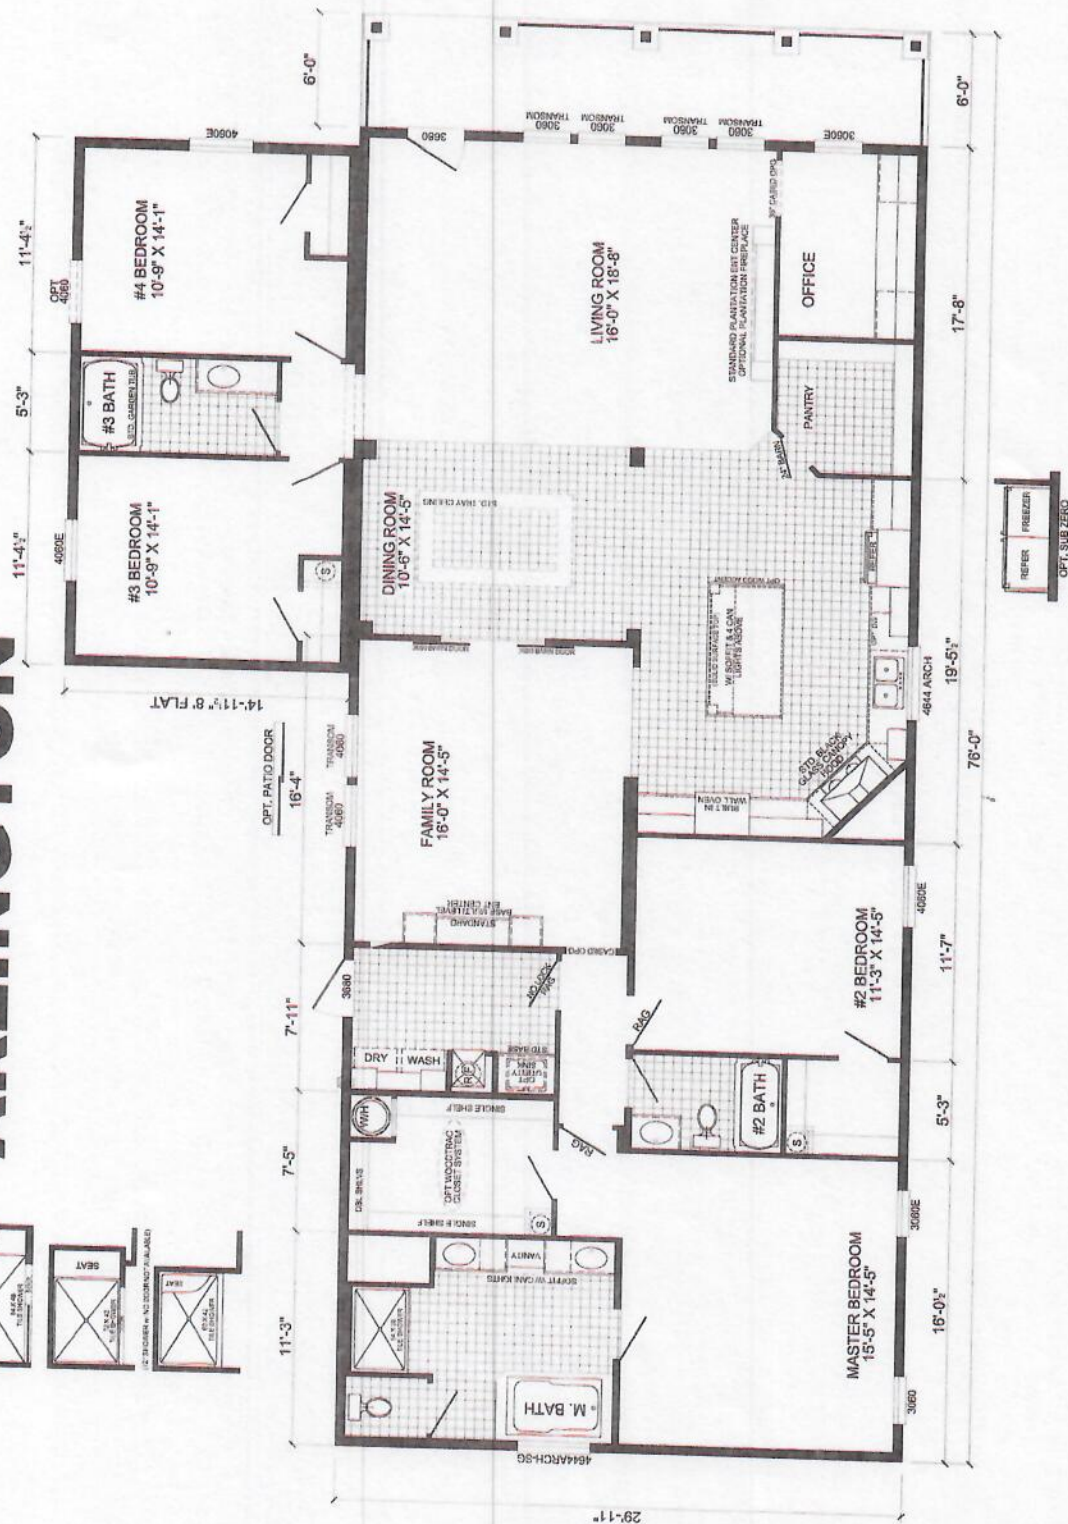

FRONT ELEVATION

4-BEDROOM / 3-BATH

45 X 76 w/ Tag - Approx. 2,514 Sq. Ft.

45 X 76 w/ Tag - Approx. 2,692 Sq. Ft. w/ porch



Date: 05/12/22

All room dimensions include closets and square footage figures are approximate.

Transom Windows are available on optional 9'-0" sidewall houses.
Standard Board and Batton Hardi @ Tower Dormer Location.

Standard Hardi Base Columns w/ Hardi Columns on Top.

Standard Hardi Base Columns w/ Hardi Columns on Top.
Live Oak Homes reserves the right to modify product offering at any time.

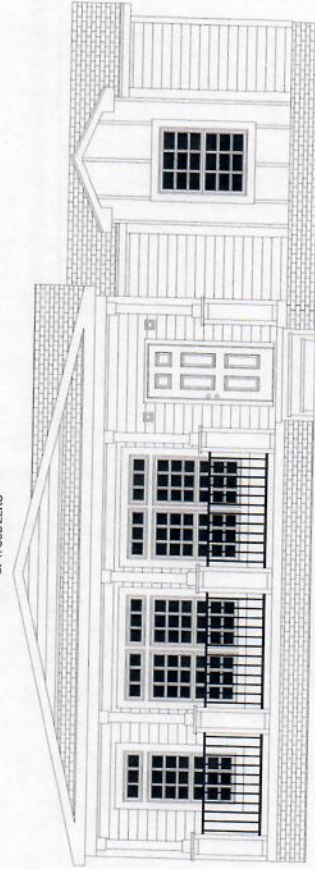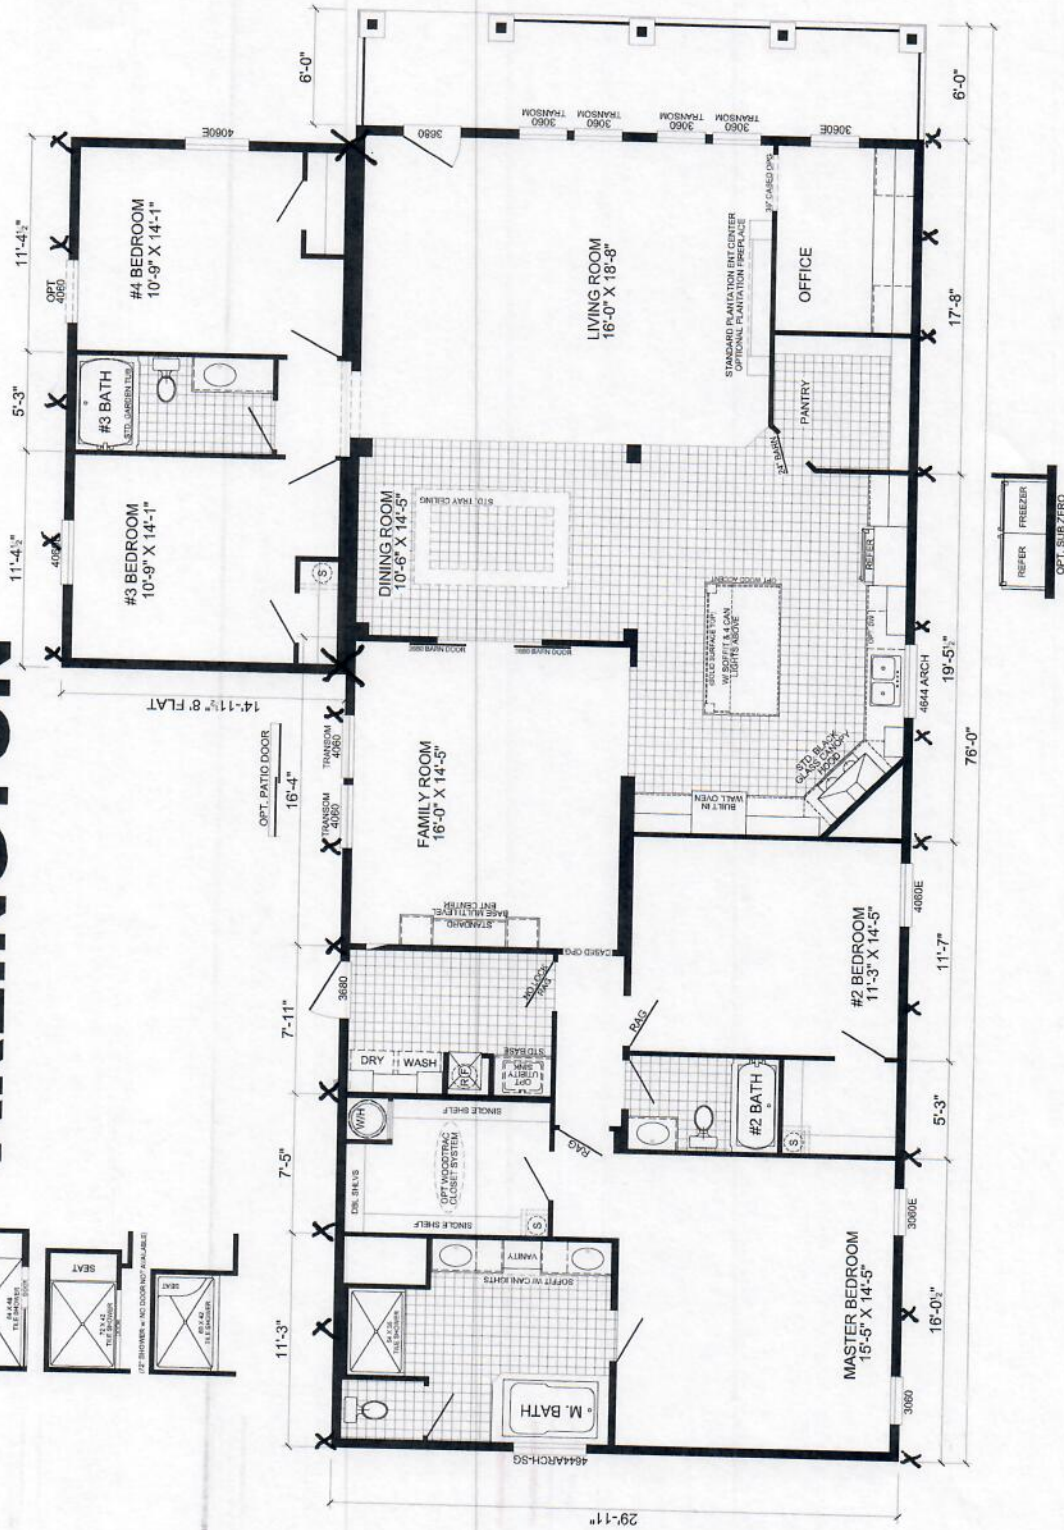

FRONT ELEVATION

4-BEDROOM / 3-BATH

45 X 76 w/ Tag - Approx. 2,514 Sq. Ft.

45 X 76 w/ Tag - Approx. 2,692 Sq. Ft. w/ porch

Date: 05/12/22

- All room dimensions include closets and square footage figures are approximate. Transom windows are available on optional 9'-0" sidewall houses only. Standard Board and Batten Hardi @ Tower Dormer Location. Standard Hardi Base Columns w/ Hardi Columns on Top. Live Oak Homes reserves the right to modify product offering at any time.