

COLUMBIA COUNTY PERMIT WORKSHEET

These worksheets must be completed and signed by the installer. Submit the originals with the packet.

Page 1 of 2

Installer DATE 11/20/04 License # 111204

☐ Used Home ☒ New Home

—

Gr11 Address where
home is being installed
Moonlit Court

Home installed to the Manufacturer's Installation Manual

211 Address where
home is being installed.
Moonlit Court
E. 10th St. - 1000

Home is installed in accordance with RN=15-C

Manufacturer	LYONNE	Length x width	60 x 16
	FOR DUNE # 30038		

Wind Zone I

Manufacturer	Length x width	box 16
Uvex		

Double Wide **Installation Deck** #


NOTE: if home is a single wide fill out one half of the blocking plan

Serial 7# 1046A11415332

if home is a triple or quad wide sketch in remainder of home

[Understand Lateral Arm Systems cannot be used on any home (new or used) where the sidewall ties exceed 5 ft 4 in.

Installer's initials

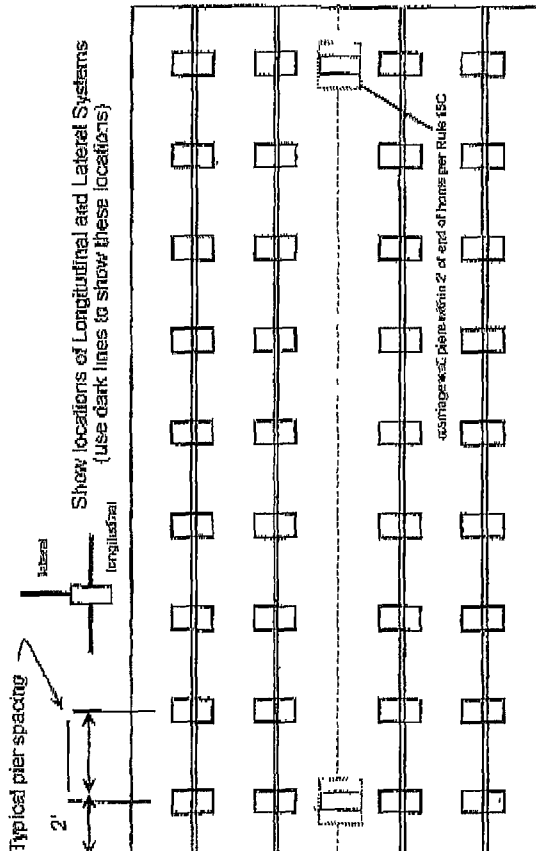

PIER SPACING TABLE FOR USED HOMES

Load bearing capacity	Footer size (sq in.)	18" x 18" (256)	18 1/2" x 18 1/2" (342)	20" x 20" (400)	22" x 22" (484)*	24" x 24" (576)*	28" x 28" (784)
1600 psf	3'	4'	5'	5'	6'	7'	8'
1800 psf	4'	5'	6'	7'	8'	8'	8'
2000 psf	5'	6'	7'	8'	8'	8'	8'
2500 psf	7'	8'	8'	8'	8'	8'	8'
3000 psf	8'	8'	8'	8'	8'	8'	8'
3500 psf	8'	8'	8'	8'	8'	8'	8'

* interpolated from Rule 15C-1 over spacing table.

PER PAGES

Pad Size	Sq in
16 x 16	256
16 x 18	288
18 x 18	324
16 x 22.5	360
17 x 22	374
13 1/4 x 26 1/4	348
26 x 20	400
17 3/16 x 25 3/16	441
17 1/2 x 25 1/2	446
24 x 24	576
26 x 26	676

—geen vier dagen

Perimeter pier pad size

Other pier pad sizes required by the mg :

 Draw the approximate locations of main ledge wall openings 4 foot or greater. Use this symbol to show the piers.

Least all manage wall openings greater than 4 foot and their pier pad sizes below

Legend

Chief Justice

并

45

October 2nd

STRENGTH AND DURABILITY

Longwood Special Services Division

13

Longhurst

Walden

Oliver Technology

OTHER TIES

JOURNAL

Q. 10. Explain the following:

107

James O. Eastman

Summary:

COLUMBIA COUNTY PERMIT WORKSHEET

page 2 of 2

POCKET PENETROMETER TEST

The pocket penetrometer tests are rounded down to 200 psf or check here to declare 1000 lb. soil without testing X

POCKET PENETROMETER TESTING METHOD

1. Test the perimeter of the home at 6 locations.
2. Take the reading at the depth of the footer
3. Using 500 lb. increments, take the lowest reading and round down to that increment.

X X X X

TORQUE PROBE TEST

The results of the torque probe test is 280 inch pounds or check here if you are declaring 5' anchors without testing. A test showing 275 inch pounds or less will require 5 foot anchors.

Note: A state approved lateral arm system is being used and 4 ft. anchors are allowed at the sidewall locations. I understand 5 ft anchors are required at all centerline tie points where the torque test reading is 275 or less and where the mobile home manufacturer may require anchors with 4000 lb holding capacity.

Installer's initials DB

ALL TESTS MUST BE PERFORMED BY A LICENSED INSTALLER

Installer Name Date Hough

Date Tested 4-15-14

Electrical

Connect electrical conductors between multi-wide units, but not to the main power source. This includes the bonding wire between multi-wide units Pg. N/A

Plumbing

Connect all sewer drains to an existing sewer tap or septic tank. Y
Pg. 42
Connect all potable water supply piping to an existing water meter, water tap, or other independent water supply systems. Pg.

Site Preparation

Debris and organic material removed ✓
Water drainage: Natural Swale Pad X Other

Fastening multi wide units

Floor: Type Fastener: Length: Spacing:
Walls: Type Fastener: Length: Spacing:
Roof: Type Fastener: Length: Spacing:
For used homes: 2 min. 30 gauge, 6" wide, galvanized metal strip will be centered over the peak of the roof and fastened with galv routing nails at 2" on center on both sides of the centerline.

Gasket fastening requirements

I understand a properly installed gasket is a requirement of all new and used homes and that condensation, mold, mildew and buckled marriage walls are a result of a poorly installed or no gasket being installed. I understand a strip of tape will not serve as a gasket.

Installer's initials N/A

Type gasket N/A

Installed: Between Floors Yes
Between Walls Yes
Bottom of ridgebeam Yes

Weatherproofing

The bottomboard will be repaired and/or taped Yes
Siding on units is installed to manufacturer's specifications. Yes Yes
Fireplace chimney installed so as not to allow intrusion of rain water Yes


Miscellaneous

Skirting to be installed Yes Yes No
Dryer vent installed outside of skirting. Yes Yes No N/A
Range downflow vent installed outside of skirting. Yes Yes No N/A
Drain lines supported at 4 foot intervals. Yes Yes
Electrical crossovers protected. Yes Yes
Other

Installer verifies all information given with this permit worksheet is accurate and true based on the

Installer Signature Date Hough Date 4-15-14

16X60 - 10W Duct 23X31
 Piece Gas side - 6'12" x 6'
 Anchor 11' on side 8'4" x 6'
 6-Longitudinal Lateral Syth

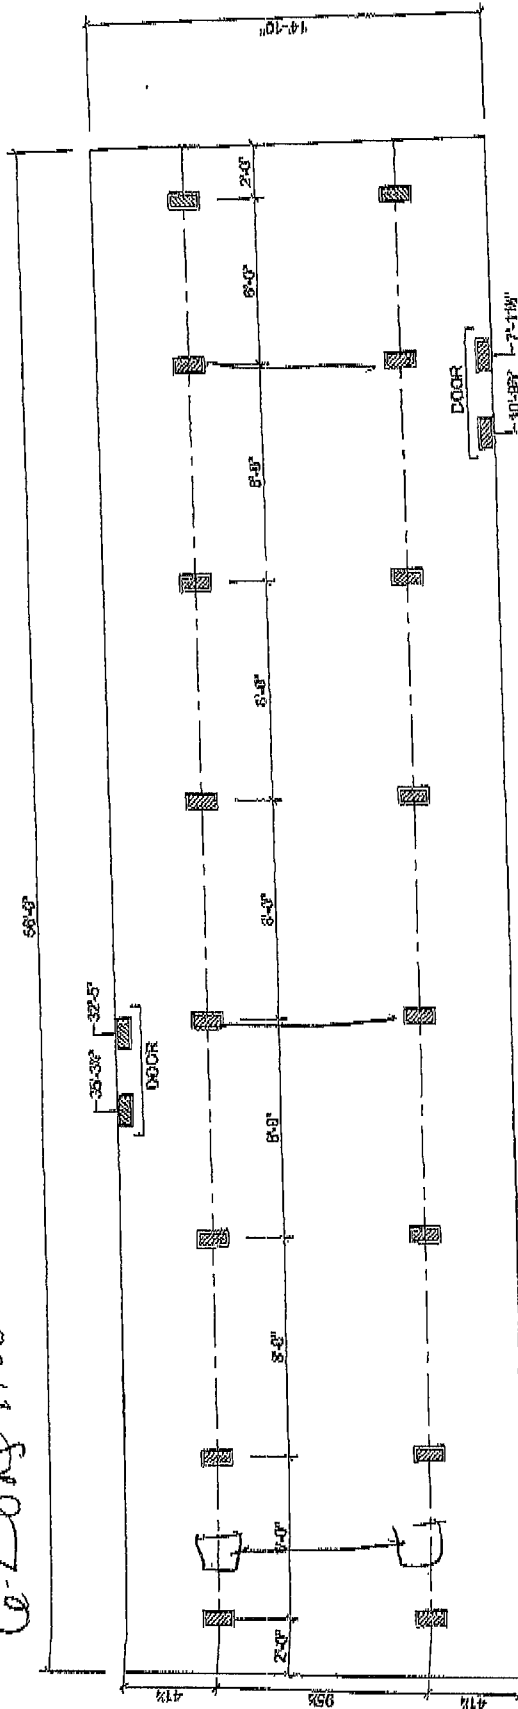

11/23/07

11/23/07

11/23/07

FOUNDATION NOTES:
 - THIS DRAWING IS DESIGNED FOR THE STANDARD WIND ZONE AND IS TO BE USED IN CONJUNCTION WITH THE INSTALLATION MANUAL AND ITS SUPPLEMENTS.
 - FOOTINGS ARE SHOWN FOR EXAMPLE ONLY. QUANTITY AND SPACING MAY VARY BASED ON PAD TYPE, SOIL CONDITION, ETC.
 - FOOTINGS ARE REQUIRED AT SUPPORT POSTS, SEE INSTALLATION MANUAL FOR REQUIREMENTS.

- (A) MAIN ELECTRICAL
 (B) ELECTRICAL CROSSOVER
 (C) WATER INLET
 (D) WATER CROSSOVER (IF ANY)
 (E) GAS INLET (IF ANY)
 (F) GAS CROSSOVER (IF ANY)
 (G) DUCT CROSSOVER
 (H) SENSER DROPS
 (I) RETURN AIR (WOPT. HEAT PUMP OH DUCT)
 (J) SUPPLY AIR (WOPT. HEAT PUMP OH DUCT)

Live Oak Homes
MODEL: S-5562A - 16 X 60
2-BEDROOM / 2-BATH

S-5562A