

Mobile Home Permit Worksheet

Installer: Michael Earnest License # 1H/1121539



Address of home being installed _____

Manufacturer Nobility Length x width 66x28

NOTE: if home is a single wide fill out one half of the blocking plan
if home is a triple or quad wide sketch in remainder of home
I understand Lateral Arm Systems cannot be used on any home (new or used)
where the sidewall ties exceed 5 ft 4 in.

Installer's initials ME

Typical pier spacing

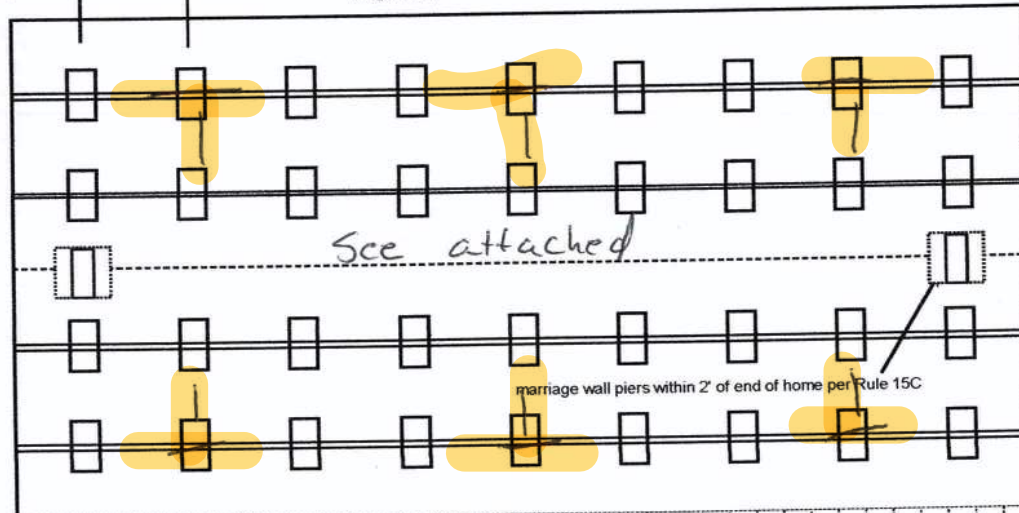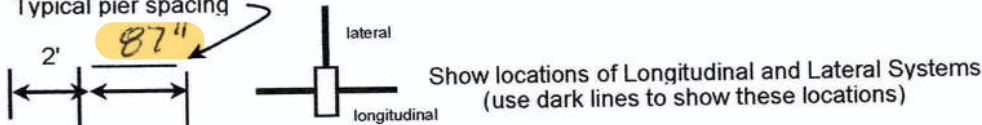

Anthony Islam

08-24-2023

Application Number: _____ Date: _____

New Home ☒ Used Home ☐

Home installed to the Manufacturer's Installation Manual
Home is installed in accordance with Rule 15-C ☒

Single wide ☐ Wind Zone II ☒ Wind Zone III ☐

Double wide ☒ Installation Decal # _____

Triple/Quad ☐ Serial # _____

PIER SPACING TABLE FOR USED HOMES

Load bearing capacity	Footer size (sq in)	16" x 16" (256)	18 1/2" x 18 1/2" (342)	20" x 20" (400)	22" x 22" (484)*	24" X 24" (576)*	26" x 26" (676)
1000 psf		3'	4'	5'	6'	7'	8'
1500 psf		4' 6"	6'	7'	8'	8'	8'
2000 psf		6'	8'	8'	8'	8'	8'
2500 psf		7' 6"	8'	8'	8'	8'	8'
3000 psf		8'	8'	8'	8'	8'	8'
3500 psf		8'	8'	8'	8'	8'	8'

* interpolated from Rule 15C-1 pier spacing table.

PIER PAD SIZES

I-beam pier pad size 17x25
Perimeter pier pad size N/A
Other pier pad sizes (required by the mfg.) 16x16

Draw the approximate locations of marriage wall openings 4 foot or greater. Use this symbol to show the piers.

List all marriage wall openings greater than 4 foot and their pier pad sizes below.

Opening 16x16 Pier pad size See attached
17x25 See attached

TIEDOWN COMPONENTS

Longitudinal Stabilizing Device (LSD) Manufacturer Oliver 1101 V system
Longitudinal Stabilizing Device w/ Lateral Arms Manufacturer Oliver 1101 V system
Sidewall Longitudinal Marriage wall Shearwall

POPULAR PAD SIZES

Pad Size	Sq In
16 x 16	256
16 x 18	288
18.5 x 18.5	342
16 x 22.5	360
17 x 22	374
13 1/4 x 26 1/4	348
20 x 20	400
17 3/16 x 25 3/16	441
17 1/2 x 25 1/2	446
24 x 24	576
26 x 26	676

ANCHORS

4 ft ☒ 5 ft ☒

FRAME TIES

within 2' of end of home spaced at 5' 4" oc

OTHER TIES

Number 5.4"
N/A
Per Factory

Mobile Home Permit Worksheet

Application Number: _____ Date: _____

POCKET PENETROMETER TEST

The pocket penetrometer tests are rounded down to 1500 psf or check here to declare 1000 lb. soil without testing.

x 1500 x 1700 x 1500

POCKET PENETROMETER TESTING METHOD

1. Test the perimeter of the home at 6 locations.
2. Take the reading at the depth of the footer.
3. Using 500 lb. increments, take the lowest reading and round down to that increment.

x 1500 x 1500 x 1500

TORQUE PROBE TEST

The results of the torque probe test is 285 inch pounds or check here if you are declaring 5' anchors without testing. A test showing 275 inch pounds or less will require 5 foot anchors.

Note: A state approved lateral arm system is being used and 4 ft. anchors are allowed at the sidewall locations. I understand 5 ft anchors are required at all centerline tie points where the torque test reading is 275 or less and where the mobile home manufacturer may requires anchors with 4000 lb holding capacity.

ME Installer's initials

ALL TESTS MUST BE PERFORMED BY A LICENSED INSTALLER

Installer Name Michael Ernest
Date Tested 8-1-23

Electrical

Connect electrical conductors between multi-wide units, but not to the main power source. This includes the bonding wire between multi-wide units. Pg. 44

Plumbing

Connect all sewer drains to an existing sewer tap or septic tank. Pg. 43

Connect all potable water supply piping to an existing water meter, water tap, or other independent water supply systems. Pg. 45



Site Preparation

Debris and organic material removed
Water drainage: Natural Swale Pad Other

Fastening multi wide units

Floor: Type Fastener: lags Length: 5' Spacing: 18"
Walls: Type Fastener: screws Length: 4' Spacing: 20"
Roof: Type Fastener: metal Length: 66' Spacing: 2"
For used homes a min. 30 gauge, 8" wide, galvanized metal strip will be centered over the peak of the roof and fastened with galv. roofing nails at 2" on center on both sides of the centerline.

Gasket (weatherproofing requirement)

I understand a properly installed gasket is a requirement of all new and used homes and that condensation, mold, mildew and buckled marriage walls are a result of a poorly installed or no gasket being installed. I understand a strip of tape will not serve as a gasket.

Installer's initials ME

Type gasket Beam from Factory Installed:
Pg. 14 Between Floors Yes ☒
Between Walls Yes ☒
Bottom of ridgebeam Yes ☒

Weatherproofing

The bottomboard will be repaired and/or taped. Yes ☒ Pg.
Siding on units is installed to manufacturer's specifications. Yes ☒
Fireplace chimney installed so as not to allow intrusion of rain water. Yes ☒

Miscellaneous


Skirting to be installed. Yes ☒ No
Dryer vent installed outside of skirting. Yes ☒ N/A
Range downflow vent installed outside of skirting. Yes ☒ N/A
Drain lines supported at 4 foot intervals. Yes ☒
Electrical crossovers protected. Yes ☒
Other: _____

Installer verifies all information given with this permit worksheet is accurate and true based on the manufacturer's installation instructions and or Rule 15C-1 & 2

Installer Signature Michael Ernest Date 8-14-23



Soil bearing 1500
 using 17x25 abs pad under I-beam
 87" o.c.
 Oliver 1101 v system
 using 4x5' anchors on roads
 over 3150#

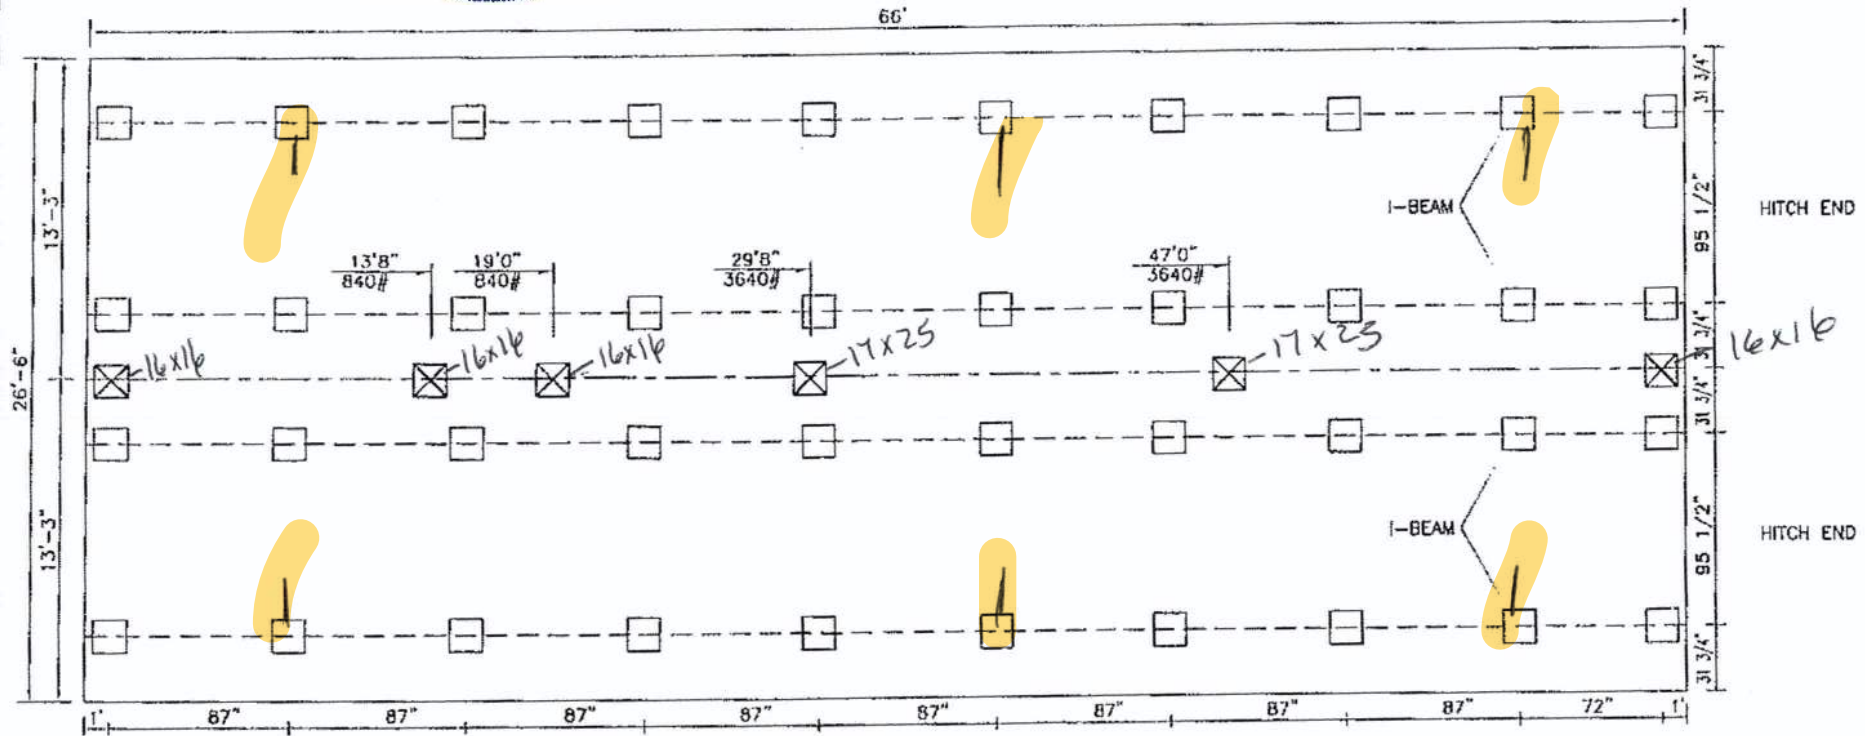

- NOTES: (1. COLUMN SUPPORT PIERS MAY BE WITHIN 8" OF OPENINGS GREATER THAN 48"
- (2. ADDITIONAL PIERS ARE REQUIRED AT EACH SIDE OF EXTERIOR DOOR OPENINGS.
- (3. THIS IS A TYPICAL DRAWING FOR THIS MODEL. SPACING MAY BE DIFFERENT IF MAX. SPACING IS NOT EXCEEDED.


- ☒ COLUMN SUPPORT PIERS
- 17 1/2" X 25 1/2" BASE PAD

SPACING FOR 1500 PSF SOIL WITH 17 1/2" X 25 1/2" BASE PAD
 MAXIMUM SPACING FOR THE I-BEAM PIERS IS 87"

 NOBILITY HOMES, INC. Ocala, Florida	1	3	REVISIONS DWG by: RITENOUR DATE SCALE	PRINT NUMBER 66E4D(13)
	2	4		

Prestige Home Centers

BRANDON OPT. KIT

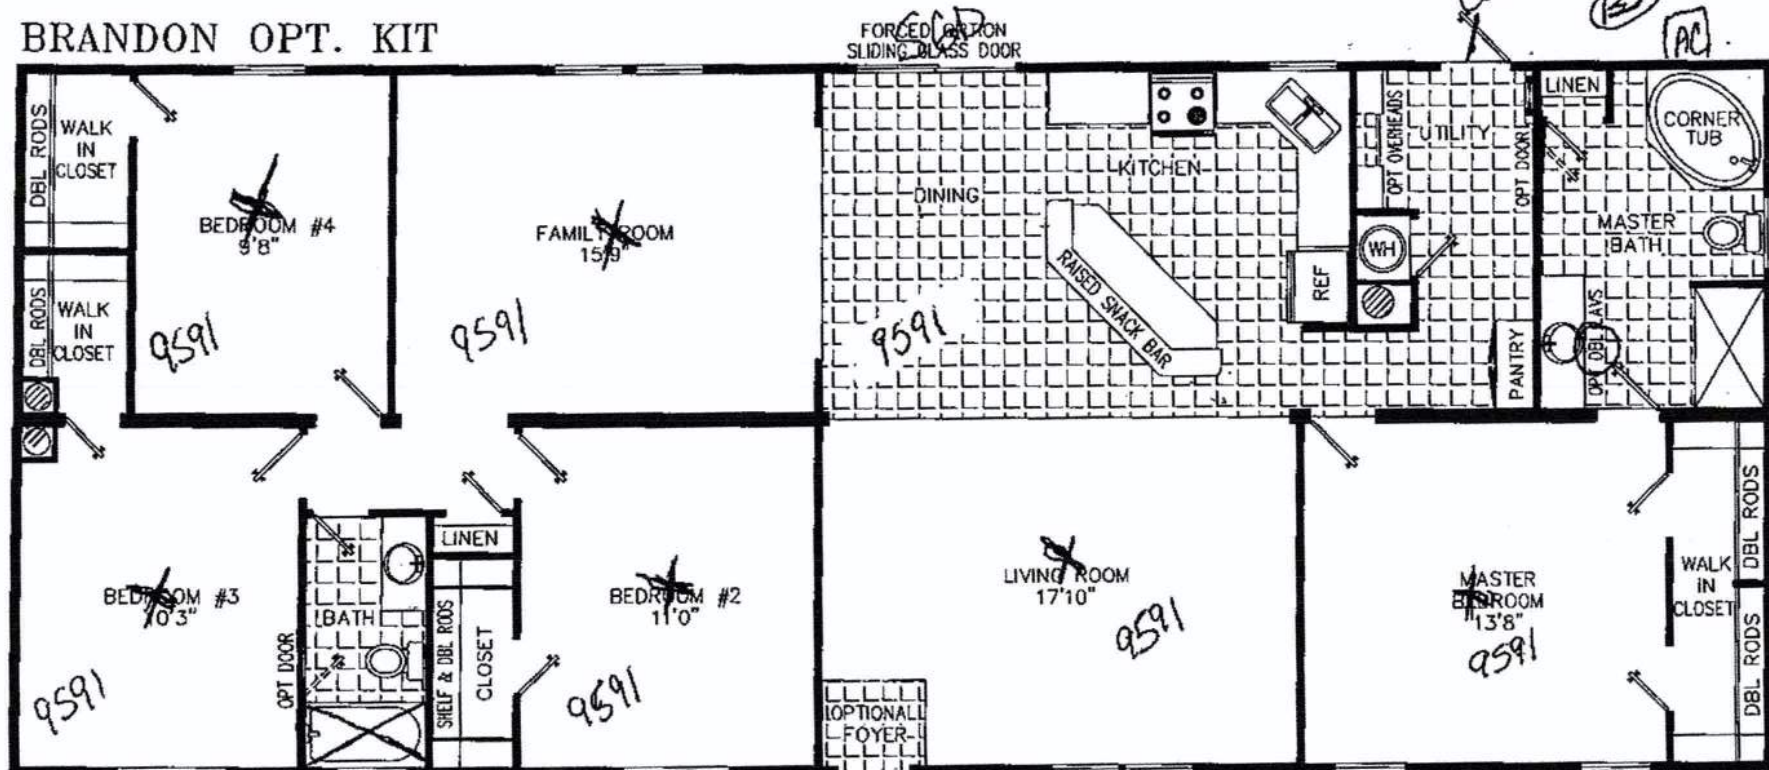


66' MB (28' OSR) 4 BR, 2 BATH, FAMILY ROOM 66E4D(13) 1749 SQ. FT. CATHEDRAL CEILING THROUGHOUT

X Brenda Lemna
X Meredith Summers

**Homes Designed, Built & Serviced
 By NOBILITY HOMES**



MANUFACTURED IN ACCORDANCE WITH STANDARDS DEVELOPED AND ENFORCED BY HUD. DUE TO OUR CONTINUING PROGRAM OF PRODUCT IMPROVEMENT, PRICES AND SPECIFICATIONS ARE SUBJECT TO CHANGE WITHOUT NOTICE. SOME ITEMS SUCH AS TIRES, RIMS, AXLES AND HITCHES MAY HAVE BEEN RECYCLED AFTER INSPECTION FOR SAFETY AND APPEARANCE. ALL DIMENSIONS ARE NOMINAL.

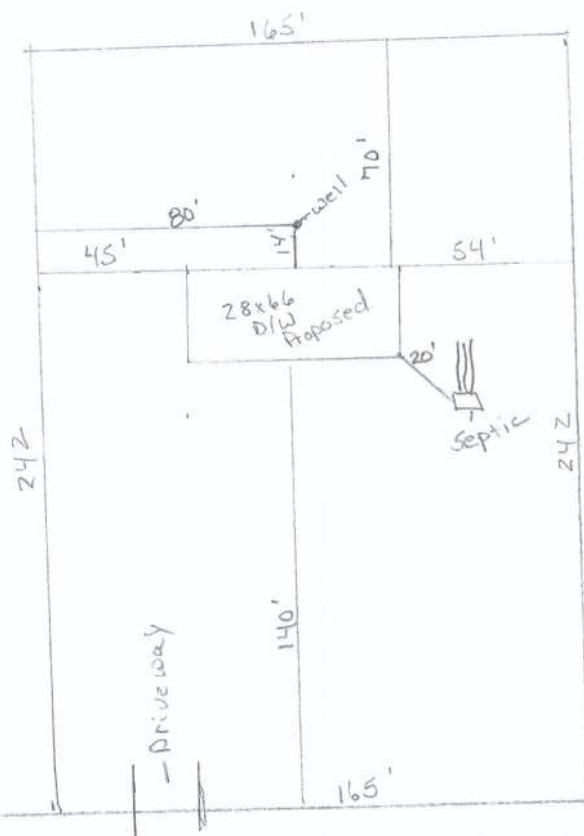

10-4S-16-02897-008
 Summers
 TBD Sunset Way
 Lake City, FL 32024
 Scale 1" = 60'
 Michael Earnest