

COLUMBIA COUNTY PERMIT WORKSHEET

page 1 of 2

These worksheets must be completed and signed by the installer.
Submit the originals with the packet.

Installer Bernie Thrift License # 1H1025155



911 Address where home is being installed 4117 SW Mayo Road
Lake City FL 32024

Manufacturer Destiny Length x width 48' x 24'

NOTE: If home is a single wide fill out one half of the blocking plan
If home is a triple or quad wide sketch in remainder of home

I understand Lateral Arm Systems cannot be used on any home (new or used) where the sidewall ties exceed 5 ft 4 in.

Installer's initials BT

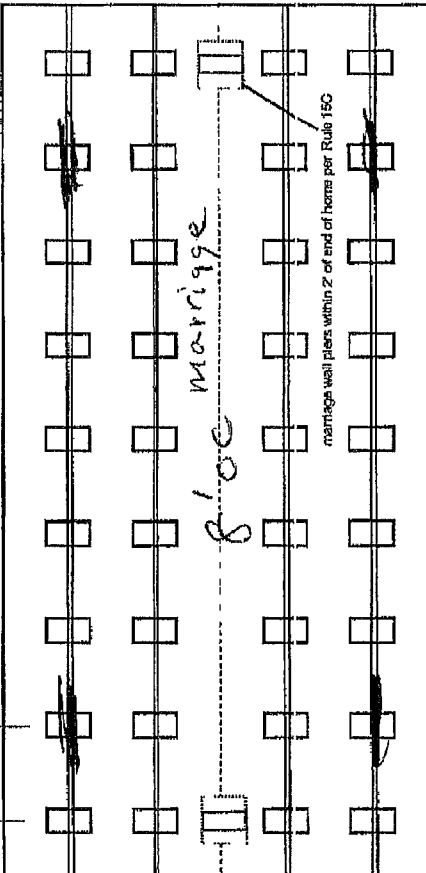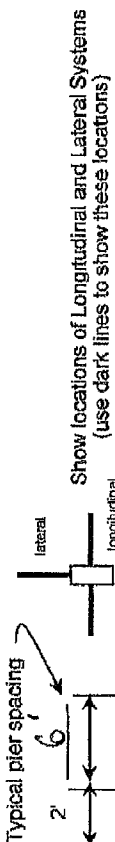

New Home ☐ Used Home ☒

Home installed to the Manufacturer's Installation Manual ☐

Home is installed in accordance with Rule 15-C ☒

Single wide ☐ Wind Zone II ☒ Wind Zone III ☐

Double wide ☒ Installation Decal # 16758

Triple/Quad ☐ Serial # 8327

PIER SPACING TABLE FOR USED HOMES

Load bearing capacity	Footer size (sq in)	16" x 16" (256)	18 1/2" x 16 1/2" (342)	20" x 20" (400)	22" x 22" (484)	24" x 24" (576)	26" x 26" (676)
1000 psf	3'	4'	4'	5'	6'	7'	8'
1500 psf	4'	5'	6'	7'	8'	9'	10'
2000 psf	5'	6'	7'	8'	9'	10'	11'
2500 psf	6'	7'	8'	9'	10'	11'	12'
3000 psf	7'	8'	9'	10'	11'	12'	13'
3500 psf	8'	9'	10'	11'	12'	13'	14'

* Interpolated from Rule 15C-1 pier spacing table.

PIER PAD SIZES

I-beam pier pad size 17 x 22

Perimeter pier pad size 16 x 16

Other pier pad sizes (required by the mfg.) _____

Draw the approximate locations of marriage wall openings 4 foot or greater. Use this symbol to show the piers.

List all marriage wall openings greater than 4 foot and their pier pad sizes below

Opening 10' Pier pad size 17 x 22

FRAME TIES

within 2' of end of home ☒ spaced at 5' 4" oc

TIEDOWN COMPONENTS

Longitudinal Stabilizing Device (LSD)
Manufacturer 11012 01122

Longitudinal Stabilizing Device w/ Lateral Arms
Manufacturer _____

OTHER TIES

Number _____

Sidewall _____

Longitudinal _____

Marriage wall _____

Shearwall _____

43

COLUMBIA COUNTY PERMIT WORKSHEET

page 2 of 2

POCKET PENETROMETER TEST	
The pocket penetrometer tests are rounded down to <u>200</u> psf or check here to declare 1000 lb soil <u>without</u> testing	
X <u>2000</u>	X <u>2500</u>
X <u>2000</u>	X <u>2000</u>

POCKET PENETROMETER TESTING METHOD

1. Test the perimeter of the home at 6 locations
2. Take the reading at the depth of the footer
3. Using 500 lb. increments, take the lowest reading and round down to that increment

TORQUE PROBE TEST	
The results of the torque probe test is <u>290</u> inch pounds or check here if you are declaring 5' anchors without testing <u>without</u> testing. A test showing 275 inch pounds or less will require 5 foot anchors.	
X <u>2500</u>	X <u>2000</u>
X <u>2000</u>	X <u>2000</u>

Note: A state approved lateral arm system is being used and 4 ft. anchors are allowed at the sidewall locations. I understand 5 ft. anchors are required at all centerline tie points where the torque test reading is 275 or less and where the mobile home manufacturer may require anchors with 4000 lb holding capacity

Installer's initials BT

ALL TESTS MUST BE PERFORMED BY A LICENSED INSTALLER

Installer Name Bernie Thrift

Date Tested 6-28-13

Site Preparation	
Debris and organic material removed <u>✓</u>	
Water drainage: Natural <u>✓</u> Swale <u> </u> Pad <u> </u> Other <u> </u>	

Fastening multi wide units	
Floor: Type Fastener <u>3/8 Lag</u> Length <u>7'</u> Spacing <u>24"</u>	
Walls: Type Fastener <u>8" Sdw</u> Length <u>18"</u> Spacing <u>18"</u>	
Roof: Type Fastener <u>Flashing</u> Length <u>8' x 2'</u> Spacing <u>50'</u>	

For used homes a min. 30 gauge, 8" wide, galvanized metal strip will be centered over the peak of the roof and fastened with galv. roofing nails at 2' on center on both sides of the centerline.

Gasket (weatherproofing requirement)	
I understand a properly installed gasket is a requirement of all new and used homes and that condensation, mold, mildew and buckled marriage walls are a result of a poorly installed or no gasket being installed. I understand a strip of tape will not serve as a gasket.	
Type gasket <u>Seam Seal</u>	Installer's initials <u>BT</u>
Pg <u>12</u>	Installed
	Between Floors Yes <u>✓</u>
	Between Walls Yes <u>✓</u>
	Bottom of ridgebeam Yes <u>✓</u>

Weatherproofing	
The bottomboard will be repaired and/or taped. Yes <u>✓</u> Pg <u>12</u>	
Siding on units is installed to manufacturer's specifications. Yes <u>✓</u>	
Fireplace chimney installed so as not to allow intrusion of rain water. Yes <u>✓</u>	

Miscellaneous	
Skirting to be installed. Yes <u> </u> No <u> </u>	
Dryer vent installed outside of skirting Yes <u> </u> No <u> </u>	
Range downflow vent installed outside of skirting Yes <u> </u> No <u> </u>	
Drain lines supported at 4 foot intervals. Yes <u> </u> No <u> </u>	
Electrical crossovers protected Yes <u> </u> No <u> </u>	
Other <u> </u>	

Installer verifies all information given with this permit worksheet is accurate and true based on the

Installer Signature Bernie Thrift Date 7-1-13

Electrical

Plumbing

Connect electrical conductors between multi-wide units, but not to the main power source. This includes the bonding wire between multi-wide units. Pg. 5

Connect all sewer drains to an existing sewer tap or septic tank. Pg. 5

Connect all potable water supply piping to an existing water meter, water tap, or other independent water supply systems. Pg. 5