

LAKE CITY, FL


US-90 & PRICE CREEK ROAD LAKE CITY, FLORIDA

11.06.2023

ACTUAL FIRE SEPARATION

Motor Vehicle Repair Garage 311.2

TOTAL OCCUPANTS

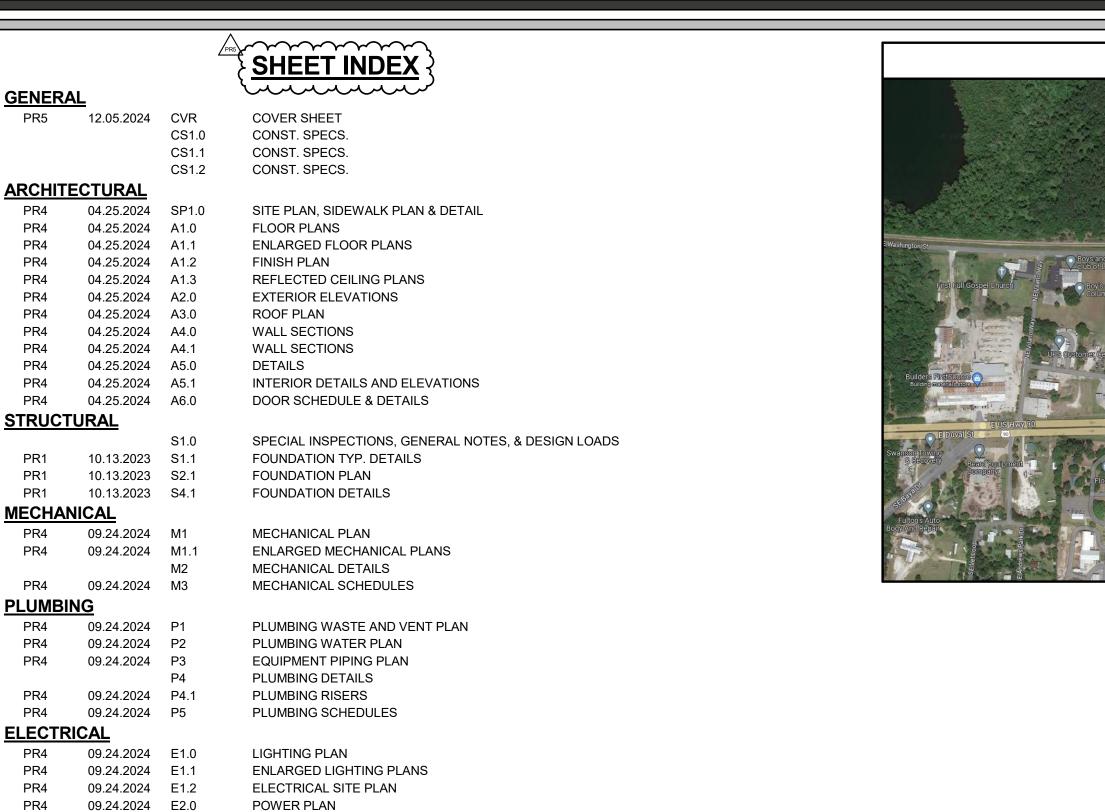



<u>)</u> .	THE CONTRACTOR SHALL THOROUGHLY EXAMINE ALL FACTORS REASONABLY AVAILABLE TO HIM INCLUDING, BUT NOT LIMITED TO, THE PLANS, SPECIFICATIONS, SITE BOUNDARY, TOPOGRAPHY, SITE CONDITIONS, SITE HISTORY, LOCAL INFORMATION, AND SEASONAL WEATHER CONDITIONS IN THE PREPARATION OF HIS BID. THE CONTRACTOR SHALL BE TOTALLY RESPONSIBLE FOR ACCEPTANCE OF THE SITE AND PREPARATION OF THE SITE TO THE PROPER GRADE AND COMPACTION REQUIREMENTS AS INDICATED BY THE PLANS AND SPECIFICATIONS. ANY CONSTRUCTION PERFORMED BY THE CONTRACTOR ON THE PROJECT WILL CONSTITUTE ACCEPTANCE OF THE SITE. ANY CONSTRUCTION PERFORMED BY THE CONTRACTOR ON A BUILDING PAD PREPARED BY OTHERS WILL CONSTITUTE ACCEPTANCE OF THE PAD.	
.	EACH SUBCONTRACTOR IS RESPONSIBLE FOR HAVING A THOROUGH KNOWLEDGE OF ALL DRAWINGS AND SPECIFICATIONS IN THEIR RELATED AREA. THE FAILURE TO ACQUAINT THEMSELVES WITH THIS KNOWLEDGE DOES NOT RELIEVE THEM OF ANY RESPONSIBILITY OF PERFORMING THEIR WORK PROPERLY. NO ADDITIONAL COMPENSATION SHALL BE ALLOWED BECAUSE OF CONDITIONS THAT OCCUR DUE TO FAILURE TO FAMILIARIZE WORKERS WITH THIS KNOWLEDGE.	
	THE CONTRACTOR SHALL KEEP THE CONSTRUCTION AREA FREE AND CLEAR OF ALL DEBRIS. NO FLAMMABLE MATERIALS/LIQUIDS MAY BE STORED IN THE BUILDING DURING CONSTRUCTION.	
).	BUILDING AND SITE SECURITY SHALL BE MAINTAINED DURING CONSTRUCTION. SECURITY WILL BE THE RESPONSIBILITY OF THE GENERAL CONTRACTOR.	ŀ
ì.	DURING CONSTRUCTION, THE CONTRACTOR SHALL COORDINATE THE LOCATION OF ANY REQUIRED SAFETY BARRIERS OR BARRICADES. PROVIDE BARRICADES SO AS TO PREVENT PUBLIC INTRUSION INTO CONSTRUCTION AREAS.	
.	THE CONTRACTOR SHALL SUPPLY AND INSTALL MISCELLANEOUS BLOCKING, FURRING, NAILERS, GROUNDS, FRAMING AND SHEATHING AS DETAILED ON THE DRAWINGS, AND AS REQUIRED FOR PROPER INSTALLATION OF EQUIPMENT AND ACCESSORIES SUCH AS THE FOLLOWING: BASE CABINETS, TOILET PARTITIONS, MIRRORS, TOILETS ACCESSORIES, MECHANICAL AND ELECTRICAL EQUIPMENT, ETC. COORDINATE TO ALLOW PROPER ATTACHMENT OF WORK OF EACH TRADE. CAUTION: USE FIRE-TREATED WOOD IN AREAS REQUIRING RATED OR NONCOMBUSTIBLE CONSTRUCTION, USE TREATED WOOD IN AREAS IN CONTACT WITH MASONRY, CONCRETE, OR WHERE SUBJECT TO MOISTURE.	
3.).	ALL MATERIALS ARE TO BE INSTALLED PER MANUFACTURERS RECOMMENDATIONS AND IN A MANNER SUCH THAT ALL MANUFACTURERS WARRANTIES WILL BE HONORED. REMOVED.	

GENERAL CONSTRUCTION REQUIREMENTS

ALL WORK SHALL BE DONE IN A SAFE AND PROFESSIONAL MANNER AND IN STRICT ACCORDANCE WITH ALL APPLICABLE LOCAL GOVERNING CODES, REGULATIONS, AND ORDINANCES HAVING JURISDICTION

10. FIRE EXTINGUISHERS SHALL BE FURNISHED BY EQUIPMENTSHARE AND INSTALLED BY CONTRACTOR IN ACCORDANCE WITH NFPA 10. (1) 2A-10B/C MININ EACH 3,000 S.F. OF FLOOR AREA, LOCATED SUCH THAT TRAVEL DISTANCE TO CLOSEST UNIT IS NO MORE THAN 75 FEET. CLASS K EXTINGUISHERS SHA EXTINGUISHER LOCATIONS SHALL BE APPROVED BY THE OFFICE OF THE FIRE MARSHAL PRIOR TO OCCUPANCY. FIRE EXTINGUISHERS ARE TO BE MOUNTAIN MAXIMUM. COORDINATE LOCATIONS WITH EQUIPMENTSHARE AND OBTAIN AUTHORIZATION PRIOR TO INSTALLATION.	LL BE PROVIDED WITHIN 30 FT OF ALL COOKING AREAS. FIRE

ABBR	DEFINITION	ABBR	DEFINITION	ABBR	DEFINITION
AB	ANCHOR BOLT	FTG	FOOTING	PL	PLATE
ACI	AMERICAN CONCRETE INSTITUTE	FV	FIELD VERIFY	PLAM	PLASTIC LAMINATE
ACRYL	ACRYLIC	GA	GAUGE	PLAST	PLASTIC
ADA	AMERICANS WITH DISABILITIES ACT	GC	GENERAL CONTRACTOR	PLF	POUNDS PER LINEAR FOOT
ADJ	ADJACENT	GM	GENERAL MERCHANDISE	PMEJ	PREMOLDED EXPANSION JOINT
AFF	ABOVE FINISHED FLOOR	GR	GROCERY	PSF	POUNDS PER SQUARE FOOT
AFG	ABOVE FINISHED GRADE	GYP	GYPSUM BOARD	PSI	POUNDS PER SQUARE INCH
AISC	AMERICAN INSTITUTE OF STEEL CONSTRUCTION	GWB	GYPSUM WALL BOARD	PVC	POLYVINYL CHLORIDE
ARCH	ARCHITECTURAL	Н	HEIGHT	QTY	QUANTITY
ASTM	AMERICAN SOCIETY OF TESTING AND MATERIALS	HDTV	HIGH DEFINITION TELEVISION	RC	REFRIGERATION CONTRACTOR
AWS	AMERICAN WELDING SOCIETY	HORIZ	HORIZONTAL	REF	REFER TO
BFF	BELOW FINISHED FLOOR	HSA	HEADED STUD ANCHOR	REINF	REINFORCING
BL	BLOCK LINTEL	HSS	HOLLOW STRUCTURAL SECTION	REQD	REQUIRED
ВО	BOTTOM OF	INFO	INFORMATION	REV	REVERSE
BOS	BOTTOM OF STEEL	ISO	ISOLATION	RO	ROUGH OPENING
BRG	BEARING	JBE	JOIST BEARING ELEVATION	RTU	ROOF TOP UNIT
CJ	CONTROL JOINT	JST	JOIST	RXPFC	PHARMACY PAINT FIX CLEAN
CL	CENTERLINE	JT	JOINT	SCB	SANITARY COVE BASE
CLR	CLEAR	KSI	KIPS PER SQUARE INCH	SCHED	SCHEDULE
CMU	CONCRETE MASONRY UNIT	L	LENGTH	SDI	STEEL DECK INSTITUTE
COL	COLUMN	LB	POUNDS	SIM	SIMILAR
CONC	CONCRETE	LLH	LONG LEG HORIZONTAL	SJI	STEEL JOIST INSTITUTE
CONST	CONSTRUCTION	LLV	LONG LEG VERTICAL	SPECS	SPECIFICATIONS
CONT	CONTINUOUS	LONG	LONGITUDINAL	SS	STAINLESS STEEL
CU	CONDENSING UNIT	MAX	MAXIMUM	STD	STANDARD
DIA	DIAMETER	MAU	MECHANICAL AIR UNIT	STRUC	STRUCTURAL
DSD	DIRECTS SHIPPING DELIVERY	ME	MASONRY ELEVATION	T&B	TOP AND BOTTOM
EAS	ELECTRONIC ARTICLE SURVEILLANCE	MECH	MECHANICAL	TEMP	TEMPERED
EDC	ELECTRICAL DISTRIBUTION CENTER	MFR	MANUFACTURER	THK	THICKNESS
EIFS	EXTERIOR INSULATION AND FINISH SYSTEM	MIN	MINIMUM	ТО	TOP OF
EF	EXHAUST FAN	MISC	MISCELLANEOUS	TOC	TOP OF CONCRETE
EJ	EXPANSION JOINT	MO	MASONRY OPENING	TOF	TOP OF FOOTING
EL	ELEVATION	MTL	METAL	TOGB	TOP OF GRADE BEAM
ELEC	ELECTRICAL	NIC	NOT IN CONTRACT	TOM	TOP OF MASONRY
EQ	EQUAL	NO	NUMBER	TOP	TOP OF PURLIN
ETR	EXISTING TO REMAIN	NS	NEAR SIDE	TOS	TOP OF STEEL
EW	EACH WAY	NTS	NOT TO SCALE	TRANS	TRANSVERSE
EWC	ELECTRIC WATER COOLER		ON CENTER	TYP	TYPICAL
FDN	FOUNDATION	OD	OUTSIDE DIAMETER	UNO	UNLESS NOTED OTHERWISE
FF	FINISHED FLOOR	ОН	OPPOSITE HAND	VERT	VERTICAL
FRP	FIBER REINFORCED PLASTIC	PAF	POWDER ACTUATED FASTENER	W	WIDTH

SYMBOLS LEGEND						
ROOM NAME AND NUMBER	DOOR NUMBER	WINDOW TYPE	HEIGHT ELEVATION INDICATOR			
OFFICE [101]	101	⟨ A ⟩	100'-0" FF EL			
GRID NUMBER	PAINT COLOR INDICATOR	ELEVATION	PLAN ELEVATION INDICATOR			
	MP-2	1 A2.0	100.00'			
PARTITION TYPE	ENLARGED PLAN/DETAIL	SECTION	EQUIPMENT NUMBER			
A6	1 A4.1	1 A4.0	<u>01</u>			

PCF POUNDS PER CUBIC FOOT

PROJECT	CONTACT	LIST:

Architecture Contact: Amy Miles: (479) 878-3510 amy.miles@pb2ae.com Scott Broadbent AIA: scott.broadbent@pb2ae.com pb2 architecture + engineering Rogers, AR 72758

MEP Engineering Contacts: Brandon Hampton PE: (mech/plumb) brandon.hampton@pb2ae.com Tommy Johnson: (elec) tommy.johnson@pb2ae.com pb2 architecture + engineering 4886 W Pauline Whitaker Pkwy. Ste. 200 4886 W Pauline Whitaker Pkwy. Ste. 200

Rogers, AR 72758

Structural Engineering (foundation): Tatum Smith Welcher Engineers, Inc. 3100 S. Market St. Suite 202 Rogers, AR 72758

APPLICABLE CODES							
	JURISDICTION						
Age	ency		L	ocation			
CODE ENFORCEMENT	City of Lake City	City of Lake City					
ZONING	City of Lake City	City of Lake City					
CODE	TITLE	EDITION	AMENDMENTS	NOTES			
BUILDING	FL Building Code 7th Ed.	2023	-				
FIRE	FL Fire Code 7th Ed.	2020	-	-			
ACCESSIBILITY	FL Building Code 7th Ed.	2020	-	-			
MECHANICAL	FL Mech. Code 7th Ed.	2020	-				
ELECTRICAL	NEC {	2020	-				
PLUMBING	FL Plumbing Code 7th Ed.	2020	-				
ENERGY	FL Energy Code	2020	-				
LIFE SAFETY	NFPA 101	2021	-				

CONSTRUCTION TYPE AND LIMITATIONS

ONSTRUCTION TYPE (Chapter 6):	, IIB	PRIMARY OCCUPANCY	/ ·	S1 - STORAGE
UTOMATIC FIRE SPRINKLER SYSTEM	PR4 NO	BUILDING AREA LIMITA	TIONS	AREA (SF)
LLOWABLE HEIGHT	3	ALLOWABLE AREA		17,500 (SF)
LLOWABLE HEIGHT INCREASE (W/SPRINKLERS)	1	UNLIMITED AREA BUIL	DING? (Section 507)	NO
OTAL ALLOWABLE HEIGHT	PRS 4	TOTAL ALLOWABLE A	REA	17,500 (SF)
CTUAL HEIGHT	1	ACTUAL BUILDING AR	EA	10488 (SF)
	FIRE RESIS	TANCE RATINGS		
UILDING COMPONENT	RATINGS (HOURS)	DESIGN NO.	NOTES	
TRUCTURAL FRAME	0	-	Table 601	
EARING WALLS: EXTERIOR	0	-	Table 601	
FARING WALLS: INTERIOR	0	_	Table 601	

UILDING COMPONENT	RATINGS (HOURS)	DESIGN NO.	NOTES
STRUCTURAL FRAME	0	-	Table 601
BEARING WALLS: EXTERIOR	0	-	Table 601
BEARING WALLS: INTERIOR	0	-	Table 601
NONBEARING WALLS: EXTERIOR	0	-	Table 601
NONBEARING WALLS: INTERIOR	0	-	Table 601
FLOOR CONSTRUCTION	0	-	Table 601
ROOF CONSTRUCTION	0	-	Table 601
CORRIDORS	0	-	Section 1018

MINIMUM FIRE SEPARATION

10' +

USE AND OCCUPANCY CLASSIFICATION

S1 - STORAGE

FACTOR

(Inches per Occupant)

MINIMUM FIRE RESISTANCE RATING

PRIMARY USE:

CLASSIFICATION

PLUMBING FIXTURE COUNTS (IPC Table 403.01)

(PLUMBING FIXTURE NOT SHOWN WILL BE PROVIDED WITH TENANT INFILL PACKAGES)

(Chapter 3)


S1 - STORAGE

	ACCESSORY USES:		B - BUSINESS		Business Operation Areas - Services - Section 304.1
		USE A	ND OCCUPANCY CLA	ASSIFICATION AND I	_OAD (Chapter 3)
	CLASSIFICATION (Chapter 3)	AREA (SF)	FACTOR (SF per Occupant)	LOAD (Occupants)	NOTES
	S1 - STORAGE	9164 SF	300 SF	PR4 32	Shop and Other Vocational Room Areas - Table 1004.1.2
	B - BUSINESS	1324 SF	150 SF	9 3	Business Operation Areas - Table 1004.1.2
-(TOTAL	10488 SF	-	41	Total Occupiable Space
			EGRESS I	NCHES REQUIRED	
	1				

(B - BUSINESS	9 5	0.2	1.8					
	TOTAL	41	-	8	181" PROVIDED				
	FLAME SPREAD CLASS (Walls and Ceilings)								
	EXIT PASSAGEWAYS		-		Table 803.9				
	CORRIDORS		-		Table 803.9				
	ROOMS AND ENCLOSED	SPACE	-		Table 803.9				

INCHES REQUIRED

(
		REC	QUIRED	PRO	/IDED
FIXTURE HEIGHT	DETERMINING FACTOR	MALE	FEMALE	MALE	FEMALE
WATER CLOSETS	100	1	1	2	2
URINALS	50%	1	-	-	-
LAVATORIES	100	1	1	2	2
UNISEX	1 PER 6+ WC		1		1
SERVICE SINK	1 REQUIRED	1			1
DRINKING FOUNTAINS	1000		1		ACCESSIBLE COMBO UNIT)

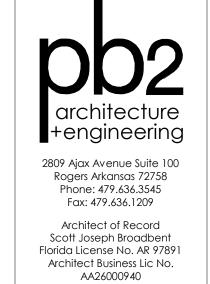

	.0002 520	30.1	
	ОТР	08.11.2023	
PR1	PR1	10.13.2023	
PR2	PR2	11.10.2023	
PR3	PR3	12.01.2023	
PR4	PR4	04.25.2024	
PR5	PR5	12.05.2024	
CHECKED BY:		KG	
DRA	WN BY:	HLB / AAS	
DOC	UMENT DATE:	11.06.2023	

ISSUE BLOCK



CVR



ELECTRICAL ONE-LINE DIAGRAM AND SYMBOLS LEGEND

ENLARGED POWER PLAN

PANELBOARD SCHEDULES

ELECTRICAL LOW VOLTAGE PLAN

09.24.2024 E2.1

09.24.2024 E3.0

09.24.2024 E3.1

09.24.2024 ELV1

* FIRE EXTINGUISHERS

/PR	4		PR4		~~~~	~~~~	~~~	~~~~
(MEANS OF	EGRESS DISTANCE			OCCUPANO	CY LOAD	SCHEDU	LE
3	Exit Path	Exit Path Distance						TOTAL
}	Α	43' - 10"	Ŋ N	UMBER	NAME	AREA	FAPO	OCCUPANCY
(В	73' - 4"	{	100	B - BUSINESS	1324 SF	150 SF	9
				101	S1 - STORAGE	4654 SF	300 SF	16
			8	102	S1 - STORAGE	95 SF	300 SF	1
				103	S1 - STORAGE	4416 SF	300 SF	15
						10/88 SE		//1

PR2 - REMOVED ATTACHED WASHBAY.

manner of the same of the same

			10488 SF	41
TOTAL EXIT WIDTH 33" /0.2" = 165 OCCU S1 - STORAGE OCCUPANT SQUARE FOOTAGE 4416 SF TOTAL OCCUPANTS 15	33" E OCCUPAN FOOTAG	O1 ORAGE IT SQUARE E 4654 SF CUPANTS 16	B - BUSII OCCUPANT FOOTAGE	NESS SQUARE 1324 SF
		+ + + + + + + + + + + + + + + + + + + +	TOTAL OCCU 82" TOTAL EXIT W 82" /0.2" = 410 0 ALLOW 102 S1 - STO	/IDTH: 82" CCUPANTS ED
Liunuminan, "	33" H TOTAL EXIT 33" /0.2" = 165		OCCUPANT FOOTAGE TOTAL OCCL	SQUARE 95 SF
1) LIFE SAFETY PLAN 3/64" = 1'-0"	ALLC		PRZ	TTACHED WASHBAY. O ATTACHED WASHBA

SECTION 01000 - GENERAL REQUIREMENTS

1.1 SUMMARY OF WORK

- A. THE PROJECT CONSISTS OF DEMOLITION AND CONSTRUCTION FOR THE PROJECT REPRESENTED BY THESE DOCUMENTS INCLUDING ALL SITEWORK, LANDSCAPING, PAVING, AND NEW CONSTRUCTION.
- 3. CONTRACTOR'S USE OF PREMISES: CONFINE OPERATIONS AT SITE TO AREAS PERMITTED BY LAW, ORDINANCES, PERMITS, AND CONTRACT DOCUMENTS.

DURING THE CONSTRUCTION PERIOD THE CONTRACTOR SHALL HAVE LIMITED USE OF THE PREMISES FOR CONSTRUCTION OPERATIONS, INCLUDING USE OF THE SITE. THE OWNER WILL DESIGNATE AN ENTRANCE TO SITE FOR CONTRACTOR'S USE. DO NOT USE OTHER ENTRANCES.

 DO NOT UNREASONABLY ENCUMBER SITE WITH MATERIALS OR EQUIPMENT. 3. DO NOT LOAD STRUCTURES OR PAVEMENTS WITH WEIGHT THAT WILL ENDANGER OR DAMAGE THEM. 4. ASSUME FULL RESPONSIBILITY FOR PROTECTION AND SAFEKEEPING OF MATERIALS AND PRODUCTS STORED ON AND OFF THE

PREMISES, INCLUDING OWNER-FURNISHED ITEMS. PROTECT EXISTING FEATURES, UTILITIES, EQUIPMENT, AND IMPROVEMENTS NOT DESIGNATED FOR REMOVAL, AND RESTORE DAMAGED OR TEMPORARILY RELOCATED UTILITIES AND IMPROVEMENTS TO A CONDITION EQUAL TO OR BETTER THAN EXISTED PRIOR TO SUCH DAMAGE OR TEMPORARY RELOCATION.

1.2 SITE INVESTIGATION

A. COMPARE CONDITIONS AT SITE WITH DRAWINGS AND SPECIFICATIONS FOR WORK. NOTIFY THE ARCHITECT, IN WRITING, AT OR BEFORE TIME OF SUBMITTING BID, OF ANY DISCREPANCIES BETWEEN DRAWINGS AND SPECIFICATIONS AND EXISTING CONDITIONS AT THE SITE; AND MAKE BID CONFORM TO THE INTENT OF THE CONTRACT DOCUMENTS

3. CONTRACTOR TO VERIFY ALL EXISTING CONDITIONS PRIOR TO BIDDING, FABRICATION, AND CONSTRUCTION. NOTIFY ARCHITECT OF ANY DISCREPANCIES FOR CLARIFICATION. ADJUSTMENTS FOR FIT AND COORDINATION SHALL BE MADE AT NO ADDITIONAL COST TO THE OWNER. . THE EXISTENCE AND LOCATION OF UNDERGROUND UTILITIES AND CONSTRUCTION INDICATED AS EXISTING ARE NOT GUARANTEED.

BEFORE BEGINNING SITEWORK, VERIFY THE EXISTENCE AND LOCATION OF UNDERGROUND UTILITIES AND OTHER CONSTRUCTION.). REFERENCE DATA MADE AVAILABLE TO CONTRACTOR ARE GIVEN FOR CONTRACTOR'S INFORMATION ONLY, AND NEITHER OWNER NOR THE ARCHITECT ASSUME ANY RESPONSIBILITY FOR CONCLUSIONS CONTRACTOR MAY DRAW THEREFROM.

E. FAILURE BY CONTRACTOR TO ACQUAINT HIMSELF WITH ALL AVAILABLE INFORMATION CONCERNING THESE CONDITIONS WILL NOT RELIEVE HIM FROM RESPONSIBILITY FOR ESTIMATING COST OR DIFFICULTY OF SUCCESSFULLY PERFORMING WORK. F. DO NOT SCALE DRAWINGS. NOTIFY ARCHITECT OF ANY DIMENSIONAL DISCREPANCIES FOR CLARIFICATION.

.3 REFERENCE STANDARDS

A. PERFORM WORK IN COMPLIANCE WITH ALL ACCESSIBILITY STANDARDS AND ALL APPLICABLE FEDERAL, STATE, AND LOCAL CODES CODE AMENDMENTS, AND ORDINANCES. B. APPLICABLE INDUSTRY STANDARDS HAVE THE SAME FORCE AND EFFECT AS IF BOUND OR COPIED INTO CONTRACT DOCUMENTS.

SUCH STANDARDS ARE PART OF THE CONTRACT DOCUMENTS BY REFERENCE. WHERE COPIES OF STANDARDS ARE NEEDED FOR PERFORMANCE OF A REQUIRED CONSTRUCTION ACTIVITY, THE CONTRACTOR SHALL OBTAIN COPIES DIRECTLY FROM THE PUBLICATION SOURCE . WHERE THE SPECIFIC DATE OR ISSUE OF THE STANDARD IS NOT INCLUDED WITH THE REFERENCE TO THE STANDARD IN THE

CONTRACT DOCUMENTS, THE EDITION AND AMENDMENTS ADOPTED, PUBLISHED, AND AVAILABLE TO THE PUBLIC ON THE DATE OF

THESE DOCUMENTS SHALL APPLY.). WHERE TWO OR MORE STANDARDS ARE SPECIFIED TO ESTABLISH QUALITY, THE PRODUCT AND WORKMANSHIP SHALL CONFORM TO OR SURPASS THE REQUIREMENTS OF BOTH.

SECTION 01300 - SUBMITTALS

- A. COORDINATE SUBMITTAL PREPARATION WITH PERFORMANCE OF CONSTRUCTION ACTIVITIES, AND WITH PURCHASING OR FABRICATION, DELIVERY, OTHER SUBMITTALS AND RELATED ACTIVITIES. ALL SUBMITTALS SHALL BE PROVIDED BY WEEK FOUR (4) OF CONSTRUCTION TO AVOID DELAY.
- THE NEED TO REVIEW CONCURRENTLY FOR COORDINATION. ALLOW TWO WEEKS FOR REVIEW NO EXTENSION OF TIME WILL BE AUTHORIZED BECAUSE OF FAILURE TO TRANSMIT SUBMITTALS SUFFICIENTLY IN ADVANCE OF

COORDINATE TRANSMITTAL OF DIFFERENT SUBMITTALS FOR RELATED ELEMENTS SO PROCESSING WILL NOT BE DELAYED BY

- THE WORK TO PERMIT PROCESSING. 4. CONTRACTOR WILL REIMBURSE ARCHITECT FOR ARCHITECT'S EXPENSES IN REVIEWING SUBMITTALS THAT ARE SUBMITTED
- B. PLACE A TITLE BLOCK ON EACH SUBMITTAL FOR IDENTIFICATION. INDICATE THE NAME OF THE ENTITY THAT PREPARED THE SUBMITTAL, PROJECT NAME, DATE, AND NAME OF THE MANUFACTURER.
- TRANSMIT WITH AIA DOCUMENT G810 OR OTHER FORM AS APPROVED BY ARCHITECT. INCLUDE CONTRACTOR'S CERTIFICATION THAT
- INFORMATION COMPLIES WITH CONTRACT DOCUMENTS. . THE ARCHITECT WILL REVIEW ONLY THE CONSTRUCTION DATA REQUESTED FOR CONFORMANCE WITH THE DESIGN OF THE PROJECT AND WITH THE INFORMATION GIVEN IN THE CONTRACT DOCUMENTS, AND NOT TO DETERMINE ACCURACY AND COMPLETENESS OF
- OTHER DETAILS SUCH AS DIMENSIONS AND QUANTITIES, OR FOR SUBSTANTIATING INSTRUCTIONS FOR INSTALLATION OR PERFORMANCE OF FOUIPMENT OR SYSTEMS ARCHITECT'S REVIEW DOES NOT CONSTITUTE APPROVAL OF SAFETY PRECAUTIONS OR ANY CONSTRUCTION MEANS, METHODS,
- TECHNIQUES, SEQUENCES OR PROCEDURES. THE ARCHITECT'S REVIEW OF A SEPARATE ITEM SHALL NOT INDICATE APPROVAL OF AN ASSEMBLY IN WHICH THE ITEM FUNCTIONS THE ARCHITECT'S REVIEW SHALL NOT RELIEVE THE CONTRACTOR OF RESPONSIBILITY FOR ANY DEVIATION FROM THE
- REQUIREMENTS OF THE CONTRACT DOCUMENTS UNLESS THE CONTRACTOR HAS INFORMED THE ARCHITECT IN WRITING OF SUCH DEVIATION AT THE TIME OF SUBMISSION AND THE ARCHITECT HAS GIVEN WRITTEN ACCEPTANCE TO THE SPECIFIC DEVIATION, NOR SHALL THE ARCHITECT'S ACCEPTANCE RELIEVE THE CONTRACTOR FROM RESPONSIBILITY FOR ERRORS OR OMISSIONS IN THE CONSTRUCTION DATA
- NO PORTION OF THE WORK REQUIRING A SUBMISSION SHALL BE COMMENCED UNTIL THE SUBMISSION HAS BEEN REVIEWED BY THE ARCHITECT. ALL SUCH PORTIONS OF THE WORK SHALL BE IN ACCORDANCE WITH REVIEWED CONSTRUCTION DATA.

.2 SUBMITTALS

- A. SUBMIT INFORMATION DRAWN TO ACCURATE SCALE. INDICATE DEVIATIONS FROM CONTRACT DOCUMENTS. DO NOT REPRODUCE CONTRACT DOCUMENTS OR COPY STANDARD INFORMATION AS THE BASIS OF SHOP DRAWINGS. WHERE PRINTED MATERIALS DESCRIBE MORE THAN ONE PRODUCT OR MODEL, CLEARLY IDENTIFY WHICH IS SUBMITTED FOR REVIEW. MARK EACH COPY TO SHOW APPLICABLE CHOICES AND OPTIONS.
- SUBMIT ELECTRONIC FILES CREATED WITH ADOBE ACROBAT VERSION 5.0 OR HIGHER: THE ARCHITECT WILL RETURN THE FILE WITH REDLINES MARKING ACTION TAKEN, CORRECTIONS, MODIFICATIONS, OR RESUBMITTALS REQUIRED. DO NOT USE SHOP DRAWINGS WITHOUT A FINAL STAMP INDICATING ACTION TAKEN IN CONNECTION WITH CONSTRUCTION.
- INCLUDE THE FOLLOWING INFORMATION: MANUFACTURER'S PRINTED RECOMMENDATIONS, COMPLIANCE WITH RECOGNIZED TESTING AGENCY STANDARDS, APPLICATION OF TESTING AGENCY LABELS AND SEALS, NOTATION OF DIMENSIONS VERIFIED BY FIELD MEASUREMENT, AND NOTATION OF COORDINATION REQUIREMENTS. B. REQUIRED SUBMITTALS: REFER TO SPECIFICATIONS.

1.3 QUALITY ASSURANCE SUBMITTALS

A. SUBMIT QUALITY-CONTROL SUBMITTALS, INCLUDING CERTIFICATIONS, MANUFACTURER'S INSTRUCTIONS, MANUFACTURER'S FIELD REPORTS, AND OTHER QUALITY-CONTROL SUBMITTALS AS REQUIRED UNDER OTHER SECTIONS OF THE SPECIFICATIONS. 3. CERTIFICATIONS: WHERE SECTIONS OF THE SPECIFICATIONS REQUIRE CERTIFICATION THAT A PRODUCT, MATERIAL, OR INSTALLATION COMPLIES WITH SPECIFIED REQUIREMENTS, SUBMIT A NOTARIZED CERTIFICATION FROM THE MANUFACTURER CERTIFYING COMPLIANCE WITH SPECIFIED REQUIREMENTS. CERTIFICATION SHALL BE SIGNED BY AN OFFICER OF THE MANUFACTURER OR OTHER

1.4 WEEKLY PROGRESS REPORTS

A. PROVIDE PROGRESS REPORTS ELECTRONICALLY AS REQUIRED BY THE OWNER WHICH INCLUDES SCHEDULE UPDATE, RISK ISSUES, SUBMITTAL LOG, RFI LOG, AND PHOTOS.

SECTION 01400 - QUALITY CONTROL

INDIVIDUAL AUTHORIZED TO SIGN DOCUMENTS ON BEHALF OF THE COMPANY.

.1 TESTING GENERAL REQUIREMENTS

A. VALUES: ALL TEST FREQUENCIES ARE MINIMUM VALUES. B. ADDITIONAL TESTING

1. THE TESTING LABORATORY SHALL PERFORM ADDITIONAL TESTING IF REQUIRED TO THOROUGHLY EVALUATE THE MATERIAL CHANGES IN MATERIAL OR SOURCES GENERALLY REQUIRE ADDITIONAL TESTING TO VERIFY SPECIFICATION COMPLIANCE. 2. THE OWNER RESERVES THE RIGHT TO PERFORM ADDITIONAL TESTING ABOVE THESE MINIMUM AMOUNTS.

3. RETESTING REQUIRED DUE TO FAILED TESTS WILL BE PAID FOR BY THE CONTRACTOR.

CONSTRUCTION.

1. $\,$ FIELD TESTS SHOULD PREFERABLY BE SCHEDULED BY THE CONTRACTORS 24 HOURS IN ADVANCE. 2. TESTS MUST BE SCHEDULED BEFORE 5 O'CLOCK P.M. ON THE DAY PRIOR TO TESTING. 3. SCHEDULING OF TESTS SHALL BE DONE BY CALLING THE TESTING LABORATORY'S OFFICE AND NOT THROUGH FIELD TECHNICIANS

WORKING AT THE SITE. 4. THE CONTRACTOR/SUBCONTRACTORS SHOULD EXPECT DELAYS IF THE TESTS ARE NOT SCHEDULED TO MEET THIS CRITERIA.

). REPORTING: ALL TEST RESULTS SHALL BE REPORTED PROMPTLY AND DISTRIBUTED DIRECTLY TO THE OWNER' REPRESENTATIVE, ARCHITECT, STRUCTURAL ENGINEER, CIVIL ENGINEER, CONTRACTOR, AND GEOTECHNICAL ENGINEER OF RECORD AS APPROPRIATE.

1.2 SUBMITTALS A. GENERAL: THE CONTRACTOR SHALL EMPLOY AND PAY FOR SERVICES OF AN INDEPENDENT TESTING LABORATORY TO PERFORM SPECIFIED SERVICES AND TESTING. EMPLOYMENT OF LABORATORY SHALL IN NO WAY RELIEVE THE CONTRACTOR OF HIS OBLIGATION TO PERFORM THE WORK UNDER THIS CONTRACT. IT IS THE CONTRACTOR'S RESPONSIBILITY TO PROVIDE SUFFICIENT INFORMATION AND ALL TEST REPORTS FOR SERVICES PROVIDED. FAILURE TO PROVIDE THESE REPORTS MAY RESULT IN THE REQUEST OF ADDITIONAL TESTING BY THE OWNER PRIOR TO ACCEPTANCE. ALL COSTS FOR THESE ADDITIONAL SERVICES WILL BE THE RESPONSIBILITY OF THE CONTRACTOR. THE CONTRACTOR SHALL CONTACT THE LABORATORY AT APPROPRIATE TIMES DURING

B. MATERIALS AND PROCEDURES: SUBMITTALS SHALL BE AS REQUIRED IN SECTION 01300.

1.4 TESTING / OBSERVATION SERVICES

A. BUILDING CONSTRUCTION: ALL PHASES OF WORK WITHIN THE LIMITS OF THE PROPOSED CONSTRUCTION PROJECT.

SOIL SAMPLING AND TESTING: PLACEMENT AND COMPACTION OF FILL WITHIN THE BUILDING LIMITS. SERVICES INCLUDE SAMPLING AND TESTING OF FILL SOILS, PERIODIC OBSERVATION OF EARTHWORK OPERATIONS, AND MOISTURE-DENSITY TESTING OF SUBGRADE AND COMPACTED FILLS. AS A MINIMUM, THE FOLLOWING SERVICES SHOULD BE PROVIDED:

A. SAMPLE MATERIALS PROPOSED FOR USE AS SUBGRADE, BACKFILL OR SELECT FILL

3. PERFORM ATTERBERG LIMITS (ASTM D4318) FOR CLASSIFICATION PURPOSES FOR EACH SELECT FILL AND/OR BACKFILL MATERIALS PROPOSED FOR USE.

. PERFORM MOISTURE DENSITY RELATIONSHIPS (ASTM D698 AND/OR ASTM D1557) FOR EACH MATERIAL PROPOSED FOR USE AS SUBGRADE, SELECT FILL AND/OR BACKFILL. PROVIDE A MINIMUM OF 3 WORKING DAYS TO COMPLETE THE MOISTURE DENSITY RELATIONSHIPS PRIOR TO NEEDING THE REQUIRED DENSITY TESTING.

). PRIOR TO THE PLACEMENT OF FILL MATERIALS, PROOFROLL THE SUBGRADE SOILS WITH A LOADED TANDEM AXLE DUMP TRUCK MAKING SLOW PASSES ACROSS THE BUILDING PAD. ANY SOFT OR WET AREAS IDENTIFIED SHOULD BE REMEDIATED BASED ON THE RECOMMENDATIONS OUTLINED IN THE GEOTECHNICAL REPORT OR BY THE GEOTECHNICAL ENGINEER OF RECORD.

E. IF LIME STABILIZATION OF SUBGRADE OR FILL MATERIALS ARE REQUIRED WITHIN THE LIMITS OF THE BUILDING CONSTRUCTION THEN FIELD GRADATION TESTS ON THE LIME STABILIZED MATERIALS SHALL BE PERFORMED FOLLOWING THE CURING PERIOD. PERFORM FIELD GRADATION TESTS ON LIME TREATED MATERIALS AT A RATE OF ONE TEST PER 5,000 SQUARE FEET OR THREE TESTS PER LIFT.

PERFORM IN-SITU NUCLEAR DENSITY COMPACTION TESTING (ASTM D2922) IN THE FIELD TO DETERMINE MOISTURE CONTENT AND PERCENT COMPACTION OF COMPACTED MATERIALS AT A RATE OF ONE TEST PER 5,000 SQUARE FEET PER LIFT OR A MINIMUM OF 3 TESTS PER LIFT.

3. FOR BACKFILL OF FOUNDATIONS AND TRENCHES 12 INCHES WIDE AND WIDER BENEATH THE BUILDING SLAB, PERFORM NUCLEAR DENSITY COMPACTION TESTING (ASTM D2922) AT A RATE OF ONE TEST PER 100 LINEAL FEET PER LIFT.

FOUNDATION INSTALLATION OBSERVATIONS: OBSERVATION OF BOTH DEEP AND SHALLOW FOUNDATION SYSTEMS. SERVICES INCLUDE VERIFICATION OF PIER OR SPREAD FOOTING SIZE, DEPTH, BEARING STRATUM, OBSERVATION OF THE REINFORCING STEEL INSTALLED AND CONCRETE TESTING. AS A MINIMUM, THE FOLLOWING SERVICES SHOULD BE PROVIDED.

A. DRILLED PIERS: OBSERVE THE INSTALLATION OF DRILLED AND UNDERREAMED PIERS: RECORD AUGER DIAMETER. BELLING TOOL

DIAMETER, DEPTH AND BEARING STRATUM; DOCUMENT REINFORCING STEEL SIZE, SPACING, LENGTH AND CONFIGURATION PRIOR TO CONCRETE PLACEMENT: PROVIDE CONCRETE TESTING AS OUTLINED UNDER THE "CONCRETE TESTING" SECTION SHOWN BELOW.

B. SPREAD FOOTINGS/GRADE BEAMS: OBSERVE THE SPREAD FOOTING EXCAVATIONS PRIOR TO PLACEMENT OF CONCRETE; RECORD FOOTING SIZE, DEPTH, CLEANLINESS AND CONDITION OF BEARING STRATUM; DOCUMENT REINFORCING STEEL SIZE, SPACING, LENGTH AND CONFIGURATION PRIOR TO CONCRETE PLACEMENT; PROVIDE CONCRETE TESTING AS OUTLINED UNDER THE "CONCRETE TESTING" SECTION SHOWN BELOW.

C. FLOOR SLAB THICKNESS: OBTAIN AND DOCUMENT RANDOM SLAB THICKNESS PRIOR TO PLACEMENT OF CONCRETE BY ATTACHING A STRING ACROSS THE TOP OF THE SLAB FORMS AND MEASURING FROM THE STRING TO THE FINISHED SUBGRADE. THICKNESS MEASUREMENTS SHOULD BE RECORDED TO THE NEAREST 1/4 INCH.

2. REINFORCING STEEL OBSERVATIONS: DOCUMENT REINFORCING STEEL SIZE, SPACING, LENGTH, AND CONFIGURATION PRIOR TO CONCRETE PLACEMENT FOR BUILDING FOUNDATIONS, COLUMNS, FOOTINGS, WALLS, SLABS, ETC

3. CONCRETE TESTING AND OBSERVATIONS: CONCRETE FOR BUILDING FOUNDATIONS, COLUMNS, FOOTINGS, WALLS, SLABS, ETC. SERVICES INCLUDE MONITORING CONCRETE DURING PLACEMENT FOR STRUCTURAL ELEMENTS, SAMPLING CONCRETE, AND CONDUCTING SLUMP, TEMPERATURE, AIR CONTENT AND CONCRETE COMPRESSIVE STRENGTH TESTS. THE CONTRACTOR HAS THE RESPONSIBILITY TO REJECT CONCRETE THAT DOES NOT COMPLY WITH THE PROJECT SPECIFICATIONS OR IS UNSUITABLE FOR USE. THE CONTRACTOR ALSO HAS THE RESPONSIBILITY TO PROVIDE SUITABLE STORAGE FACILITIES AND TEMPERATURE CONTROL FOR TEST CYLINDERS DURING THE INITIAL CURING PERIOD AT THE CONSTRUCTION SITE. AT A MINIMUM, THE FOLLOWING SERVICES SHOULD BE PROVIDED:

A. SAMPLE THE FRESH CONCRETE AT THE POINT OF DISCHARGE AND PERFORM AND RECORD AIR CONTENT, SLUMP, AMBIENT AND MIX TEMPERATURE, AND MOLD COMPRESSIVE STRENGTH TEST SAMPLES AT A RATE OF 4 CYLINDERS PER 50 CUBIC YARDS FOR EACH MIX PLACED. A MINIMUM OF ONE SET OF 4 CYLINDERS SHALL BE CAST FOR EACH DAY'S PLACEMENT

B. TEST CONCRETE COMPRESSIVE STRENGTH CYLINDERS (ASTM C 39) AT THE FOLLOWING TEST DATES.

1. FOUNDATIONS/GRADE BEAMS: ONE AT 3 DAYS, ONE AT 7 DAYS, AND TWO AT 28 DAYS OF AGE.

2. ALL OTHER CONCRETE: TWO AT 7 DAYS AND TWO AT 28 DAYS OF AGE UNLESS OTHERWISE REQUESTED.

5. STRUCTURAL STEEL TESTING AND OBSERVATIONS: THIS ITEM REFERS TO STRUCTURAL STEEL WELDING, WELDING OF WALL PANEL CONNECTIONS, ROOF DECKS, ETC. SERVICES INCLUDE VISUAL OBSERVATION BY A CERTIFIED WELD INSPECTOR (CWI) OF FIELD WELDS AND RANDOM VERIFICATION OF WELD SIZES. IN ADDITION, AN ASNT LEVEL II ULTRASONIC TESTING TECHNICIAN WILL PROVIDE ULTRASONIC TESTING OF ALL FULL AND PARTIAL PENETRATION WELDS. VISUALLY OBSERVE BOLTED CONNECTIONS OR PERFORM VERIFICATION OF TIGHTNESS OF BOLTS USING A CALIBRATED TORQUE WRENCH. AT A MINIMUM, THE FOLLOWING SERVICES SHOULD BE PROVIDED.

A. PERFORM VISUAL WELD INSPECTIONS ON ALL FIELD WELDED CONNECTIONS IN ACCORDANCE WITH AWS D1.1 WITH RANDOM VERIFICATION OF WELD SIZES.

B. PERFORM VISUAL WELD INSPECTIONS OF DECK WELDS IN ACCORDANCE WITH AWS D1.3.

C. ULTRASONICALLY TEST ALL PARTIAL AND FULL PENETRATION WELDS.

D. FOR BEARING TYPE CONNECTIONS, PERFORM VISUAL OBSERVATIONS OF HIGH STRENGTH BOLTED CONNECTIONS TO VERIFY THE CONNECTED MATERIALS HAVE BEEN DRAWN TOGETHER AND PROPERLY SNUGGED. FOR SLIP CRITICAL CONNECTIONS, UTILIZE A CALIBRATED TORQUE WRENCH TO VERIFY THE PROPER TENSION HAS BEEN DEVELOPED FOR THE SPECIFIED BOLT. A MINIMUM OF 10 PERCENT OF ALL BOLTS WITH NO LESS THAN 2 BOLTS PER CONNECTION SELECTED AT RANDOM. FAILURE OF ANY BOLTS TO MEET THE JOB INSPECTING TORQUE VALUE WITHIN A CONNECTION WILL REQUIRE THAT ALL BOLTS WITHIN THAT CONNECTION BE TESTED.

B SITE DEVELOPMENT AND PARKING

A. PRIOR TO THE PLACEMENT OF AREA FILL OR STABILIZATION, PROOFROLL THE FILL AREA OR SUBGRADE SOILS WITH A LOADED TANDEM AXLE DUMP TRUCK MAKING SLOW PASSES. ANY SOFT OR WET AREAS IDENTIFIED SHOULD BE REMEDIATED BASED ON THE RECOMMENDATIONS OUTLINED IN THE GEOTECHNICAL REPORT OR BY THE GEOTECHNICAL ENGINEER OF RECORD.

B. FIELD GRADATION TESTS ON LIME STABILIZED SUBGRADE MATERIALS SHALL BE PERFORMED FOLLOWING THE CURING PERIOD. PERFORM FIELD GRADATION TESTS ON LIME TREATED SUBGRADE MATERIALS AT A RATE OF ONE TEST PER 10,000 SQUARE FEET OR THREE TESTS PER AREA STABILIZED FOR PAVING SUBGRADE.

C. PERFORM IN-SITU NUCLEAR DENSITY COMPACTION TESTING (ASTM D2922) IN THE FIELD TO DETERMINE MOISTURE CONTENT AND PERCENT COMPACTION OF COMPACTED MATERIALS AT A RATE OF ONE TEST PER 5,000 SQUARE FEET PER LIFT WITH A MINIMUM OF 3 TESTS PER LIFT.

D. FOR BACKFILL OF UTILITY TRENCHES 18 INCHES WIDE AND WIDER OR BACKFILL OF RETAINING WALLS, PERFORM NUCLEAR DENSITY COMPACTION TESTING (ASTM D2922) AT A RATE OF ONE TEST PER 100 LINEAL FEET PER LIFT WITH A MINIMUM OF 3 TESTS PER LIFT.

E. FOR STABILIZED SUBGRADE, PERFORM THICKNESS MEASUREMENTS OF STABILIZED LAYER AT A RATE OF ONE TEST PER 20,000 SQUARE FEET WITH A MINIMUM OF THREE TESTS PER AREA STABILIZED. F. PRIOR TO THE PLACEMENT OF ANY SUBSEQUENT PAVEMENT LAYER, THE PROJECT SUPERINTENDENT, OWNER'S REPRESENTATIVE

AND GEOTECHNICAL ENGINEER (OR THEIR REPRESENTATIVES) WILL WALK THE PAVING SUBGRADE TO IDENTIFY ANY SOFT. WET OR

DISTURBED AREAS. AREAS IDENTIFIED SHOULD BE REWORKED AND RETESTED PRIOR TO START OF PAVING OPERATIONS 2. SOIL SAMPLING AND TESTING: THIS ITEM REFERS TO PLACEMENT AND COMPACTION OF MATERIALS OUTSIDE OF THE BUILDING AREAS INCLUDING GENERAL FILL TO ACHIEVE SUBGRADE ELEVATION. BACKFILL OF ON-SITE UTILITIES. BACKFILL OF RETAINING WALLS, AND STABILIZATION OF PAVING SUBGRADE. SERVICES INCLUDE SAMPLING AND TESTING OF FILL SOILS, PERIODIC OBSERVATION OF EARTHWORK OPERATIONS AND BACKFILLING OF UTILITIES AND RETAINING WALLS AND MOISTURE-DENSITY TESTING OF COMPACTED FILLS, BACKFILL AND TREATED SUBGRADE. AS A MINIMUM, THE FOLLOWING SERVICES SHOULD BE

A. SAMPLE MATERIALS PROPOSED FOR USE AS ON-SITE FILL, IMPORTED FILL, BACKFILL OR TREATED SUBGRADE.

B. PERFORM ATTERBERG LIMITS (ASTM D4318) FOR CLASSIFICATION PURPOSES FOR EACH ON-SITE FILL, IMPORTED FILL, BACKFILL OR TREATED SUBGRADE PROPOSED FOR USE.

C. PERFORM MOISTURE DENSITY RELATIONSHIPS (ASTM D698, ASTM 1557, TEX 113-E OR ASTM D558) FOR EACH MATERIAL PROPOSED FOR USE AS TREATED SUBGRADE, SELECT FILL AND/OR BACKFILL. PROVIDE A MINIMUM OF 3 WORKING DAYS TO COMPLETE THE MOISTURE DENSITY RELATIONSHIPS PRIOR TO NEEDING THE REQUIRED DENSITY TESTING.

D. SAMPLE THE BASE MATERIALS PROPOSED FOR USE.

E. PERFORM ATTERBERG LIMITS AND AGGREGATE GRADATION FOR CLASSIFICATION OF THE BASE MATERIAL PROPOSED FOR USE.

F. PERFORM MOISTURE DENSITY RELATIONSHIPS FOR EACH MATERIAL PROPOSED FOR USE. PROVIDE A MINIMUM OF 3 WORKING DAYS TO COMPLETE THE MOISTURE DENSITY RELATIONSHIPS PRIOR TO NEEDING THE REQUIRED DENSITY TESTING.

G. PERFORM IN-SITU NUCLEAR DENSITY COMPACTION TESTING (ASTM D2922) IN THE FIELD TO DETERMINE MOISTURE CONTENT AND PERCENT COMPACTION OF COMPACTED MATERIALS AT A RATE OF ONE TEST PER 5,000 SQUARE FEET PER LIFT WITH A MINIMUM OF 3

H. FOR AGGREGATE BASE, PERFORM THICKNESS MEASUREMENT OF BASE LAYER AT A RATE OF ONE TEST PER 10,00 SQUARE FEET WITH A MINIMUM OF THREE TESTS PER AREA.

1. HOT MIXED ASPHALTIC CONCRETE TESTING:

A. AT LEAST FOUR WEEKS PRIOR TO START OF ASPHALT PLACEMENT, REVIEW THE CONTRACTOR'S SUBMITTED ASPHALT MIX DESIGNS PROPOSED FOR USE. THE MIX DESIGN SHALL INCLUDE TESTS TO DETERMINE IF THE MIX IS SUSCEPTIBLE TO STRIPPING OR THE EFFECTIVENESS OF ANTI-STRIPPING ADDITIVES IN THE PAVING MIXTURE.

B. MONITOR THE ASPHALT PLACEMENT, TAKING RANDOM ASPHALT TEMPERATURES DURING PLACEMENT AND COMPACTION OF THE ASPHALT LAYER. IN ADDITION, OBTAIN ONE BULK SAMPLE PER DAY OF ASPHALTIC CONCRETE BEING PLACED.

C. THE FOLLOWING TESTS WILL BE PERFORMED ON EACH BULK SAMPLE: ASPHALT CONTENT, AGGREGATE, GRADATION, MOLDED DENSITY, THEORETICAL MAXIMUM VOIDLESS DENSITY, AND STABILITY.

D. ASSIST THE CONTRACTOR IN ESTABLISHING A ROLLING PATTERN. THE NUCLEAR DENSITY GAUGE WILL BE UTILIZED TO DETERMINE RELATIVE DENSITIES OF THE ASPHALT LAYER DURING THE CONTRACTOR'S ROLLING PROCEDURES. PROVIDE ADDITIONAL DENSITIES DURING ASPHALT PLACEMENT AT A RATE OF ONE TEST PER 2,500 SQUARE FEET PER LAYER. THE CONTRACTOR SHALL UNDERSTAND THAT ALL NUCLEAR GAUGE DENSITY TESTING IS PERFORMED AS AN AID TO CONSTRUCTION AND WILL NOT RELIEVE THE CONTRACTOR OF HIS RESPONSIBILITY TO PRODUCE THE REQUIRED DENSITY.

E. FOLLOWING THE COMPLETION OF THE ASPHALT PAVING, OBTAIN ONE CORE PER 10,000 SQUARE FEET OF NEWLY PLACED PAVEMENT WITH A MINIMUM OF 3 CORES PER PROJECT. THE CORES WILL BE UTILIZED TO DETERMINE DENSITY OF THE COMPACTED ASPHALT LAYER AND THE OVERALL PAVEMENT THICKNESS (ASTM 3549).

1. REINFORCING STEEL OBSERVATIONS: DOCUMENT REINFORCING STEEL SIZE, SPACING, LENGTH, AND CONFIGURATION PRIOR TO CONCRETE PLACEMENT FOR PAVEMENTS.

2. CONCRETE TESTING AND OBSERVATIONS: CONCRETE FOR PAVEMENTS. SERVICES INCLUDE MONITORING CONCRETE DURING PLACEMENT FOR PAVING. SAMPLING CONCRETE. AND CONDUCTING SLUMP. TEMPERATURE. AIR CONTENT AND CONCRETE COMPRESSIVE STRENGTH TESTS. THE CONTRACTOR HAS THE RESPONSIBILITY TO REJECT CONCRETE THAT DOES NOT COMPLY WITH THE PROJECT SPECIFICATIONS OR IS UNSUITABLE FOR USE. THE CONTRACTOR ALSO HAS THE RESPONSIBILITY TO PROVIDE SUITABLE STORAGE FACILITIES AND TEMPERATURE CONTROL FOR TEST CYLINDERS DURING THE INITIAL CURING PERIOD AT THE CONSTRUCTION SITE. AT A MINIMUM, THE FOLLOWING SERVICES SHOULD BE PROVIDED:

A. SAMPLE THE FRESH CONCRETE AT THE POINT OF DISCHARGE AND PERFORM AND RECORD AIR CONTENT, SLUMP, AMBIENT AND MIX TEMPERATURE, AND MOLD COMPRESSIVE STRENGTH TEST SAMPLES AT A RATE OF 4 CYLINDERS PER 150 CUBIC YARDS OR FRACTION THEREOF. A MINIMUM OF ONE SET OF 4 CYLINDERS SHALL BE CAST FOR EACH DAY'S PLACEMENT.

B. TEST CONCRETE COMPRESSIVE STRENGTH CYLINDERS (ASTM C 39): ONE AT 3 DAYS, ONE AT 7 DAYS, AND B. TWO AT 28 DAYS OF AGE. PRIOR TO THE COMPLETION OF THE FINAL PUNCH LIST, THE CONTRACTOR'S SUPERINTENDENT, OWNER'S REPRESENTATIVE AND GEOTECHNICAL ENGINEER (OR THEIR DESIGNATED REPRESENTATIVES) SHALL WALK THE CONCRETE AND ASPHALT PAVEMENT TO IDENTIFY ANY AREAS REQUIRING REPAIR OR REPLACEMENT.

SECTION 01500 - CONSTRUCTION FACILITIES AND TEMPORARY

I.1 QUALITY ASSURANCE

A. COMPLY WITH INDUSTRY STANDARDS AND APPLICABLE LAWS AND REGULATIONS OF AUTHORITIES HAVING JURISDICTION.

B. COMPLY WITH NFPA 241 "STANDARD FOR SAFEGUARDING CONSTRUCTION, ALTERATIONS, AND DEMOLITION OPERATIONS," ANSI A10 SERIES STANDARDS FOR "SAFETY REQUIREMENTS FOR CONSTRUCTION AND DEMOLITION," AND NECA ELECTRICAL DESIGN LIBRARY "TEMPORARY ELECTRICAL FACILITIES." ELECTRICAL SERVICE SHALL COMPLY WITH NEMA, NECA, AND UL STANDARDS AND REGULATIONS FOR TEMPORARY ELECTRIC SERVICE. INSTALL SERVICE IN COMPLIANCE WITH NFPA 70 "NATIONAL ELECTRIC CODE."

C. ARRANGE FOR AUTHORITIES HAVING JURISDICTION TO INSPECT AND TEST EACH TEMPORARY UTILITY BEFORE USE. OBTAIN REQUIRED CERTIFICATIONS AND PERMITS.

1.2 TEMPORARY UTILITIES

A. WHERE AVAILABLE, CONTRACTOR MAY USE EXISTING UTILITIES WHEN APPROVED IN WRITING BY THE OWNER. CONTRACTOR SHALL PROVIDE ALL CONNECTIONS AND EXTENSIONS THERETO. MAINTAIN IN A SAFE MANNER AND UTILIZE SO AS NOT TO CONSTITUTE A HAZARD TO PERSONS OR PROPERTY. CONNECTIONS OR EXTENSIONS WHICH REPRESENT A SAFETY HAZARD SHALL BE PROMPTLY REMEDIED AT CONTRACTOR'S COST.

1. LIGHT AND POWER: PROVIDE TEMPORARY ELECTRIC POWER REQUIRED THROUGHOUT THE CONSTRUCTION PERIOD SO THAT POWER CAN BE SECURED AT ANY DESIRED POINT WITHIN THE BUILDING WITH NO MORE THAN 100 FEET EXTENSION.

2. WATER: PROVIDE AND MAINTAIN TEMPORARY WATER SERVICE FOR DRINKING AND CONSTRUCTION PURPOSES FOR ALL PARTS OF

THE WORK. PROVIDE POTABLE WATER APPROVED BY LOCAL HEALTH AUTHORITIES.

3. HEAT AND VENTILATION: PROVIDE WEATHER-TIGHT ENCLOSURES AND HEATING AND VENTILATING AS REQUIRED DURING CONSTRUCTION TO PROTECT THE WORK FROM DAMAGE, AND AS NECESSARY TO ENSURE SUITABLE WORKING CONDITIONS FOR THE CONSTRUCTION OPERATIONS OF ALL TRADES. MAINTAIN BUILDING TEMPERATURE AS SPECIFIED IN THE VARIOUS SECTIONS OF THE SPECIFICATIONS, BUT NOT LESS THAN 50 DEGREES F.

B. TELEPHONE AND FACSIMILE: PROVIDE DEDICATED SERVICE FOR CONSTRUCTION NEEDS THROUGHOUT CONSTRUCTION PERIOD. TELEPHONE AND FACSIMILE MACHINE SHALL BE PROVIDED IN THE FIELD OFFICE. COMMUNICATION BETWEEN THE OWNER'S REPRESENTATIVE, THE ARCHITECT, AND THE CONTRACTOR SHALL BE ACCOMPLISHED BY ONE OR MORE OF THE FOLLOWING: ANSWERING MACHINE CONNECTED TO TELEPHONE IN FIELD OFFICE OR CELLULAR PHONE WITH ANSWERING SERVICE FOR CONTRACTOR.

C. SANITARY FACILITIES: PROVIDE AND MAINTAIN TEMPORARY TOILET AND OTHER SANITARY FACILITIES FOR ALL WORKERS ON THE PROJECT, PROVIDE SELF-CONTAINED, SINGLE-OCCUPANT TOILET UNITS OF THE CHEMICAL, AERATED RECIRCULATION, OR COMBUSTION TYPE. PROVIDE UNITS PROPERLY VENTED AND FULLY ENCLOSED WITH A GLASS-FIBER-REINFORCED POLYESTER SHELL OR SIMILAR NONABSORBENT MATERIAL.

D. FIRST AID: PROVIDE AS REQUIRED BY AND IN ACCORDANCE WITH LEGAL REQUIREMENTS.

1.3 FIELD OFFICES AND STORAGE SHEDS

A. PROVIDE FIELD OFFICES AND STORAGE SHEDS AS REQUIRED FOR TIMELY PROGRESS OF WORK. LOCATE TEMPORARY STRUCTURES TO AVOID INTERFERENCE WITH WORK AND AS APPROVED BY OWNER'S REPRESENTATIVE.

1. FIELD OFFICES: PROVIDE INSULATED, WEATHER-TIGHT OFFICES OF SIZE TO ACCOMMODATE PERSONNEL. PROVIDE HEATED AND AIR-CONDITIONED UNITS, ON ADEQUATE FOUNDATIONS, WITH LOCKABLE ENTRANCES, OPERABLE WINDOWS AND SERVICEABLE FINISHES. FACILITIES SHALL BE ACCESSIBLE TO THE ARCHITECT AND OWNER'S REPRESENTATIVES AT ALL TIMES.

A. FACILITIES SHALL HAVE DESK SPACE FOR THE ARCHITECT AND/OR OWNER'S REPRESENTATIVE WITH AVAILABLE POWER AND HIGH SPEED WIRELESS INTERNET CONNECTION.

B. PROVIDE PLAN RACK FOR PLAN LAYOUT.

C. PROVIDE TABLE FOR MEETINGS.

D. CONTRACTOR SHALL PROVIDE PRINTER CAPABLE OF PRINTING 11" X 17" DOCUMENTS.

2. STORAGE AND FABRICATION SHEDS: INSTALL SHEDS, EQUIPPED TO ACCOMMODATE MATERIALS AND EQUIPMENT INVOLVED. 1.4 SAFETY AND ENVIRONMENTAL REQUIREMENTS

A. JOBSITE AND PUBLIC SAFETY AND SECURITY IS THE CONTRACTOR'S SOLE RESPONSIBILITY INCLUDING PROVIDING ALL NECESSARY AMENITIES. ANY LIABILITY OCCURRING DURING CONSTRUCTION IS THE SOLE RESPONSIBILITY OF THE CONTRACTOR.

B. KEEP FACILITIES CLEAN AND NEAT. OPERATE IN A SAFE AND EFFICIENT MANNER. DO NOT OVERLOAD, OR PERMIT FACILITIES TO

INTERFERE WITH PROGRESS. DO NOT ALLOW HAZARDOUS, DANGEROUS OR UNSANITARY CONDITIONS, OR PUBLIC NUISANCES TO DEVELOP OR PERSIST ON THE SITE. MAINTAIN PROJECT IN ACCORDANCE WITH STATE AND LOCAL SAFETY AND INSURANCE STANDARDS. C. TEMPORARY FIRE PROTECTION: UNTIL FIRE-PROTECTION NEEDS ARE SUPPLIED BY PERMANENT FACILITIES, INSTALL AND MAINTAIN

TEMPORARY FIRE-PROTECTION FACILITIES OF THE TYPES NEEDED TO PROTECT AGAINST REASONABLY PREDICTABLE AND CONTROLLABLE FIRE LOSSES. COMPLY WITH NFPA 10 "STANDARD FOR PORTABLE FIRE EXTINGUISHERS" AND NFPA 241 "STANDARD FOR SAFEGUARDING CONSTRUCTION, ALTERATIONS, AND DEMOLITION OPERATIONS."

1. LOCATE FIRE EXTINGUISHERS WHERE CONVENIENT AND EFFECTIVE FOR THEIR INTENDED PURPOSE

2. STORE COMBUSTIBLE MATERIALS IN CONTAINERS IN FIRE-SAFE LOCATIONS.

MAINTAIN UNOBSTRUCTED ACCESS TO FIRE EXTINGUISHERS, FIRE HYDRANTS, TEMPORARY FIRE-PROTECTION FACILITIES, STAIRWAYS, AND OTHER ACCESS ROUTES FOR FIGHTING FIRES. PROHIBIT SMOKING IN HAZARDOUS FIRE-EXPOSURE AREAS.

4. PROVIDE SUPERVISION OF WELDING OPERATIONS, COMBUSTION-TYPE TEMPORARY HEATING UNITS, AND SIMILAR SOURCES OF FIRE

C. ENCLOSURES AND BARRICADES:

1. COVERED WALKWAY: ERECT A STRUCTURALLY ADEQUATE, PROTECTIVE COVERED WALKWAY FOR PASSAGE OF PERSONS ALONG THE ADJACENT PUBLIC STREET. COORDINATE WITH ENTRANCE GATES, OTHER FACILITIES, AND OBSTRUCTIONS. COMPLY WITH REGULATIONS OF AUTHORITIES HAVING JURISDICTION.

2. BARRICADES, WARNING SIGNS, AND LIGHTS: COMPLY WITH STANDARDS AND CODE REQUIREMENTS FOR ERECTION OF STRUCTURALLY ADEQUATE BARRICADES. PAINT WITH APPROPRIATE COLORS, GRAPHICS, AND WARNING SIGNS TO INFORM PERSONNEL AND THE PUBLIC OF THE HAZARD BEING PROTECTED AGAINST. WHERE APPROPRIATE AND NEEDED, PROVIDE

3. TEMPORARY EQUIPMENT AND BARRIERS: LOCATION AND ARRANGEMENT OF TEMPORARY EQUIPMENT AND BARRIERS SHALL BE SUBJECT TO THE APPROVAL OF THE OWNER'S REPRESENTATIVE. CONTRACTOR SHALL PROVIDE SUCH TEMPORARY WALKS, FENCES OR OTHER PROTECTIVE STRUCTURES AS ARE NECESSARY FOR SAFETY OF THE PUBLIC. PROVIDE SUFFICIENT LIGHTING ADJACENT TO ANY AND ALL OBSTRUCTIONS OR HAZARDS DURING CONSTRUCTION.

D. HAZARDS CONTROL:

1.6 CLEANING

1. STORE VOLATILE WASTE IN COVERED METAL CONTAINERS, AND REMOVE FROM PREMISES DAILY.

2. PREVENT ACCUMULATION OF WASTES WHICH CREATE HAZARDOUS CONDITIONS.

3. PROVIDE ADEQUATE VENTILATION DURING USE OF VOLATILE OR NOXIOUS SUBSTANCES.

E. SECURITY ENCLOSURE AND LOCKUP: PROVIDE PROTECTION FOR MATERIALS, TOOLS AND EQUIPMENT EMPLOYED ON THE PROJECT INCLUDING THE TOOLS OF WORKMEN. THE OWNER SHALL NOT BE HELD TO HAVE INCURRED ANY LIABILITY FOR LOSS OF, OR DAMAGE

TO, MATERIALS, TOOLS AND EQUIPMENT OF THE CONTRACTOR, OR OF THOSE EMPLOYED BY HIM, BY CONTRACT OR OTHERWISE.

F. PROVIDE RECYCLE BINS DURING CONSTRUCTION WHEN WASTE HAUL SOURCES ARE AVAILABLE.

A. PARKING FOR WORKMEN MAY BE PROVIDED ON THE SITE TO THE EXTENT THAT SPACE FOR THAT PURPOSE MAY BE AVAILABLE WITHOUT INTERFERENCE WITH ACTIVITIES RELATED TO PERFORMANCE OF THE WORK. CONTRACTOR MAY PARK ONLY IN AREAS DESIGNATED BY THE OWNER FOR CONTRACTOR USE. ADDITIONAL PARKING SPACE REQUIRED BY THE CONTRACTOR SHALL BE SECURED OFF SITE AT CONTRACTOR'S EXPENSE.

A. DAILY DURING CONSTRUCTION, KEEP PREMISES AND PUBLIC PROPERTIES FREE FROM ACCUMULATIONS OF WASTE, DEBRIS, AND RUBBISH CAUSED BY OPERATIONS.

B. PROVIDE ON-SITE CONTAINERS FOR COLLECTION OF WASTE MATERIALS, DEBRIS AND RUBBISH. C. HANDLE MATERIALS IN A CONTROLLED MANNER WITH AS FEW HANDLINGS AS POSSIBLE; DO NOT DROP OR THROW MATERIALS FROM

D. CONDUCT CLEANING AND DISPOSAL OPERATIONS TO COMPLY WITH LOCAL ORDINANCES AND ANTI-POLLUTION LAWS.

1. DO NOT BURN OR BURY RUBBISH AND WASTE MATERIALS ON PROJECT SITE.

2. DO NOT DISPOSE OF VOLATILE WASTES SUCH AS MINERAL SPIRITS, OIL, OR PAINT THINNER IN STORM OR SANITARY DRAINS.

3. USE BIODEGRADABLE, PHOSPHATE-FREE CLEANING MATERIALS. E. SCHEDULE CLEANING OPERATIONS SO THAT DUST AND OTHER CONTAMINANTS RESULTING FROM CLEANING PROCESS WILL NOT FALL ON WET, NEWLY PAINTED SURFACES.

F. COMPLY WITH MANUFACTURER'S WRITTEN INSTRUCTIONS FOR CLEANING:

1. USE ONLY CLEANING MATERIALS RECOMMENDED BY MANUFACTURER OF SURFACE TO BE CLEANED

2. USE CLEANING MATERIALS ONLY ON SURFACES RECOMMENDED BY CLEANING MATERIAL MANUFACTURER. 3. USE BIODEGRADABLE, PHOSPHATE-FREE CLEANING MATERIALS.

G. IF THE CONTRACTOR FAILS TO CLEAN UP AS PROVIDED IN THE CONTRACT DOCUMENTS, THE OWNER MAY DO SO AND THE COST

THEREOF SHALL BE CHARGED TO THE CONTRACTOR.

1.7 OPERATION, TERMINATION, AND REMOVAL A. PROVIDE INSTALLATION, OPERATION, MAINTENANCE AND REMOVAL OF TEMPORARY FACILITIES, EQUIPMENT, SERVICES, UTILITIES, AND CONTROLS REQUIRED FOR THE PROSECUTION OF THE WORK. INSTALL AND MAINTAIN IN ACCORDANCE WITH APPLICABLE CODES AND

B. ENGAGE THE APPROPRIATE LOCAL UTILITY COMPANY TO INSTALL TEMPORARY SERVICE OR CONNECT TO EXISTING SERVICE. WHERE COMPANY PROVIDES ONLY PART OF THE SERVICE, PROVIDE THE REMAINDER WITH MATCHING, COMPATIBLE MATERIALS AND

EQUIPMENT. COMPLY WITH COMPANY RECOMMENDATIONS. . ARRANGE WITH COMPANY AND EXISTING USERS FOR A TIME WHEN SERVICE CAN BE INTERRUPTED, IF NECESSARY, TO MAKE CONNECTIONS FOR TEMPORARY SERVICES.

2. PROVIDE ADEQUATE CAPACITY AT EACH STAGE OF CONSTRUCTION. PRIOR TO TEMPORARY UTILITY AVAILABILITY, PROVIDE 3. OBTAIN EASEMENTS TO BRING TEMPORARY UTILITIES TO THE SITE WHERE THE OWNER'S EASEMENTS CANNOT BE USED FOR THAT

4. USE CHARGES: COST OR USE CHARGES FOR TEMPORARY FACILITIES ARE NOT CHARGEABLE TO THE OWNER OR THE ARCHITECT. NEITHER THE OWNER NOR THE ARCHITECT WILL ACCEPT COST OR USE CHARGES AS A BASIS OF CLAIMS FOR CHANGE ORDERS C. MAINTAIN STRICT SUPERVISION OF USE OF ALL TEMPORARY FACILITIES AND CONTROLS. ENFORCE COMPLIANCE WITH APPLICABLE

D. REMOVE TEMPORARY OFFICE FACILITIES, TOILETS, STORAGE SHEDS, AND OTHER CONSTRUCTION OF TEMPORARY NATURE FROM THE SITE AS SOON AS THE PROGRESS OF THE WORK WILL PERMIT. PROPERLY RECONDITION AND RESTORE THE PORTIONS OF THE SITE OCCUPIED BY TEMPORARY FACILITIES TO A CONDITION ACCEPTABLE TO THE OWNER AND AT LEAST EQUAL TO CONDITION AT TIME OF START OF WORK.

OF THE CONSTRUCTION PROCESS SHALL BE GRADED AND RE-VEGETATED PRIOR TO ACCEPTANCE BY THE OWNER.

E. ALL DISTURBED AREAS OF THE SITE INCLUDING CITY / COUNTY R.O.W. OR ADJACENT PROPERTY WHICH WERE DISTURBED AS A PART

SECTION 01600 - MATERIALS

B. PRODUCT SELECTION PROCEDURES:

SUBSTITUTIONS WILL BE PERMITTED.

STANDARDS. PREVENT ABUSE OF SERVICES.

1.1 PRODUCT REQUIREMENTS

A. PROVIDE PRODUCTS THAT COMPLY WITH THE CONTRACT DOCUMENTS, UNDAMAGED AND UNUSED AT INSTALLATION. PROVIDE PRODUCTS COMPLETE WITH ALL ACCESSORIES, TRIM, FINISH, SAFETY GUARDS AND OTHER DEVICES AND DETAILS NEEDED FOR A COMPLETE INSTALLATION AND FOR THE INTENDED USE AND EFFECT. WHERE INDICATED, INSTALL PRODUCTS FURNISHED BY THE OWNER OR TENANT

1. WHERE SPECIFICATIONS NAME ONLY A SINGLE PRODUCT OR MANUFACTURER, PROVIDE THE PRODUCT INDICATED. NO

2. WHERE SPECIFICATIONS NAME 2 OR MORE PRODUCTS OR MANUFACTURERS, PROVIDE 1 OF THE PRODUCTS INDICATED. NO

THESE REQUIREMENTS AND ARE RECOMMENDED BY THE MANUFACTURER FOR THE APPLICATION INDICATED.

4. PROVIDE MATERIALS THAT ARE LOCALLY MANUFACTURED AS APPROPRIATE TO THE DESIGN INTENT.

C. TO THE FULLEST EXTENT POSSIBLE, PROVIDE PRODUCTS OF THE SAME KIND, FROM A SINGLE SOURCE.

E. REFER TO SPECIFICATIONS AND DRAWINGS FOR MATERIALS AND STANDARDS OF CONSTRUCTION.

ADJUSTMENTS FOR FIT AND COORDINATION SHALL BE MADE AT NO ADDITIONAL COST TO THE OWNER.

MEANS AND METHODS THAT WILL PREVENT DAMAGE, DETERIORATION AND LOSS, INCLUDING THEFT.

INSTRUCTIONS FOR HANDLING, STORING UNPACKING, PROTECTING AND INSTALLING.

EASILY DAMAGED OR SENSITIVE TO DETERIORATION, THEFT AND OTHER LOSSES.

3. PROTECT EXTERIOR PAVING AND SITEWORK FROM CONSTRUCTION ACTIVITIES.

2. COMPLY WITH MANUFACTURER'S INSTRUCTIONS AND RECOMMENDATIONS.

C. A REQUEST CONSTITUTES A REPRESENTATION THAT THE CONTRACTOR:

5. WILL REIMBURSE ARCHITECT FOR REVIEW AND REDESIGN SERVICES.

EQUIVALENCE. BURDEN OF PROOF IS ON PROPOSER.

EACH PART FROM INCOMPATIBLE MATERIAL AS NECESSARY TO PREVENT DETERIORATION.

PLUMB AND LEVEL, INSTALL NEW MATERIALS AND ELEMENTS TO ALIGN WITH EXISTING.

2. EQUIPMENT NAMEPLATES: PROVIDE A PERMANENT NAMEPLATE ON EACH ITEM OF SERVICE-CONNECTED OR

SURFACES EXPOSED TO VIEW IN OCCUPIED SPACES OR ON THE EXTERIOR.

WHERE SPECIFICATIONS REQUIRE COMPLIANCE WITH PERFORMANCE REQUIREMENTS, PROVIDE PRODUCTS THAT COMPLY WITH

1. EXCEPT FOR REQUIRED LABELS AND OPERATING DATA, DO NOT ATTACH MANUFACTURER'S NAMEPLATES OR TRADEMARKS ON

POWER-OPERATED EQUIPMENT. LOCATE ON AN INCONSPICUOUS ACCESSIBLE SURFACE. THE NAMEPLATE SHALL CONTAIN THE

FOLLOWING INFORMATION AND ESSENTIAL OPERATING DATA: NAME OF PRODUCT AND MANUFACTURER, MODEL AND SERIAL

A. CONTRACTOR TO VERIFY SIZE, CHARACTERISTICS, AND REQUIRED CLEARANCES OF ALL EQUIPMENT TO BE FURNISHED WITH

1. DELIVER PRODUCTS TO THE SITE IN THE MANUFACTURER'S ORIGINAL SEALED CONTAINER COMPLETE WITH LABELS AND

1. STORE PRODUCTS AT THE SITE IN A MANNER THAT WILL FACILITATE INSPECTION AND MEASUREMENT OF QUANTITY OR

2. STORE HEAVY MATERIALS AWAY FROM THE PROJECT STRUCTURE IN A MANNER THAT WILL NOT ENDANGER THE SUPPORTING

3. STORE PRODUCTS SUBJECT TO DAMAGE BY THE ELEMENTS ABOVE GROUND, UNDER COVER IN A WEATHER-TIGHT ENCLOSURE,

PROTECT ALL FINISHED SURFACES, INCLUDING JAMBS AND SOFFITS OF ALL OPENINGS USED AS PASSAGEWAYS OR THROUGH

2. PROTECT FINISHED FLOOR SURFACES BEFORE MOVING ANY MATERIAL AND EQUIPMENT OVER THESE FINISHED SURFACES.

1. INSPECT THE SUBSTRATE AND CONDITIONS UNDER WHICH WORK IS PERFORMED. DO NOT PROCEED UNTIL UNSATISFACTORY

PROVIDE ATTACHMENT AND CONNECTION DEVICES AND METHODS NECESSARY FOR SECURING EACH CONSTRUCTION ELEMENT.

5. INSTALL SQUARE, LEVEL, PLUMB AND ACCURATELY ALIGNED. WHERE EXISTING ADJACENT MATERIALS AND ELEMENTS ARE NOT

CLEAN EXPOSED SURFACES AND PROTECT TO ENSURE FREEDOM FROM DAMAGE AND DETERIORATION AT TIME OF SUBSTANTIAL

A. SUBSTITUTIONS DURING BIDDING WILL BE REVIEWED BY THE ARCHITECT UP TO 5 WORKING DAYS PRIOR TO BIDS. SUBSTITUTIONS

B. DOCUMENT EACH REQUEST WITH COMPLETE DATA SUBSTANTIATING COMPLIANCE OF PROPOSED SUBSTITUTION WITH CONTRACT

1. HAS INVESTIGATED PROPOSED PRODUCT AND DETERMINED THAT IT MEETS OR EXCEEDS THE QUALITY LEVEL OF THE SPECIFIED

MUST BE FORMALLY REQUESTED FROM THE CONTRACTOR FOR PRODUCTS IN PLACE OF THOSE SPECIFIED.

2. WILL PROVIDE THE SAME OR GREATER WARRANTY FOR THE SUBSTITUTION AS FOR THE SPECIFIED PRODUCT.

4. WAIVES CLAIMS FOR ADDITIONAL COSTS OR TIME EXTENSION WHICH MAY SUBSEQUENTLY BECOME APPARENT.

D. SUBSTITUTIONS WILL NOT BE CONSIDERED WHEN THEY ARE INDICATED OR IMPLIED ON SHOP DRAWING OR PRODUCT DATA

SUBMITTALS, WITHOUT SEPARATE WRITTEN REQUEST, OR WHEN ACCEPTANCE WILL REQUIRE REVISION TO THE CONTRACT

1. SUBMIT A FORMAL SUBSTITUTION REQUEST FOR CONSIDERATION. LIMIT EACH REQUEST TO ONE PROPOSED SUBSTITUTION.

2. SUBMIT SHOP DRAWINGS, PRODUCT DATA, AND CERTIFIED TEST RESULTS ATTESTING TO THE PROPOSED PRODUCT

4. INSTALL EACH COMPONENT DURING WEATHER CONDITIONS AND PROJECT STATUS THAT WILL ENSURE THE BEST RESULTS. ISOLATE

WITH VENTILATION ADEQUATE TO PREVENT CONDENSATION. MAINTAIN TEMPERATURE AND HUMIDITY WITHIN RANGE REQUIRED BY

MANUFACTURERS OR SUPPLIERS PRIOR TO CONSTRUCTION. NOTIFY ARCHITECT OF ANY DISCREPANCIES FOR CLARIFICATION.

B. TRANSPORT, DELIVER, STORE AND HANDLE PRODUCTS IN ACCORDANCE WITH THE MANUFACTURER'S WRITTEN INSTRUCTIONS, USING

C. COORDINATE DELIVERY WITH INSTALLATION TIME TO ENSURE MINIMUM HOLDING TIME FOR ITEMS THAT ARE FLAMMABLE, HAZARDOUS

SUBSTITUTIONS WILL BE PERMITTED.

NUMBER, CAPACITY, SPEED, AND RATINGS.

1.2 DELIVERY, STORAGE AND HANDLING

D. NAMEPLATES:

D. STORAGE:

E. PROTECTION:

F. INSTALLATION:

1.3 SUBSTITUTIONS

COUNTING OF UNITS.

MANUFACTURER'S INSTRUCTIONS.

CONDITIONS HAVE BEEN CORRECTED.

COMPLETION AND FINAL ACCEPTANCE.

WITH NO ADDITIONAL COST TO THE OWNER.

E. SUBSTITUTION SUBMITTAL PROCEDURE:

AND RETURNED TO THE CONTRACTOR.

SECTION 04200 - UNIT MASONRY

WHICH MATERIALS AND EQUIPMENT ARE HANDLED.

ALLOW FOR EXPANSION AND BUILDING MOVEMENT.

CONSTRUCTION.

DOCUMENTS.

A. PROVIDE TWO (2) SAMPLES OF EACH TYPE OF SPECIFIED BLOCK TO THE ARCHITECT. INCLUDE SILL PIECE. B. MOCK UP (IF INDICATED ON DRAWINGS): REFER TO DRAWINGS FOR MOCK UP ELEVATION. MOCK UP SHALL REPRESENT ALL ASPECTS OF THE MASONRY SYSTEM INCLUDING ALL MASONRY TYPES, COLOR RANGE, COURSING, MORTAR COLOR AND JOINT STYLE. MOCK UP

3. THE ARCHITECT WILL NOTIFY CONTRACTOR IN WRITING OF DECISION TO ACCEPT OR REJECT REQUEST. THE ARCHITECT'S DECISION

4. ANY SUBSTITUTION REQUEST NOT FORMALLY SUBMITTED WITHIN THE TIMEFRAME AND AS DISCUSSED HEREIN, WILL BE REJECTED

A. PROTECTION OF MASONRY: DURING ERECTION, COVER TOPS OF WALLS, PROJECTIONS, AND SILLS WITH WATERPRO (SHEETING) AT END OF EACH DAY'S WORK. COVER PARTIALLY COMPLETED MASONRY WHEN CONSTRUCTION IS NOT IN PROGRESS.

1.2 PROJECT CONDITIONS

2.1 CONCRETE MASONRY UNITS A. CONCRETE MASONRY UNITS: ASTM C 90 AND AS FOLLOWS:

IN ACCEPTANCE OR REJECTION OF PROPOSED SUBSTITUTIONS SHALL BE FINAL.

1. MANUFACTURER AND COLORS: AS INDICATED ON DRAWINGS. 2. WEIGHT CLASSIFICATION: LIGHT WEIGHT (ABOVE GRADE) AND NORMAL WEIGHT (BELOW GRADE).

3. SIZE: NOMINAL SIZES AS INDICATED ON DRAWINGS: 4. FINISH: EXPOSED FACES MATCHING COLOR, PATTERN, AND TEXTURE OF APPROVED SAMPLES.

SHALL BE APPROVED BY THE OWNER BEFORE MASONRY WORK ON BUILDING COMMENCES.

5. REFERENCE SECTION 9900 FOR FINISH REQUIREMENTS. 2.2 MORTAR AND GROUT MATERIALS

COLOR TO MATCH MASONRY UNITS. B. MASONRY CEMENT: ASTM C91. C. HYDRATED LIME: ASTM C 207, TYPE S. D. PORTLAND CEMENT-LIME MIX: PACKAGED BLEND OF PORTLAND CEMENT COMPLYING WITH ASTM C 150, TYPE I OR TYPE III, AND HYDRATED LIME COMPLYING WITH ASTM C 207.

A. PORTLAND CEMENT: ASTM C 150, TYPE I OR II. PROVIDE NATURAL COLOR OR WHITE CEMENT AS REQUIRED TO PRODUCE MORTAR

E. AGGREGATE FOR MORTAR: ASTM C 144; EXCEPT FOR JOINTS LESS THAN 1/4 INCH, USE AGGREGATE GRADED WITH 100 PERCENT PASSING THE NO. 16 SEIVE. F. AGGREGATE FOR GROUT: ASTM C 404. G. ADMIXTURES: PROVIDE WATER REPELLANT ADD MIXTURES IN MASONRY BLOCK AND MORTAR FOR MASONRY THAT DOES NOT

RECEIVED A PAINTED FINISH. H. APPLY A LIQUID APPLIED WATER REPELLANT TO MASONRY THAT DOES NOT RECEIVE A PAINTED FINISH I. WATER: POTABLE.

2.3 REINFORCING STEEL

2.4 JOINT REINFORCEMENT

A. STEEL REINFORCING BARS: BILLET STEEL COMPLYING WITH ASTM A 615.

INCHES O.C. WIRE DIAMETER FOR SIDE RODS AND CROSS RODS: 0.1483 INCH.

A. GENERAL: PROVIDE JOINT REINFORCEMENT FORMED FROM THE FOLLOWING: 1. GALVANIZED CARBON-STEEL WIRE, COATING CLASS AS FOLLOWS: ASTM A 153, CLASS B-2, FOR EXTERIOR WALLS. B. DESCRIPTION: WELDED-WIRE UNITS PREFABRICATED WITH DEFORMED CONTINUOUS SIDE RODS AND PLAIN CROSS RODS INTO STRAIGHT LENGTHS OF NOT LESS THAN 10 FEET. WITH PREFABRICATED CORNER AND TEE UNITS.

1. PROVIDE LADDER TYPE DESIGN WITH SINGLE PAIR OF SIDE RODS AND PERPENDICULAR CROSS RODS SPACED NOT MORE THAN 16

2.5 INSULATION

A. USE CORE-FILL 500 AS MANUFACTURERED BY TAILORED CHEMICAL PRODUCTS, 800.627.1687 OR APPROVED EQUAL. B. INSTALL PER MANUFACTURER'S INSTALLATION GUIDELINES. FILL ALL OPEN CELLS AND VOIDS IN MASONRY. THE FOAM INSULATION SHALL BE PRESSURE INJECTED THROUGH A SERIES OF 5/8" TO 7/8" HOLES DRILLED INTO EVERY VERTICAL COLUMN OF BLOCK CELLS (EVERY 8" ON CENTER) BEGINNING AT AN APPROXIMATE HEIGHT OF FOUR (4) FEET FROM FINISHED FLOOR LEVEL. REPEAT THE PROCEDURE AT APPROX. HEIGHT OF 10 FEET ABOVE THE FIRST HORIZONTAL ROW OF HOLES (OR AS NEEDED) UNTIL THE VOID IS COMPLETELY FILLED. PATCH HOLES WITH MORTAR AND SCORE TO RESEMBLE EXISTING SURFACE.

2.6 MORTAR AND GROUT MIXES A. GENERAL: DO NOT USE ADMIXTURES, AIR-ENTRAINING AGENTS, ACCELERATORS, RETARDERS, WATER-REPELLENT AGENTS,

ANTIFREEZE COMPOUNDS. OR OTHER ADMIXTURES FOR MASONRY THAT WILL RECEIVE A PAINTED FINISH UNLESS OTHERWISE

+engineering 2809 Aiax Avenue Suite 100 Rogers Arkansas 72758 Phone: 479.636.3545 Fax: 479.636.1209 Architect of Record

Scott Joseph Broadben Florida License No. AR 97891 Architect Business Lic No. AA26000940

ISSUE BLOCK 3. WILL COORDINATE INSTALLATION AND MAKE CHANGES TO OTHER WORK WHICH MAY BE REQUIRED FOR THE WORK TO BE COMPLETE CHECKED BY:

DRAWN BY:

DOCUMENT DATE: 11.06.2023



SIGNATURE SHALL BE CONSIDERED NOT FOR CONSTRUCTION CONST.

DOCUMENTS WITHOUT AN ARCHITECT

CS1.0

1. DO NOT USE CALCIUM CHLORIDE IN MORTAR OR GROUT. B. MORTAR FOR UNIT MASONRY: COMPLY WITH ASTM C 270, PROPORTION SPECIFICATION, FOR TYPE S. THOROUGHLY MIX MORTAR INGREDIENTS IN ACCORDANCE WITH ASTM C270, IN QUANTITIES NEEDED FOR IMMEDIATE USE. MAINTAIN SAND UNIFORMLY DAMP IMMEDIATELY BEFORE THE MIXING PROCESS.

2. PROVIDE UNIFORMITY OF MIX AND COLORATION. 3. IF WATER IS LOST BY EVAPORATION, RETEMPER ONLY WITHIN 2 HOURS OF MIXING. DO NOT RETEMPER MORTAR MORE THAN (2) HOURS AFTER MIXING.

C. GROUT FOR UNIT MASONRY: COARSE GROUT (3/8" DIAMETER (MAX) AGGREGATE), IN ACCORDANCE WITH ASTM C476.

1. COMPRESSIVE STRENGTH: 2000 PSI (MIN) AT 28 DAYS, AS DETERMINED IN ACCORDANCE WITH ASTM C1019. 2. SLUMP: 8 INCHES, MINIMUM; 10 INCHES, MAXIMUM, TAKEN IN ACCORDANCE WITH ASTM C143.

SECTION 04210 - VENEER MASONRY

1.1 SUBMITTALS

A. INITIAL SAMPLES FOR VERIFICATION: 1. FULL-SIZED UNITS FOR EACH DIFFERENT EXPOSED MASONRY UNIT REQUIRED SHOWING THE FULL RANGE OF COLOR, TEXTURE AND DIMENSIONS TO BE EXPECTED IN THE FINISHED CONSTRUCTION. 2. COLORED MASONRY MORTAR SAMPLES FOR EACH COLOR REQUIRED SHOWING THE FULL RANGE OF COLORS TO BE EXPECTED IN

THE FINISHED CONSTRUCTION. B. MOCK UP (WHEN INDICATED ON DRAWINGS): REFER TO DRAWINGS FOR MOCK UP ELEVATION. MOCK UP SHALL REPRESENT ALL ASPECTS OF THE MASONRY SYSTEM INCLUDING ALL MASONRY TYPES, COLOR RANGE, COURSING, MORTAR COLOR AND JOINT STYLE. MOCK UP SHALL BE APPROVED BY THE ARCHITECT BEFORE MASONRY WORK ON BUILDING COMMENCES.

2.1 MASONRY VENEER

A. BRICK: AS INDICATED ON DRAWINGS. B. STONE: AS INDICATED ON DRAWINGS.

C. CUT LIMESTONE: AS INDICATED ON DRAWINGS.

A. READY-MIX MORTAR: CEMENTITIOUS MATERIALS, WATER, AND AGGREGATE COMBINED WITH SET-CONTROLLING ADMIXTURES TO PRODUCE A READY-MIXED MORTAR COMPLYING WITH ASTM C 1142.

1. PORTLAND CEMENT-LIME MIX: ASTM C150, TYPE I OR TYPE III AND HYDRATED LIME COMPLYING WITH ASTM C 2072. MORTAR AGGREGATE: ASTM C 144, EXCEPT FOR JOINTS LESS THAN 1/4 INCH, USE AGGREGATE GRADED WITH 100 PERCENT PASSING

3. COLOR: AS SELECTED BY THE ARCHITECT FROM MANUFACTURER'S STANDARDS. B. EPOXY POINTING MORTAR: ASTM C 395, EPOXY-RESIN-BASED MATERIAL FORMULATED FOR USE AS POINTING MORTAR.

2.3 ACCESSORIES

2.2 MORTAR

1. SHEET METAL FLASHING: AS SPECIFIED IN SECTION 07620 AND AS INDICATED.

2. RUBBERIZED ASPHALT SHEET FLASHING: PERM-A-BARRIER BY W.R. GRACE, OR EQUAL. PROVIDE WITH MANUFACTURER'S RECOMMENDED PRODUCT FOR BONDING FLASHING SHEETS. 3. MASONRY TIES: ADJUSTABLE TWO-PIECE TYPE WITH TIES EXTENDING INTO FACING WYTHE. TIES SHALL EXTEND AT LEAST HALF-WAY

INTO FACING WYTHE WITH AT LEAST 5/8 INCH MORTAR COVER ON OUTSIDE FACE. CORRUGATED TIES ARE NOT ACCEPTABLE. EXPANSION JOINTS: PREFORMED NEOPRENE. D. WEEPS: WICKING MATERIAL TO BE COTTON SASH CORD OR FIBROUS GLASS ROPE.

E. VAPOR-RETARDING COATING: SONNEBORN HYDROCIDE 700B OR APPROVED EQUAL. F. ADJUSTABLE MASONRY VENEER ANCHOR: 2-PIECE ASSEMBLY ALLOWING VERTICAL AND HORIZONTAL DIFFERENTIAL MOVEMENT BETWEEN WALL FRAMING AND VENEER BUT RESISTING 100 LBF TENSION AND COMPRESSION FORCES PERPENDICULAR TO ATTACH

OVER SHEATHING TO STRUCTURE. G. CAVITY DRAINAGE MATERIAL: 1 INCH THICK, RETICULATED, NONABSORBENT MESH BY MORTAR NET. MAINTAIN DRAINAGE AT WEEP HOLES WITHOUT BEING CLOGGED BY MORTAR DROPPINGS

3.1 INSTALLATION

A. PLACE MASONRY TO LINES AND LEVELS INDICATED ON DRAWINGS

1. SECURE WALL TIES FOR VENEER IN BACK-UP AT A MAXIMUM 16 INCHES O.C. VERTICALLY AND 24 INCHES O.C. HORIZONTALLY. 2. LAY MASONRY IN A FULL BED OF MORTAR FULLY BUTTERING CORNERS AND HEAD JOINTS.

MORTAR JOINTS: CONCAVE STYLE UNLESS NOTED OTHERWISE. 4. INSTALL WEEP HOLES IN VENEER AT 32 INCHES O.C. HORIZONTALLY ABOVE THRU-WALL FLASHINGS, ABOVE SHELF ANGLES, AND AT

BOTTOM OF WALLS. 5. FLASHING: EXTEND FLASHINGS THROUGH VENEER, TURN UP MINIMUM 8 INCHES AND SEAL. LAP END JOINTS MINIMUM 6 INCHES AND SEAL WATERTIGHT.

A. DO NOT TRIM EXPOSED THROUGH WALL FLASHING UNTIL AFTER APPLICABLE INSPECTIONS INCLUDING THOSE BY THE ARCHITECT IF 6. BUILT-IN WORK: AS WORK PROGRESSES, BUILD IN FABRICATED METAL FRAMES, LINTELS, WINDOW FRAMES, ANCHOR BOLTS, AND

B. CLEANING: KEEP FACE OF MASONRY BRUSHED CLEAN OF MORTAR AS WORK IS LAID UP. USE SURE CLEAN OR OTHER MASONRY CLEANER RECOMMENDED BY BRICK MANUFACTURER FOR FINAL CLEANING.

SECTION 05500 - MISCELLANEOUS METALS

1.1 SUBMITTALS

A. SHOP DRAWINGS DETAILING FABRICATION OF HAND RAIL AND GUARDRAIL SYSTEM. 1. INCLUDE DETAILS OF CUTS, CONNECTIONS, SPLICES, CAMBER, HOLES, AND OTHER PERTINENT DATA.

2. INDICATE WELDS BY STANDARD AWS SYMBOLS, DISTINGUISHING BETWEEN SHOP AND FIELD WELDS, AND SHOW SIZE, LENGTH, AND

INDICATE CONNECTION TO ADJACENT MATERIALS AND TO STRUCTURE AS APPROPRIATE.

4. ALL HANDRAILS AND GUARDRAILS SHALL BE ENGINEERED AND DETAILED TO WITHSTAND THE LOADS REQUIRED BY CODE. THE FABRICATOR SHALL PROVIDE SHOP DRAWINGS SIGNED AND SEALED BY A PROFESSIONAL ENGINEER.

A. WELDING MATERIALS: AWS D1.1 AND AWS D1.3 TYPE REQUIRED FOR MATERIALS BEING WELDED B. FASTENERS: PROVIDE BOLTS, NUTS, LAG BOLTS, MACHINE SCREWS, WOOD SCREWS, TOGGLE BOLTS, LOCK WASHERS, CLIPS, AND OTHER FASTENERS AS REQUIRED FOR APPLICATION INDICATED. 1. BOLTS, NUTS, AND WASHERS: ASTM A 325 AND ASTM A 307.

2. PROVIDE EXPOSED FASTENERS OF THE SAME MATERIAL, COLOR, AND FINISH AS THE METAL BEING FASTENED. 3. PROVIDE CONCEALED FASTENERS WHICH ARE COMPATIBLE WITH MATERIAL AND SUBSTRATE AND DO NOT PROMOTE GALVANIC OR ELECTROLYTIC CORROSIVE EFFECTS

C. ANCHORS AND INSERTS: FURNISH AS REQUIRED FOR INSTALLATION IN OTHER WORK. USE CADMIUM PLATED OR GALVANIZED ANCHORS AND INSERTS FOR EXTERIOR WORK D. NONSHRINK, NONMETALLIC GROUT: FACTORY-PACKAGED, NONSTAINING, NONCORROSIVE, NONGASEOUS GROUT COMPLYING WITH

ASTM C 1107. PROVIDE GROUT SPECIFICALLY RECOMMENDED BY MANUFACTURER FOR INTERIOR AND EXTERIOR APPLICATIONS. EPOXY GROUT FOR RAILINGS: HILTI HIGH STRENGTH EPOXY GROUT, CG500EP. . SHOP PRIMER FOR FERROUS METAL: FAST-CURING, LEAD- AND CHROMATE-FREE, UNIVERSAL MODIFIED-ALKYD PRIMER COMPLYING

WITH PERFORMANCE REQUIREMENTS OF FS TT-P-664, SELECTED FOR GOOD RESISTANCE TO NORMAL ATMOSPHERIC CORROSION, COMPATIBILITY WITH FINISH PAINT SYSTEMS INDICATED, AND CAPABILITY TO PROVIDE A SOUND FOUNDATION FOR FIELD-APPLIED F. GALVANIZING REPAIR PAINT: HIGH-ZINC-DUST-CONTENT PAINT FOR REGALVANIZING WELDS IN GALVANIZED STEEL, WITH DRY FILM

CONTAINING NOT LESS THAN 94 PERCENT ZINC DUST BY WEIGHT, AND COMPLYING WITH ASTM A780 OR SSPC-PAINT 20.

2.2 FABRICATION A. CLEAN AND DRESS ALL EXPOSED WELDS. MILL JOINTS TO TIGHT HAIRLINE FIT; COPE OR MITER CORNERS.

B. PREASSEMBLE ITEMS IN THE SHOP TO THE GREATEST EXTENT POSSIBLE, MINIMIZING FIELD SPLICING AND ASSEMBLY OF UNITS AT THE PROJECT SITE. : WELDING:

1. WELD CORNERS AND SEAMS CONTINUOUSLY TO COMPLY WITH AWS RECOMMENDATIONS. USE MATERIALS AND METHODS THAT MINIMIZE DISTORTION AND DEVELOP STRENGTH AND CORROSION RESISTANCE OF BASE METALS. OBTAIN FUSION WITHOUT UNDERCUT OR OVERLAP. REMOVE WELDING FLUX IMMEDIATELY. 2. FINISH EXPOSED WELDS AND SURFACES SMOOTH AND BLENDED SO THAT NO ROUGHNESS SHOWS AFTER FINISHING AND CONTOUR

OF WELDED SURFACE MATCHES THOSE ADJACENT. D. FABRICATED ITEMS: FABRICATED ITEMS INCLUDE BUT ARE NOT NECESSARILY LIMITED TO THE FOLLOWING. PROVIDE MISCELLANEOUS METAL FABRICATIONS AS REQUIRED TO COMPLETE THE ENTIRE WORK. . HANDRAILS AND GUARDRAILS: COLD ROLLED STEEL IN SHAPES AND DIMENSIONS INDICATED ON DRAWINGS

2. EXTERIOR BOLLARDS: SCHEDULE 40 STEEL PIPE FILLED WITH CONCRETE AND ROUNDED CONCRETE CAP. REFER TO DRAWINGS FOR EMBEDMENT, EXPOSURE, AND STUD ANCHORS.

2.3 FINISHES

A. COMPLY WITH NAAMM "METAL FINISHES MANUAL" FOR APPLICATION AND DESIGNATION OF FINISHES. PROTECT FINISHED METAL ITEMS.

APPLY A BITUMINOUS PAINT OF APPROXIMATELY 0.75 MM DRY FILM THICKNESS, OR OTHER SUITABLE PERMANENT SEPARATOR, ON CONCEALED CONTACT SURFACES OF DISSIMILAR MATERIALS, BEFORE ASSEMBLY AND INSTALLATION, WHERE THERE IS THE POSSIBILITY OF CORROSIVE OR ELECTROLYTIC ACTION. 1. GALVANIZING: ASTM A 123, ASTM A153, OR ASTM A386 AS APPLICABLE.

3.1 INSTALLATION

A. WHERE CUTTING, WELDING AND GRINDING ARE REQUIRED FOR PROPER FITTING AND JOINTING OF ORNAMENTAL METAL RESTORE FINISHES TO ELIMINATE ANY EVIDENCE OF SUCH CORRECTIVE WORK. 1. TOUCH-UP SHOP FINISH AFTER INSTALLATION. CLEAN FIELD WELDS, BOLTED CONNECTIONS AND ABRADED AREAS, AND APPLY SAME

2. USE GALVANIZING REPAIR PAINT ON DAMAGED GALVANIZED SURFACES IN ACCORDANCE WITH ASTM A780.

SECTION 06100 - ROUGH CARPENTRY

2.1 MATERIALS

A. WOOD PRESERVATIVE TREATED MATERIALS: WHERE LUMBER OR PLYWOOD IS INDICATED AS PRESERVATIVE TREATED, COMPLY WITH APPLICABLE REQUIREMENTS OF AWPA C2 (LUMBER) AWPA C9 (PLYWOOD). MARK EACH TREATED ITEM WITH THE QUALITY MARK REQUIREMENTS OF AN INSPECTION AGENCY APPROVED BY ALSC'S BOARD OF REVIEW. B. PRESSURE TREAT ABOVE GROUND ITEMS WITH WATERBOURNE PRESERVATIVES TO A MINIMUM RETENTION OF 0.25 LB/CUBIC FEET.

AFTER TREATMENT, KILN DRY LUMBER AND PLYWOOD TO A MAXIMUM MOISTURE CONTENT OF 19 AND 15 PERCENT RESPECTIVELY. . WOOD CANTS, NAILERS, CURBS, EQUIPMENT SUPPORT BASES, BLOCKING, STRIPPING AND SIMILAR MEMBERS IN CONNECTION WITH

ROOFING, FLASHING, VAPOR BARRIERS, AND WATERPROOFING. 2. WOOD SILLS, SLEEPERS, BLOCKING, FURRING STRIPPING, AND SIMILAR MEMBERS IN CONTACT WITH MASONRY OR CONCRETE. 3. IF MEMBERS ARE CUT AFTER TREATMENT, APPLY FIELD TREATMENT COMPLYING WITH AWPA M4 TO CUT SURFACES. PRESERVATIVE TREATMENT BY PRESSURE PROCESS: AWPA C2, EXCEPT THAT LUMBER THAT IS NOT IN CONTACT WITH THE GROUND AND IS

CONTINUOUSLY PROTECTED FROM LIQUID WATER MAY BE TREATED ACCORDING TO AWPA C31 WITH INORGANIC BORON (SBX). PRESERVATIVE CHEMICALS: ACCEPTABLE TO AUTHORITIES HAVING JURISDICTION AND CONTAINING NO ARSENIC OR CHROMIUM. PROVIDE FIRE RETARDANT TREATED BLOCKING AT LOCATIONS ON THE INTERIOR OF THE BUILDING.

2.2 MISCELLANEOUS LUMBER

A. GENERAL: PROVIDE LUMBER FOR SUPPORT OR ATTACHMENT OF OTHER CONSTRUCTION, INCLUDING ROOFTOP EQUIPMENT CURBS AND SUPPORT BASES, CANT STRIPS, BUCKS, NAILERS, BLOCKING, FURRING, GROUNDS, STRIPPING, AND SIMILAR MEMBERS. B. MOISTURE CONTENT: 19 PERCENT MAXIMUM FOR LUMBER ITEMS NOT SPECIFIED TO RECEIVE WOOD PRESERVATIVE TREATMENT. C. GRADE: FOR DIMENSION LUMBER SIZES, PROVIDE NO. 3 OR STANDARD GRADE LUMBER PER ALSC'S NGR'S OF ANY SPECIES. FOR

BOARD-SIZE LUMBER, PROVIDE NO. 3 COMMON GRADE PER NELMA, NLGA, OR WWPA; NO. 2 GRADE PER SPIB; OR STANDARD GRADE PER NLGA. WCLIB OR WWPA OF ANY SPECIES. D. FOR THE FOLLOWING WOOD PRODUCTS, PROVIDE MATERIALS PRODUCED FROM WOOD FROM NON-TROPICAL FORESTS:

 PLYWOOD. E. PROVIDE FIRE RETARDANT, TREATED PLYWOOD OR 18 GAUGE SHEET METAL FOR BLOCKING AT LOCATIONS ON THE INTERIOR OF THE

2.3 FASTENERS

A. GENERAL: PROVIDE FASTENERS OF SIZE AND TYPE INDICATED THAT COMPLY WITH REQUIREMENTS SPECIFIED IN THIS ARTICLE OR MATERIAL AND MANUFACTURER. WHERE ROUGH CARPENTRY IS EXPOSED TO WEATHER, IN GROUND CONTACT OR IN AN AREA OF HIGH RELATIVE HUMIDITY, PROVIDE FASTENERS WITH A HOT-DIP ZINC COATING PER ASTM A153 OR OF TYPE 304 STAINLESS STEEL.

C. POWER DRIVEN FASTENERS: REFER TO TABLE 2304.9.1 "FASTENING SCHEDULE" PER BUILDING CODE LISTED ON CVR - COVER SHEET D. WOOD SCREWS ASME B1fT6/L

E. LAG BOLTS: ASME B18.2.1. F. BOLTS: STEEL BOLTS COMPLYING WITH ASTM A 307, GRADE A WITH ASTM A563 HEX NUTS AND FLAT WASHERS.

FOLLOWING:

2.1 MATERIALS

SLATWALL:

3.1 INSTALLATION

1.1 SUBMITTALS

2.1 MATERIALS

ASTM D1910, ASTM D781.

3.1 INSTALLATION

2.1 MATERIALS

C. FINISH: MEDIUM SAND.

SUBSTRATE APPLICATION.

INDICATED ON DRAWINGS.

WALL HEIGHT CHANGES

3.1 INSTALLATION

1.1 SUBMITTALS

WARRANTY PERIOD

INSTALLATION.

2.1 METAL ROOF PANELS

6. PANEL COVERAGE: 16 INCH.

7. PANEL HEIGHT: 2 INCH.

2.2 METAL WALL PANELS

INDICATED ON DRAWINGS.

A. PRODUCT TEST REPORTS.

WOODWORK INDICATED:

4. PLASTIC LAMINATES:

CUSTOM GRADE QUALITY.

MATERIALS AVAILABLE.

FASTENERS.

A. SET ROUGH CARPENTRY TO REQUIRED LEVELS AND LINES, WITH MEMBERS PLUMB, TRUE TO LINE, CUT, AND FITTED. B. FIT ROUGH CARPENTRY TO OTHER CONSTRUCTION; SCRIBE AND COPE AS REQUIRED FOR ACCURATE FIT. CORRELATE LOCATION OF

3.1 INSTALLATION

FURRING, NAILERS, BLOCKING, GROUNDS, AND SIMILAR SUPPORTS TO ALLOW ATTACHMENT OF OTHER CONSTRUCTION. C. SECURELY ATTACH ROUGH CARPENTRY TO SUBSTRATE BY ANCHORING AND FASTENING AS INDICATED, COMPLYING WITH THE

1. REFER TO TABLE 2304.9.1 IN THE ICC'S INTERNATIONAL BUILDING CODE FOR POWER DRIVEN STAPLES, P-NAILS, AND ALLIED

"RECOMMENDED NAILING SCHEDULE" OF REFERENCED FRAMING STANDARD AND WITH THE AFPA'S "NATIONAL DESIGN

D. USE COMMON WIRE NAILS, UNLESS OTHERWISE INDICATED. USE FINISHING NAILS FOR FINISH WORK. SELECT FASTENERS OF SIZE

MAKE TIGHT CONNECTIONS BETWEEN MEMBERS. INSTALL FASTENERS WITHOUT SPLITTING WOOD; PREDRILL AS REQUIRED.

A. INSTALL WOOD GROUNDS, NAILERS, BLOCKING AND SLEEPERS WHERE SHOWN AND WHERE REQUIRED FOR SCREENING AND

B. ATTACH TO SUBSTRATES TO SUPPORT APPLIED LOADING. RECESS BOLTS AND NUTS FLUSH WITH SURFACES, UNLESS

1. MEDIUM DENSITY FIBERBOARD (MDF) WAINSCOT: LOCATIONS AND DIMENSIONS AS INDICATED ON DRAWINGS.

A. INSTALL FINISH CARPENTRY WORK PLUMB, LEVEL, TRUE, AND STRAIGHT WITH NO DISTORTIONS. SHIM AS REQUIRED USING

B. INSTALL FINISH CARPENTRY WITH MINIMUM NUMBER OF JOINTS AS POSSIBLE, USING FULL LENGTH FROM MAXIMUM LENGTH OF

D. ANCHOR FINISH CARPENTRY TO ANCHORS OR BLOCKING BUILT IN OR DIRECTLY ATTACHED TO SUBSTRATES. SECURE TO GROUNDS,

INSTALLATION. USE FINISHING NAILS FOR EXPOSED NAILING. ALL COUNTERSUNK FASTENERS SHALL BE FILLED FLUSH AND SHALL

E. PAINT, STAIN, AND SEALER: SAND FINISH ALL EXPOSED WOOD SURFACES TO RECEIVE PAINT, STAIN, OR SEALER. APPLY PAINT, STAIN

OR SEALER IN STRICT ACCORDANCE WITH MANUFACTURER'S RECOMMENDATIONS. PROVIDE TWO (2) COATS MINIMUM ON ALL WOOD

STRIPPING AND BLOCKING WITH COUNTERSUNK, CONCEALED FASTENERS AND BLIND NAILING AS REQUIRED FOR COMPLETE

F. FRP PANELING AND PLASTIC LAMINATES: COMPLY WITH THE PANELING MANUFACTURER'S INSTRUCTIONS USING ADHESIVE AS

A. BATT INSULATION: TO ACHIEVE A DESIGN R VALUE OF 19, UNFACED FIBERGLASS COMPLYING WITH ASTM C 665, OF WIDTHS TO

C. SOUND ATTENUATION BATTS: 3-1/2 INCHES UNFACED. WIDTHS TO COMPLETELY FILL VOIDS FORMED BY FRAMING MEMBERS.

POLYSTYRENE FOAM INSULATION OR APPROVED EQUAL. PRODUCT SHALL BE EXTRUDED-POLYSTRENE BOARD INSULATION;

E. VINYL REINFORCED INSULATION AT METAL BUILDING R PANEL ROOF SYSTEM SHALL BE MINUMUM R-19. COMPLY WITH ASTM E84

1. EXTEND INSULATION FULL THICKNESS OVER ENTIRE SURFACE TO BE INSULATED TO PROVIDE AN UNINTERRUPTED THERMAL

C. PRIOR TO CLOSING-IN OF INSULATED ASSEMBLIES, OR PRIOR TO SUBSTANTIAL COMPLETION FOR INSULATION THAT WILL REMAIN

2. INSULATE IRREGULARLY SHAPED AREAS BETWEEN CLOSELY SPACED FRAMING MEMBERS WITH CUT-TO-FIT INSULATION.

SECTION 07240 - EXTERIOR INSULATION FINISH SYSTEM (EIFS)

PRODUCT DATA: MANUFACTURER'S SPECIFICATIONS, DETAILS, INSTALLATION INSTRUCTIONS, AND PRODUCT DATA.

EXPOSED IN THE BUILDING, REFIT, REINSTALL AND/OR REPLACE DAMAGED AND DISPLACED INSULATION.

2. PROVIDE STANDARD PLUS (OR EQUAL) MEDIUM IMPACT REINFORCING MESH AT ALL OTHER AREAS.

G. ONE-COAT STUCCO WALL SYSTEM TO BE PAINTED TO MATCH ADJACENT SURFACES OR AS NOTED.

SECTION 07410 - METAL ROOF AND WALL PANELS

a. STRUCTURAL FAILURES, INCLUDING RUPTURING, CRACKING, OR PUNCTURING.

2. WARRANTY PERIOD: ONE YEAR FROM DATE OF SUBSTANTIAL COMPLETION.

TYPE: VERTICAL RIB, SEAMED JOINT AS INDICATED ON DRAWINGS.

9. SOLAR REFLECTANCE INDEX (SRI) EQUAL TO OR GREATHER THAN 29.

FINISH: PRE-FINISHED GALVALUME, UNLESS OTHERWISE INDICATED ON DRAWINGS.

5. JOINT TYPE: AS STANDARD WITH MANUFACTURER.

10. LOCATION: AS INDICATED ON DRAWINGS.

LOCATION: AS INDICATED ON DRAWINGS.

A. MANUFACTURERED BY MBCI, 24 GAUGE, OR EQUAL. PROFILE: AS INDICATED ON DRAWINGS.

LOCATION: AS INDICATED ON DRAWINGS.

11. FINISH: AS INDICATED ON DRAWINGS.

FINISH: AS INDICATED ON DRAWINGS.

B. MBCI "PBR" PANEL, 24 GAUGE OR EQUAL.

8. UPLIFT RATING: AS NOTED ON STRUCTURAL DRAWINGS.

A. BATT INSULATION: FIT INSULATION SNUGLY BETWEEN FRAMING WITH A FRICTION FIT. LEAVE NO VOIDS. INSTALL THERMAL INSULATION

B. SILL-SEALER GASKETS: GLASS-FIBER-RESILIENT INSULATION, FABRICATED IN STRIP FORM, FOR USE AS A SILL SEALER; 1-INCH NOMINAL

THICKNESS, COMPRESSIBLE TO 1/32 INCH; SELECTED FROM MANUFACTURER'S STANDARD WIDTHS TO SUIT WIDTH OF SILL MEMBERS

2. MOCK UP (WHEN INDICATED ON DRAWINGS): REFER TO DRAWINGS FOR MOCK UP ELEVATION. MOCK UP SHALL REPRESENT COLOR

1. PROVIDE PANZER 20 HIGH IMPACT REINFORCING MESH (OR EQUAL) TO 6 FEET ABOVE FINISH FLOOR LINE OR AS OTHERWISE

A. COMPLY WITH EIFS MANUFACTURER'S WRITTEN INSTRUCTIONS FOR INSTALLATION OF EIFS AS APPLICABLE FOR EACH TYPE OF

B. BOARD INSULATION: EXPANDED POLYSTYRENE AS RECOMMENDED BY EIFS SYSTEM MANUFACTURER. THICKNESS AND SHAPES AS

C. EXPANSION JOINTS: INSTALL AT LOCATIONS INDICATED ON DRAWINGS OR WHERE REQUIRED BY EIFS MANUFACTURER. PROVIDE

E. REINFORCING MESH: COMPLETELY EMBED MESH IN WET BASE COAT, APPLYING ADDITIONAL BASE COAT MATERIAL AS NEEDED SO

D. BASE COAT: APPLY TO EXPOSED SURFACES OF INSULATION IN MINIMUM THICKNESS RECOMMENDED IN WRITING BY EIFS

F. FINISH COAT: APPLY OVER BASE COAT MAINTAINING A WET EDGE AT ALL TIMES FOR UNIFORM APPEARANCE IN THICKNESS

1. PRODUCT DATA: MANUFACTURER'S SPECIFICATIONS, DETAILS, INSTALLATION INSTRUCTIONS, AND PRODUCT DATA.

OF METAL ROOF PANEL ASSEMBLIES THAT FAIL IN MATERIALS OR WORKMANSHIP WITHIN SPECIFIED WARRANTY PERIOD.

b. DETERIORATION OF METALS, METAL FINISHES, AND OTHER MATERIALS BEYOND NORMAL WEATHERING.

1. FLUOROPOLYMER FINISH WARRANTY PERIOD: 20 YEARS FROM DATE OF SUBSTANTIAL COMPLETION.

MATERIAL: METALLIC-COATED STEEL SHEET, 24 GAUGE, a. EXTERIOR FINISH: FLUOROPOLYMER.

4. CLIPS: FLOATING TO ACCOMMODATE THERMAL MOVEMENT, a. MATERIAL: METALLIC-COATED-STEEL SHEET.

EXPANSION JOINTS WHERE INDICATED IN EIFS SUBSTRATE AND WHERE EIFS ADJOINS DISSIMILAR SUBSTRATE MATERIALS, OR WHERE

RECOMMENDED BY EIFS MANUFACTURER TO PROVIDE A UNIFORM FINISH AND TEXTURE MATCHING APPROVED SAMPLE AND FREE OF

2. MOCK UP (WHEN INDICATED ON DRAWINGS): REFER TO DRAWINGS FOR MOCK UP ELEVATION. MOCK UP SHALL REPRESENT COLOR

A. SPECIAL WARRANTY: MANUFACTURER'S STANDARD FORM IN WHICH MANUFACTURER AGREES TO REPAIR OR REPLACE COMPONENTS

B. SPECIAL WARRANTY ON PANEL FINISHES: MANUFACTURER'S STANDARD FORM IN WHICH MANUFACTURER AGREES TO REPAIR FINISH

OR REPLACE METAL ROOF PANELS THAT SHOW EVIDENCE OF DETERIORATION OF FACTORY-APPLIED FINISHES WITHIN SPECIFIED

A. STANDING-SEAM METAL ROOF PANELS: FACTORY-FORMED, DESIGNED TO BE FIELD ASSEMBLED BY LAPPING AND INTERCONNECTING

CONCEALED CLIPS IN SIDE LAPS. INCLUDE CLIPS, CLEATS, PRESSURE PLATES, AND ACCESSORIES REQUIRED FOR WEATHERTIGHT

1. STEEL PANEL SYSTEMS: COMPLY WITH ASTM E 1514. MBCI SUPERLOK CLASS I-90. BERRIDGE MANUFACTURING COMPANY.

RAISED SIDE EDGES OF ADJACENT PANELS WITH JOINT TYPE INDICATED AND MECHANICALLY ATTACHING PANELS TO SUPPORTS USING

D. FREEZER FOUNDATION INSULATION: PROVIDE DOW CHEMICAL COMPANY STYROFOAM BRAND FREEZERMATE EXTRUDED

G. PROVIDE MANUFACTURER RECOMMENDED TRIM, BATTENS, CORNER AND EDGE PROTECTION ON FRP PANELS.

CONCEALED SHIMS. SCRIBE AND CUT FINISH CARPENTRY ITEMS TO FIT ADJOINING WORK. PERFORM WORK IN ACCORDANCE WITH AWI

ATTACHING OTHER WORK. FORM TO SHAPES SHOWN AND CUT AS REQUIRED FOR TRUE LINE AND LEVEL OF ATTACHED WORK.

C. INSTALL PERMANENT GROUNDS OF DRESSED, PRESERVATIVE TREATED, KEY-BEVELED LUMBER NOT LESS THAN 1-1/2 INCHES WIDE

A. PROVIDE MATERIALS THAT COMPLY WITH REQUIREMENTS OF THE AWI QUALITY STANDARD FOR CUSTOM GRADE FOR EACH TYPE OF

AND OF THICKNESS REQUIRED TO BRING FACE OF GROUND TO EXACT THICKNESS OF FINISH MATERIAL. REMOVE TEMPORARY

THAT WILL NOT FULLY PENETRATE MEMBERS WHERE OPPOSITE SIDE WILL BE EXPOSED TO VIEW OR WILL RECEIVE FINISH MATERIALS.

2. "PUBLISHED REQUIREMENTS OF METAL FRAMING ANCHOR MANUFACTURER.

OTHERWISE INDICATED. BUILD INTO MASONRY DURING INSTALLATION MASONRY WORK.

3.2 WOOD GROUNDS, NAILERS, BLOCKING AND SLEEPERS

4. "TABLE 2304.9.1 - FASTENING SCHEDULE IN THE ICC'S INTERNATIONAL BUILDING CODE.

SPECIFICATIONS FOR WOOD CONSTRUCTION".

COORDINATE LOCATIONS WITH OTHER WORK INVOLVED.

SECTION 06400 - FINISH CARPENTRY

b. PATTERN AND COLOR: AS INDICATED ON DRAWINGS.

a. COLOR AND PATTERN: AS INDICATED ON DRAWINGS.

a. COLOR AND PATTERN: AS INDICATED ON DRAWINGS.

C. REFINISH CUT SURFACES OR REPAIR DAMAGED FINISH AT CUTS.

MATCH FINAL FINISH WHERE TRANSPARENT FINISH IS REQUIRED.

APPROPRIATE TO TYPE OF SUBSTRATE PROVIDED.

USED IN MILLWORK CONSTRUCTION INCLUDING TOE-KICKS AND SCRIBES.

SECTION 07210 - BUILDING INSULATION

B. RESEARCH/EVALUTATION REPORTS FOR FOAM-PLASTIC INSULATION.

TYPE IV, ASTM C578. MINIMUM COMPRESSIVE STRENGTH 25 PSI.

A. PROVIDE COMPLETE SUBMITTAL INCLUDING THE FOLLOWING:

AND TEXTURE RANGE FOR APPROVAL BY ARCHITECT.

A. <u>OUTSULATION MD SYSTEM</u> AS MANUFACTURED BY DRYVIT SYSTEM, INC.

MANUFACTURER, BUT NOT LESS THAN 1/16 INCH DRY COAT THICKNESS.

REINFORCING MESH AND PATTERN ARE NOT VISIBLE.

COLD JOINTS, SHADOW LINES AND TEXTURE VARIATIONS.

A. PROVIDE COMPLETE SUBMITTAL INCLUDING THE FOLLOWING:

AND PANEL PROFILE FOR APPROVAL BY ARCHITECT.

1. FAILURES INCLUDE, BUT ARE NOT LIMITED TO, THE FOLLOWING:

B. SHEATHING: 5/8 INCH DENSGLASS GOLD AS MANUFACTURED BY GEORGIA PACIFIC.

AT EXTERIOR WALLS WHERE INDICATED.

B. SILL GASKET: AMOCO SILL SEALER BY TENNECO BUILDING PRODUCTS (800) 241-4402.

GROUNDS WHEN NO LONGER REQUIRED.

2. FIBER REINFORCED PLASTIC PANELS:

a. MANUFACTURER: KEMLITE.

4. SHEATHING: 1/2" FIRE RETARDANT PLYWOOD AT VERTICAL ORIENTED PANELS

3.1 INSTALLATION

A. INSTALL PER MANUFACTURER'S WRITTEN INSTRUCTIONS.

SECTION 07540 - THERMOPLASTIC SINGLE-PLY MEMBRANE ROOFING (TPO)

A. STANDARD ROOFING MANUFACTURER'S WARRANTY: SUBMIT A WRITTEN WARRANTY, WITHOUT MONETARY LIMITATION, SIGNED BY THE ROOFING SYSTEM MANUFACTURER AGREEING TO PROMPTLY REPAIR LEAKS IN THE ROOF MEMBRANE AND BASE FLASHINGS RESULTING FROM DEFECTS IN MATERIALS OR WORKMANSHIP FOR A WARRANTY PERIOD OF 10 YEARS.

B. PROJECT WARRANTY: SUBMIT ROOFING INSTALLER'S WARRANTY. WITHOUT MONETARY LIMITATION, SIGNED BY THE ROOFING SYSTEM INSTALLER, COVERING THE WORK OF THIS SECTION, INCLUDING MEMBRANE ROOFING, BASE FLASHING, ROOFING INSULATION, AND FASTENERS FOR A WARRANTY PERIOD OF 2 YEARS.

2.1 SINGLE PLY ROOFING SYSTEM

A. PROVIDE SHEET MEMBRANE, BASE FLASHINGS AND COMPONENT MATERIALS THAT MEET WIND STANDARDS TO ASSURE ADEQUATE UPLIFT DESIGN FOR THE AREA AND CONDITIONS PRESENT.

B. THERMOPLASTIC POLYOLEFIN (TPO) BASED REINFORCED SHEET: 1. REINFORCEMENT: POLYESTER.

2. THICKNESS: 45 MILS MINIMUM POLYMER THICKNESS 3. EXPOSED MEMBRANE COLOR: WHITE.

4. FIELD MEMBRANE ATTACHMENT: MECHANICALLY FASTENED. FULLY-ADHERED AT VERTICAL SURFACES. FLASHING MEMBRANE: SHEET FLASHING SHALL BE FIBERGLASS REINFORCED AND OF SAME MATERIAL, TYPE, THICKNESS AND COLOR AS TPO FIELD

6. INSULATION: REF ROOF PLAN SHEET FOR INSULATION R-VALUE REQUIREMENTS.

COVER BOARD: a. DENS-DECK 1/4 INCH THICK OVER POLYISOCYAN URATE. STAGGER JOINTS BETWEEN POLYISOCYANURATE AND DENS-DECK. b. DENS-DECK 1/2 INCH THICK AT VERTICAL ROOF SURFACES (PARAPET WALLS).

c. DENS-DECK 1/2 INCH THICK OVER METAL DECK WHERE NO POLYISOCYANURATE IS USED. 8. INCLUDE A SACRIFICIAL LAYER OF TPO SHEET MEMBRANE UNDER ROOFTOP UNITS.

9. PROVIDE SERVICE PADS AS INDICATED ON THE DRAWINGS AND AS RECOMMENDED AND FURNISHED BY THE MANUFACTURER. 10. PROVIDE ALL NECESSARY ACCESSORIES AS RECOMMENDED BY THE MEMBRANE MANUFACTURER.

11. SOLAR REFLECTANCE INDEX (SRI) EQUAL TO OR GREATER THAN 78. C. MANUFACTURERS:

1. CARLISLE SURE-WELDSW. 2. GAF EVERGUARD TPO TSR-45.

3. JOHNS MANVILLE - JM TPO-45 MIL

A. ROOFING CONTRACTOR SHALL VERIFY CORRECT INSTALLATION OF INSULATION AND MINIMUM SLOPE REQUIREMENTS (1/4 INCH PER FOOT) FOR PROPER DRAINAGE.

3.2 INSTALLATION

A. ROOFING CONTRACTOR SHALL BE AUTHORIZED BY THE SPECIFIED ROOF MEMBRANE MANUFACTURER PRIOR TO BIDDING. B. INSTALLATION OF INSULATION AND ROOFING SHALL BE ACCOMPLISHED IN SUCH A WAY THAT EACH AREA WILL BE COMPLETE AT THE END OF EACH DAY OF WORK. C. APPLY TPO ROOFING AND FLASHING SYSTEM IN ACCORDANCE WITH MANUFACTURER'S WRITTEN INSTRUCTIONS, AND THE CONTRACT

D. APPROVED MEMBRANE AND INSULATION BOARD SHALL BE FULLY ATTACHED TO THE DECK

SECTION 07620 - SHEET METAL FLASHING AND TRIM

2.1 MATERIALS

A. PROVIDE GALVANIZED SHEET METAL NECESSARY TO COMPLETE THE FOLLOWING WORK: 1. FLASHING AND COUNTER FLASHING, 24 GAUGE, OR AS OTHERWISE INDICATED ON DRAWINGS.

2. CAP FLASHING, 24 GAUGE. 3. GUTTERING, 20 GAUGE, AND DOWNSPOUTS, 24 GAUGE. UNPAINTED UNLESS NOTED OTHERWISE

A. COMPLY WITH THE LATEST EDITION OF SHEET METAL AND AIR CONDITIONING CONTRACTORS' NATIONAL ASSOCIATION (SMACNA) ARCHITECTURAL SHEET METAL MANUAL AND SELECTED ROOFING MANUFACTURER'S REQUIREMENT.

SECTION 07720 - ROOF CURBS

2.1 MANUFACTURERS

A. ROOF PRODUCTS, INC B. APPROVED EQUALS:

AES INDUSTRIES, INC.

2.2 MATERIALS A. 14 INCH RPC-3 PREFAB INSULATED CURB.

3.1 INSTALLATION

A. INSTALL PER MANUFACTURER'S WRITTEN INSTRUCTIONS.

SECTION 07722 - ROOF HATCHES

A. ROOF HATCH. TYPE L-20 STEEL COVER FRAME ROOF SCUTTLE FROM STAIR ACCESS, 30 INCHES WIDE BY 96 INCHES LONG, AS MANUFACTURED BY THE BILCO COMPANY. PROVIDE 16 INCH HIGH CURB. B. ACCESSORIES: INTEGRATED SAFETY RAILING, BIL-GUARD, AS MANUFACTURED BY THE BILCO COMPANY.

SECTION 07920 - JOINT SEALANTS

2.1 MATERIALS

A. MOISTURE BARRIER: 6-MIL POLYETHYLENE SHEET MEMBRANE. PROVIDE MOISTURE BARRIER WITH 73% MINIMUM RECYCLE CONTENT, UNLESS OTHERWISE NOTED.

B. FLEXIBLE BASE FLASHING: 20-MIL SHEET VINYL WATER BARRIER. C. FLASHING ADHESIVE: STIFF FIBERED MASTIC COMPATIBLE WITH FLEXIBLE MEMBRANE FLASHING.

D. JOINT BACKING: PROVIDE CLOSED CELL COMPRESSIBLE, NON-STAINING, NON-ROTTING JOINT BACKING PER SEALANT MANUFACTURER'S RECOMMENDATION.

E. CLOSED CELL EXPANDED RUBBER: MM SYSTEMS ELASTOPRENE CLOSED CELL EXPANDED RUBBER FOR USE AT WIDE GAPS WHERE INDICATED ON DRAWINGS. F. MANUFACTURERS: 1. FLEXIBLE FLASHING: B.F. GOODRICH OR APPROVED EQUAL.

3. SEALANTS FOR EXTERIOR AND INTERIOR EXPANSION AND CONTROL JOINTS: SONNEBORN NP-2 OR APPROVED EQUAL. 4. OTHER INTERIOR JOINT SEALANTS: DAP OR APPROVED EQUAL.

3.1 INSTALLATION

A. PROVIDE SEALANT FOR ALL EXTERIOR AND INTERIOR EXPANSION AND CONTROL JOINTS, WINDOW, CURTAINWALL, AND STOREFRONT SYSTEMS, AND MASONRY AND PRECAST CONSTRUCTION. B. PROVIDE SEALANT ALONG PERIMETER OF ALL DOOR FRAMES, WINDOWS AND STOREFRONT.

C. PROVIDE CONTINUOUS MANUFACTURER RECOMMENDED EPOXY ANCHORING FOR APPLICATION OF CLOSED CELL EXPANDED RUBBER

SECTION 08110 - STEEL DOORS AND FRAMES

1.1 SUBMITTALS A. PROVIDE COMPLETE SUBMITTAL INCLUDING THE FOLLOWING:

1. MANUFACTURER'S DOOR AND FRAME PRODUCT DATA. 2. INDICATE LOCATION, SIZE, AND HAND OF EACH DOOR.

2. FLASHING ADHESIVE: PHILIP CAREY DUK-BAK #107.

3. ELEVATION OF EACH TYPE OF DOOR AND FRAME. 4. INDICATE DIMENSIONS AND LOCATIONS OF MORTISES AND HOLES FOR HARDWARE.

2.1 MATERIALS

1. 1-3/4 INCH THICK 18 GAUGE FLUSH COLD-ROLLED SHEET, FLUSH STEEL PANELS, FACTORY PRIMED FOR FIELD PAINTING. 2. EXTERIOR DOORS GALVANIZED.

B. FRAMES: 1. FABRICATE FRAMES WITH MITERED OR COPED CORNERS, CONTINUOUSLY WELDED, 2 INCH THICK 16 GAUGE COLD-ROLLED STEEL

2. GALVANIZED FRAMES IN PRECAST CONCRETE PANELS SHALL HAVE MASTIC INTERNAL COATING.

3. PROVIDE TWIST-IN OR WELDED METAL STUD TYPE FRAME ANCHORS. PROVIDE THROUGH BOLT ANCHORS AT FRAMES IN PRECAST 4. SHIP FRAMES TO BE LOCATED IN PRECAST WALLS TO PRECAST PANEL SUPPLIER PRIOR TO CASTING OF PANELS.

2.2 FABRICATION

A. EXPOSED FASTENERS: UNLESS OTHERWISE INDICATED, PROVIDE COUNTERSUNK FLAT OR OVAL HEADS FOR EXPOSED SCREWS AND B. HARDWARE PREPARATION: PREPARE DOORS AND FRAMES TO RECEIVE MORTISED AND CONCEALED HARDWARE ACCORDING TO DOOR

HARDWARE SCHEDULE AND TEMPLATES PROVIDED BY HARDWARE SUPPLIER. COMPLY WITH APPLICABLE REQUIREMENTS OF SDI 107 AND ANSI A115 SERIES SPECIFICATIONS FOR DOOR AND FRAME PREPARATION FOR HARDWARE C. REINFORCE DOORS AND FRAMES TO RECEIVE SURFACE-APPLIED HARDWARE INCLUDING CLOSERS AND EXIT HARDWARE. DRILLING

). LOCATE HARDWARE AS INDICATED OR. IF NOT INDICATED. ACCORDING TO THE DOOR AND HARDWARE INSTITUTE'S (DHI) "RECOMMENDED LOCATIONS FOR ARCHITECTURAL HARDWARE FOR STANDARD STEEL DOORS AND FRAMES" AND ADA REQUIREMENTS. E. FRAMES TO BE FACE WELDED. 3.1 INSTALLATION

A. PRIME COAT TOUCHUP: IMMEDIATELY AFTER ERECTION, SAND SMOOTH ANY RUSTED OR DAMAGED AREAS OF PRIME COAT AND APPLY

SECTION 08411 - ALUMINUM STOREFRONTS

TOUCHUP OF COMPATIBLE AIR-DRYING PRIMER ON BOTH FRAMES AND DOORS.

AND TAPPING FOR SURFACE-APPLIED HARDWARE MAY BE DONE AT PROJECT SITE.

1.1 SUBMITTALS

A. PRODUCT DATA: FOR EACH PRODUCT SPECIFIED. INCLUDE DETAILS OF CONSTRUCTION RELATIVE TO MATERIALS, DIMENSIONS OF INDIVIDUAL COMPONENTS, PROFILES, AND FINISHES. B. SHOP DRAWINGS: SHOW DETAILS OF FABRICATION AND INSTALLATION, INCLUDING PLANS, ELEVATIONS, SECTIONS, DETAILS OF COMPONENTS, PROVISIONS FOR EXPANSION AND CONTRACTION, AND ATTACHMENTS TO OTHER WORK.

2.1 MANUFACTURERS

A. KAWNEER; EFCO; VISTAWALL ARCHITECTURAL PRODUCTS; PPG ARCHITECTURAL METALS; TUBELITE; OLDCASTLE OR APPROVED EQUAL

PRODUCT SYSTEM (STANDARD): KAWNEER TRIFAB 451 OR OLDCASTLE SERIES 3000 MULTIPLANE.

2. PRODUCT SYSTEM (AREAS INDICATED AS HURRICANE OR IMPACT RESISTANT: KAWNEER IR 501 OR OLDCASTLE FG-5100 STORMMAX 3. DOOR: KAWNEER 350 STANDARD - PROVIDE AS REQUIRED TO ACCOMMODATE 1" INSULATED GLAZING. B. THE DRAWINGS INDICATE SIZE, PROFILES, AND DIMENSIONAL REQUIREMENTS OF THE ALUMINUM STOREFRONT WINDOW SYSTEM AND ARE BASED ON THE SPECIFIC TYPE AND MODEL INDICATED. ALUMINUM STOREFRONT WINDOW SYSTEMS HAVING EQUAL CHARACTERISTICS BY OTHER MANUFACTURERS MAY BE CONSIDERED PROVIDED THAT DEVIATIONS IN DIMENSIONS AND PROFILES ARE MINOR AND DO NOT CHANGE THE DESIGN CONCEPT OR INTENDED PERFORMANCE AS JUDGED BY THE ARCHITECT. THE BURDEN OF PROOF OF EQUALITY IS ON THE PROPOSER.

C. DESIGN ALUMINUM STOREFRONT WINDOW SYSTEM TO WITHSTAND DESIGN WIND LOADS AS INDICATED ON STRUCTURAL DRAWINGS.

2.2 ACCESSORIES A. BRACKETS AND REINFORCEMENTS: PROVIDE MANUFACTURER'S STANDARD BRACKETS AND REINFORCEMENTS THAT ARE COMPATIBLE WITH ADJACENT MATERIALS. PROVIDE NON-STAINING, NONFERROUS SHIMS FOR ALIGNING SYSTEM COMPONENTS. B. FASTENERS AND ACCESSORIES: MANUFACTURER'S STANDARD CORROSION-RESISTANT, NON-STAINING, NONBLEEDING FASTENERS

AND ACCESSORIES COMPATIBLE WITH ADJACENT MATERIALS. C. CONCEALED FLASHING: MANUFACTURER'S STANDARD CORROSION-RESISTANT, NON-STAINING, NONBLEEDING FLASHING, COMPATIBLE WITH ADJACENT MATERIALS. AND OF TYPE RECOMMENDED BY MANUFACTURER. PROVIDE RECEIVER SILLS AS RECOMMENDED BY

MANUFACTURER. D. HARDWARE: PER MANUFACTURER'S STANDARD AS FOLLOWS:

1. PULL BAR: SINGLE ACTING ARCHITECTS CLASSIC HARDWARE "CO-9 PULL BAR. 2. EXIT DEVICE: KAWNEER 1686 CONCEALED ROD DEVICE.

3. DOOR CLOSURES: KAWNEER LCN 4040 SUPER SMOOTHEE SURFACE MOUNTED OVERHEAD ADJUSTABLE CLOSER. 4. PIVOTS/BUTTS: STANDARD KAWNEER COMMERCIAL BUTT HINGES (4 EACH LEAF). 5. THRESHOLD AS COMPATIBLE WITH EXIT DEVICE

RS, INC., 877.663.4277. COLOR: TO MATCH STOREFRONT

6. WEATHERSTRIPPING: MANUFACTURER'S STANDARD E. ALUMINUM ACM INFILL PANELS, PER MANUFACTURER'S STANDARD, AS FOLLOWS: 1. ALUMINUM INFILL PANEL: 6MM THICK ACM PANEL WITH 0.32 INCH ALUMINUM FACE. OMEGA-LITE 20 AS MANUFACTURED BY LAM I NATO

MANUFACTURED BY LAMINATORS, INC., 877.663.4277. COLOR: TO MATCH STOREFRONT.

2.3 FABRICATION A. FABRICATE COMPONENTS THAT, WHEN ASSEMBLED, WILL HAVE ACCURATELY FITTED JOINTS WITH ENDS COPED OR MITERED TO PRODUCE HAIRLINE JOINTS FREE OF BURRS AND DISTORTION.

2. ALUMINUM FACED PLYWOOD INFILL PANEL: 1/4 INCH THICK PLYWOOD WITH 0.032 INCH ALUMINUM FACE. OMEGA-PLY AS

C. PREPARE COMPONENTS TO RECEIVE CONCEALED FASTENERS AND ANCHOR AND CONNECTION DEVICES. D. FABRICATE COMPONENTS TO DRAIN WATER PASSING JOINTS AND CONDENSATION AND MOISTURE OCCURRING OR MIGRATING WITHIN

B. FORMING: FORM SHAPES WITH SHARP PROFILES, STRAIGHT AND FREE OF DEFECTS OR DEFORMATIONS, BEFORE FINISHING.

E. WELDING: WELD COMPONENTS TO COMPLY WITH AWS STANDARDS. WELD BEFORE FINISHING COMPONENTS TO GREATEST EXTENT POSSIBLE. WELD IN CONCEALED LOCATIONS TO GREATEST EXTENT POSSIBLE TO MINIMIZE DISTORTION OR DISCOLORATION OF FINISH. REMOVE WELD SPATTER AND WELDING OXIDES FROM EXPOSED SURFACES BY DESCALING OR GRINDING. F. GLAZING CHANNELS: PROVIDE MINIMUM CLEARANCES FOR THICKNESS AND TYPE OF GLASS INDICATED ACCORDING TO FGMA'S

G. METAL PROTECTION: WHERE ALUMINUM WILL CONTACT DISSIMILAR METALS, PROTECT AGAINST GALVANIC ACTION BY PAINTING CONTACT SURFACES WITH PRIMER OR BY APPLYING SEALANT OR TAPE RECOMMENDED BY MANUFACTURER FOR THIS PURPOSE. WHERE ALUMINUM WILL CONTACT CONCRETE OR MASONRY, PROTECT AGAINST CORROSION BY PAINTING CONTACT SURFACES WITH

BITUMINOUS PAINT. H. FABRICATE FRAMING IN PROFILES INDICATED. FACTORY-ASSEMBLE COMPONENTS TO GREATEST EXTENT POSSIBLE. DISASSEMBLE COMPONENTS ONLY AS NECESSARY FOR SHIPMENT AND INSTALLATION.

2.4 ALUMINUM FINISHES

WEATHERTIGHT CONSTRUCTION

A. CLASS II, ETCHED, MEDIUM MATTE, CLEAR ANODIC FINISH.

3.1 INSTALLATION

"GLAZING MANUAL."

A. FIELD MEASUREMENTS: VERIFY DIMENSIONS BY FIELD MEASUREMENTS BEFORE FABRICATION AND INDICATE MEASUREMENTS ON

B. FIT FRAME JOINTS TO PRODUCE HAIRLINE JOINTS FREE OF BURRS AND DISTORTION. RIGIDLY SECURE NON-MOVEMENT JOINTS. SEAL JOINTS WATERTIGHT. C. METAL PROTECTION: WHERE ALUMINUM WILL CONTACT DISSIMILAR METALS, PROTECT AGAINST GALVANIC ACTION BY PAINTING

WHERE ALUMINUM WILL CONTACT CONCRETE OR MASONRY, PROTECT AGAINST CORROSION BY PAINTING CONTACT SURFACES WITH BITUMINOUS PAINT. D. INSTALL COMPONENTS TO DRAIN WATER PASSING JOINTS AND CONDENSATION AND MOISTURE OCCURRING OR MIGRATING WITHIN THE SYSTEM TO THE EXTERIOR.A. SET CONTINUOUS SILL MEMBERS AND FLASHING IN A FULL SEALANT BED TO PROVIDE

CONTACT SURFACES WITH PRIMER OR BY APPLYING SEALANT OR TAPE RECOMMENDED BY MANUFACTURER FOR THIS PURPOSE.

B. INSTALL GLAZING TO COMPLY WITH STOREFRONT MANUFACTURER'S INSTRUCTIONS, AND AS INDICATED C. INSTALL PERIMETER SEALANT TO COMPLY WITH STOREFRONT MANUFACTURER'S INSTRUCTIONS, AND AS INDICATED.

A. PRODUCT DATA: MANUFACTURER'S SPECIFICATIONS, DETAILS, INSTALLATION INSTRUCTIONS, AND PRODUCT DATA.

SECTION 09220 - PORTLAND CEMENT PLASTER

2.1 METAL LATH

B. MOCK UP (WHEN INDICATED ON DRAWINGS): REFER TO DRAWINGS FOR MOCK UP ELEVATION. MOCK UP SHALL REPRESENT COLOR AND TEXTURE RANGE FOR APPROVAL BY ARCHITECT.

A. EXPANDED-METAL LATH: ASTM C 847 WITH ASTM A 653/A 653M, G60 (Z180), HOT-DIP GALVANIZED ZINC COATING; DIAMOND MESH LATH

SELF-FURRING; 2.5 LB WEIGHT /SQ. YD. FOR VERTICAL APPLICATIONS. B. WEATHER-RESISTANT BARRIER: 2 LAYERS OF DUPONT; TYVEK STUCCOWRAP; INSTALL PER MANUFACTURER' WRITTEN INSTRUCTIONS.

2.2 ACCESSORIES A. FOUNDATION WEEP SCREED: FABRICATED FROM HOT-DIP GALVANIZED STEEL SHEET, ASTM A 653/A 653M, G60 (Z180) ZINC COATING.

B. EXTERNAL-CORNER REINFORCEMENT: FABRICATED FROM METAL LATH WITH ASTM A 653/A 653M, G60 (Z180), HOT-DIP GALVANIZED C. CORNERBEADS: FABRICATED FROM ZINC, SMALL-NOSE STYLE; USE UNLESS OTHERWISE INDICATED.

D. CASING BEADS: FABRICATED FROM ZINC; SQUARE-EDGED STYLE; WITH EXPANDED FLANGES. E. CONTROL AND EXPANSION JOINTS: FABRICATED FROM ZINC: FOLDED PAIR OF UNPERFORATED SCREEDS IN M-SHAPED

CONFIGURATION; WITH PERFORATED FLANGES AND REMOVABLE PROTECTIVE TAPE ON PLASTER FACE OF CONTROL JOINT. 2.3 MISCELLANEOUS MATERIALS

A. WATER FOR MIXING: POTABLE AND FREE OF SUBSTANCES CAPABLE OF AFFECTING PLASTER SET OR OF DAMAGING PLASTER, LATH, OR ACCESSORIES. B. FIBER FOR BASE COAT: ALKALINE-RESISTANT GLASS OR POLYPROPYLENE FIBERS, 1/2 INCH (13 MM) LONG, FREE OF CONTAMINANTS,

MANUFACTURED FOR USE IN PORTLAND CEMENT PLASTER. C. BONDING COMPOUND: ASTM C 932. D. STEEL DRILL SCREWS: FOR METAL-TO-METAL FASTENING, ASTM C 1002 OR ASTM C 954, AS REQUIRED BY THICKNESS OF METAL BEING

FASTENED; WITH PAN HEAD THAT IS SUITABLE FOR APPLICATION; IN LENGTHS REQUIRED TO ACHIEVE PENETRATION THROUGH JOINED MATERIALS OF NOT FEWER THAN THREE EXPOSED THREADS.

E. FASTENERS FOR ATTACHING METAL LATH TO SUBSTRATES: COMPLYING WITH ASTM C 1063.

2.4 PLASTER MATERIALS A. PORTLAND CEMENT: ASTM C 150, TYPE I.

B. LIME: ASTM C 206, TYPE S. C. SAND AGGREGATE: ASTM C 897.

D. PERLITE AGGREGATE: ASTM C 35. E. READY-MIXED FINISH-COAT PLASTER: MILL-MIXED PORTLAND CEMENT, AGGREGATES, COLORING AGENTS, AND PROPRIETARY

INGREDIENTS.

1. PROVIDE ONE OF THE FOLLOWING PRODUCTS OR EQUAL: a. CALIFORNIA STUCCO PRODUCTS CORP.; CONVENTIONAL PORTLAND CEMENT STUCCO.

b. CHEMREX; THORO STUCCO. c. UNITED STATES GYPSUM CO.; ORIENTAL EXTERIOR FINISH STUCCO.

2. FINISH: MATCH STO MEDIUM SAND FINISH. 2. COLOR: AS INDICATED ON DRAWINGS. 3.

2.5 PLASTER MIXES

A. PORTLAND CEMENT BASE-COAT MIXES:

 OVER METAL LATH: SCRATCH AND BROWN COATS FOR THREE-COAT PLASTERWORK AS FOLLOWS: B. SCRATCH COAT: FOR CEMENTITIOUS MATERIAL, MIX 1 PART PORTLAND CEMENT AND 0 TO 3/4 PARTS LIME. USE 2-1/2 TO 4 PARTS

AGGREGATE PER PART OF CEMENTITIOUS MATERIAL (SUM OF SEPARATE VOLUMES OF EACH COMPONENT MATERIAL). C. BROWN COAT: FOR CEMENTITIOUS MATERIAL, MIX 1 PART PORTLAND CEMENT AND 0 TO 3/4 PARTS LIME. USE 3 TO 5 PARTS AGGREGATE PER PART OF CEMENTITIOUS MATERIAL (SUM OF SEPARATE VOLUMES OF EACH COMPONENT MATERIAL). D. PORTLAND CEMENT JOB-MIXED FINISH-COAT MIXES: FOR CEMENTITIOUS MATERIALS, MIX 1 PART PORTLAND CEMENT AND 3/4 TO 1-1/2

COMPONENT MATERIAL).

3.1 PREPARATION A. PREPARE SOLID-PLASTER BASES THAT ARE SMOOTH OR THAT DO NOT HAVE THE SUCTION CAPABILITY REQUIRED TO BOND WITH PLASTER ACCORDING TO ASTM C 926.

PARTS LIME. USE 1-1/2 TO 3 PARTS AGGREGATE PER PART OF CEMENTITIOUS MATERIAL (SUM OF SEPARATE VOLUMES OF EACH

3.2 INSTALLING NONSTRUCTURAL STEEL FRAMING, GENERAL A. GENERAL: COMPLY WITH REQUIREMENTS IN ASTM C 1063 FOR APPLICATIONS INDICATED.

1. COMPLY WITH ASTM C 754 FOR INSTALLATION OF ITEMS NOT ADDRESSED IN ASTM C 1063. B. INSTALL SUPPLEMENTARY FRAMING, BLOCKING, AND BRACING AT TERMINATIONS IN PLASTER ASSEMBLIES TO SUPPORT FIXTURES,

EQUIPMENT SERVICES, HEAVY TRIM, OR SIMILAR CONSTRUCTION. C. ISOLATE STEEL FRAMING FROM BUILDING STRUCTURE TO PREVENT TRANSFER OF LOADING IMPOSED BY STRUCTURAL MOVEMENT. D. DO NOT BRIDGE BUILDING CONTROL AND EXPANSION JOINTS WITH STEEL FRAMING OR FURRING MEMBERS. FRAME BOTH SIDES OF JOINTS INDEPENDENTLY.

3.3 INSTALLING METAL LATH

A. EXPANDED-METAL LATH: INSTALL ACCORDING TO ASTM C 1063. A.

3.4 INSTALLING ACCESSORIES A. REINFORCEMENT FOR EXTERNAL CORNERS:

1. INSTALL LATH-TYPE EXTERNAL-CORNER REINFORCEMENT AT EXTERIOR LOCATIONS. B. CONTROL JOINTS: COORDINATE INSTALLATION OF CONTROL JOINTS WITH REQUIREMENTS BELOW AND AS INDICATED ON DRAWINGS. 1. AS REQUIRED TO DELINEATE PLASTERWORK INTO AREAS (PANELS) OF THE FOLLOWING MAXIMUM SIZES: C. VERTICAL SURFACES: 144 SQ. FT. (13.4 SQ. M).

1. AT DISTANCES BETWEEN CONTROL JOINTS OF NOT GREATER THAN 18 FEET (5.5 M) O.C.

2. AS REQUIRED TO DELINEATE PLASTERWORK INTO AREAS (PANELS) WITH LENGTH-TO-WIDTH RATIOS OF NOT GREATER THAN 2-1/2:1. 3. WHERE PLASTERWORK AREAS CHANGE DIMENSIONS, TO DELINEATE RECTANGULAR-SHAPED AREAS (PANELS) AND TO RELIEVE THE STRESS THAT OCCURS AT THE CORNER FORMED BY THE DIMENSION CHANGE.

SECTION 09310 - CERAMIC TILE

1.1 SUBMITTALS

A. SAMPLES: SIX WEEKS PRIOR TO INSTALLATION, PROVIDE A SAMPLE FOR EACH SPECIFIED TILE AND A 12 INCH x 12 INCH MOCK-UP OF CERAMIC TILE WITH SPECIFIED GROUT.

+engineering 2809 Ajax Avenue Suite 100 Rogers Arkansas 72758 Phone: 479.636.3545

Fax: 479.636.1209 Scott Joseph Broadben Florida License No. AR 9789 Architect Business Lic No. AA26000940

CHECKED BY:

DOCUMENT DATE: 11.06.2023

ISSUE BLOCK

SIGNATURE SHALL BE CONSIDERE NOT FOR CONSTRUCTION CONST. SPECS.

DOCUMENTS WITHOUT AN ARCHITECT

CS1.

SHEET:

2. PROVIDE ABRASIVE TILE WHERE INDICATED ON DRAWINGS. B. TRIM UNITS: PROVIDE TILE TRIM UNITS TO MATCH CHARACTERISTICS OF ADJOINING FLAT TILE.

c. SETTING MATERIALS:

1. LATEX-PORTLAND CEMENT MORTAR: ANSI A118.41.

D. PANTHEON COMPLETE INSTALLATION SYSTEM: INCLUDES PREMIUM MORTAR, EPOXY GROUT, SPACERS, TROWELS, POST-INSTALLATION CLEANER, AND 15 YEAR BOND AND STRUCTURAL TILE WARRANTY. ULTRAFLEX LFT - PREMIUM FORMAT TILE MORTAR WITH POLYMER -GREY; KERAPOXY - PREMIUM EPOXY GROUT; 1/16" HARD SPACERS; 1/2" X 1/2" X 1/2" STAINLESS STEEL SQUARE NOTCH ERGO HANDLE TROWEL; DETERDEK-POST INSTALLATION INITIAL CLEANER.

1. MANUFACTURERS AND COLORS: AS INDICATED ON DRAWINGS.

E. TROWELABLE UNDERLAYMENTS AND PATCHING COMPOUNDS: LATEX-MODIFIED, PORTLAND-CEMENT-BASED FORMULATION PROVIDED OR APPROVED BY MANUFACTURER OF TILE-SETTING MATERIALS FOR INSTALLATIONS INDICATED.

JOINT SUBSTRATES INDICATED O; FORMULATED WITH FUNGICIDE,INTENDED FOR IN-SERVICE EXPOSURES OF HIGH HUMIDITY AND EXTREME

F. CEMENTITIOUS BACKER BOARD: AS SPECIFIED IN GYPSUM BOARD ASSEMBLIES. G. ELASTOMERIC SEALANTS: ELASTOMERIC SEALANTS OF BASE POLYMER AND CHARACTERISTICS INDICATED THAT COMPLY WITH

APPLICABLE REQUIREMENTS IN DIVISION 7, SECTION "JOINT SEALANTS." ONE-PART MILDEW-RESISTANT SILICONE: ASTM C 920; TYPE S; GRADE NS; CLASS 25; USES NT, G, A, AND AS APPLICABLE TO NONPOROUS

3.1 INSTALLATION

TEMPERATURES.

A. COMPLY WITH PARTS OF ANSI A108 SERIES OF TILE INSTALLATION STANDARDS IN "SPECIFICATIONS FOR INSTALLATION OF CERAMIC TILE" THAT APPLY TO TYPES OF SETTING AND GROUTING MATERIALS AND TO METHODS INDICATED IN CERAMIC TILE INSTALLATION SCHEDULES. COMPLY WITH TCA'S "HANDBOOK FOR CERAMIC TILE INSTALLATION" INSTALLATION METHODS. CERAMIC TILE FLOOR INSTALLATION METHOD: TCA F113 (THIN-SET MORTAR BONDED TO CONCRETE SUBFLOOR).

C. EXTEND TILE WORK INTO RECESSES AND BEHIND EQUIPMENT AND FIXTURES TO FORM A COMPLETE COVERING WITHOUT INTERRUPTIONS, UNLESS OTHERWISE INDICATED. TERMINATE WORK NEATLY AT OBSTRUCTIONS, EDGES, AND CORNERS WITHOUT DISRUPTING PATTERN OR JOINT ALIGNMENTS.

 $_{ extsf{D}}$. JOINTING PATTERN: LAY TILE IN GRID PATTERN, UNLESS OTHERWISE INDICATED. ALIGN JOINTS WHEN ADJOINING TILES ON WALLS AND \prime TRIM ARE THE SAME SIZE. LAY OUT TILE WORK AND CENTER TILE FIELDS IN BOTH DIRECTIONS ON EACH WALL AREA. ADJUST TO MINIMIZE TILE CUTTING. PROVIDE UNIFORM JOINT WIDTHS, UNLESS OTHERWISE INDICATED.

SECTION 09511 - ACOUSTICAL PANEL CEILINGS

2.1 ACOUSTICAL PANELS

A. WET AREAS: 1. ARMSTRONG "CLEAN ROOM VL," SQUARE EDGE. SIZE AS INDICATED ON DRAWINGS. COLOR: WHITE, OR EQUAL

2. NATIONAL "GOLD BOND," BRAND GRIDSTONE GYPSUM CEILING PANEL. SIZE AS INDICATED ON DRAWINGS. COLOR: WHITE, OR EQUAL B. NON-WET AREAS: ARMSTRONG "DUNE," SQUARE EDGE. SIZE AS INDICATED ON DRAWINGS. COLOR: WHITE

2.2 METAL SUSPENSION SYSTEMS

A. ARMSTRONG PRELUDE PLUS XL 15/16 INCH EXPOSED TEE SYSTEM.

B. MATERIALS: PROVIDE COMPLETE SYSTEM, INCLUDING MANUFACTURER'S MOLDINGS, TRIM, AND ACCESSORIES.

1. GRID: INTERMEDIATE DUTY SYSTEM; STEEL EXPOSED TEE, NOMINAL 1 INCH WIDE; COMPLY WITH APPLICABLE ASTM C 635 2. ACCESSORIES: STABILIZER BARS, TRIM, MOLDINGS, CLIPS, AND SPLICES. 6 INCH EDGE MOLDINGS: METAL CHANNEL WITH EXPOSED

FLANGE TO MATCH GRID SYSTEM. 3. FINISHES: GALVANIZED STEEL WITH BAKED ENAMEL FINISH. COLOR/FINISH: AS INDICATED ON DRAWINGS.

2.3 SOUND ATTENUATION BOARD

A. SOUND ISOLATION COMPANY "SOUNDPROOF BARRIERS."

1. WEIGHT: 1 POUND PER SQUARE FOOT UNLESS OTHERWISE INDICATED.

2. TRANSMISSION LOSS FACTOR (SINGLE PASS): 1.0 POUND DENSITY. SOUND TRANSMISSION COEFFICIENT: 27.

3. LOCATION AS INDICATED ON DRAWINGS.

3.1 INSTALLATION

A. GENERAL: INSTALL ACOUSTICAL PANEL CEILINGS TO COMPLY WITH PUBLICATIONS REFERENCED BELOW PER MANUFACTURER'S WRITTEN INSTRUCTIONS AND CISCA'S "CEILING SYSTEMS HANDBOOK." STANDARD FOR CEILING SUSPENSION SYSTEM INSTALLATIONS: COMPLY WITH ASTM C 636.

B. SUSPEND CEILING HANGERS FROM BUILDING'S STRUCTURAL MEMBERS AND AS FOLLOWS:

INSTALL HANGERS PLUMB AND FREE FROM CONTACT WITH OBJECTS WITHIN CEILING PLENUM THAT ARE NOT PART OF SUPPORTING STRUCTURE OR OF CEILING SUSPENSION SYSTEM. ATTACHMENT TO DUCTS, PIPING, AND OTHER NON-STRUCTURAL MEMBERS IS

2. SPLAY HANGERS ONLY WHERE REQUIRED AND TO MISS OBSTRUCTIONS; OFFSET RESULTING HORIZONTAL FORCES BY BRACING, COUNTERSPLAYING, OR OTHER EQUALLY EFFECTIVE MEANS.

3. SPACE HANGERS NOT MORE THAN 48 INCHES O.C. ALONG EACH MEMBER SUPPORTED DIRECTLY FROM HANGERS, UNLESS OTHERWISE INDICATED; AND PROVIDE HANGERS NOT MORE THAN 8 INCHES FROM ENDS OF EACH MEMBER.

C. SECURE BRACING WIRES TO CEILING SUSPENSION MEMBERS AND TO SUPPORTS WITH A MINIMUM OF FOUR TIGHT TURNS. SUSPEND BRACING FROM BUILDING'S STRUCTURAL STEEL AS INDICATED AND AS REQUIRED FOR HANGERS, WITHOUT ATTACHING TO PERMANENT METAL FORMS, STEEL DECK, OR STEEL DECK TABS.

D. INSTALL EDGE MOLDINGS AND TRIM OF TYPE INDICATED AT PERIMETER OF ACOUSTICAL CEILING AREA AND WHERE NECESSARY TO CONCEAL EDGES OF ACOUSTICAL PANELS.

E. INSTALL ACOUSTICAL PANELS WITH UNDAMAGED EDGES AND FITTED ACCURATELY INTO SUSPENSION SYSTEM RUNNERS AND EDGE MOLDINGS. SCRIBE AND CUT PANELS AT BORDERS AND PENETRATIONS TO PROVIDE A NEAT. PRECISE FIT. INSTALL HOLD-DOWN CLIPS ON PANELS AS RECOMMENDED BY PANEL MANUFACTURER'S WRITTEN INSTRUCTIONS.

SECTION 09651 - RESILIENT FLOORING

2.1 MATERIALS

A. RESILIENT TILE: VCT:

> a. MANUFACTURER: AS INDICATED ON DRAWINGS b. STYLE: AS INDICATED ON DRAWINGS.

c. INSTALLATION:

B. RUBBER WALL BASE:

1. MANUFACTURER AND COLOR: AS INDICATED ON DRAWINGS.

2. STYLE: 4 INCH TOELESS AT CARPET AND 4 INCH COVE WITH TOPSET TOE AT ALL OTHER AREAS.

3. TRANSITION PIECES: PREMOLDED INSIDE AND OUTSIDE CORNERS AND END CAPS.

3.4 RESILIENT ACCESSORY INSTALLATION

A. USE TROWELABLE LEVELING AND PATCHING COMPOUNDS, ACCORDING TO MANUFACTURER'S WRITTEN INSTRUCTIONS, TO FILL CRACKS, HOLES, AND DEPRESSIONS IN SUBSTRATES. B. INSTALL RESILIENT FLOORING AND ACCESSORIES ACCORDING TO MANUFACTURER'S WRITTEN INSTALLATION INSTRUCTIONS. ALLOW

TIME FOR MATERIAL TO ACCLIMATE TO ROOM CONDITIONS BEFORE BEGINNING INSTALLATION. C. INSTALL WALL BASE IN LENGTHS AS LONG AS PRACTICABLE WITHOUT GAPS AT SEAMS AND WITH TOPS OF ADJACENT PIECES ALIGNED.

SECTION 09255 - GYPSUM BOARD ASSEMBLIES

2.1 PRODUCTS

A. STEEL STUDS AND RUNNERS: ASTM C 645, WITH FLANGE EDGES OF STUDS BENT BACK 90 DEGREES AND DOUBLED OVER TO FORM

3/16-INCH-WIDE MINIMUM LIP (RETURN), AND COMPLYING WITH THE FOLLOWING: 1. 24 GUAGE, UNLESS OTHERWISE NOTED.

2. THICKNESS: 1-5/8 INCH OR AS INDICATED ON DRAWINGS. 3. DEPTH: AS INDICATED ON DRAWINGS.

4. PROTECTIVE COATING: MANUFACTURER'S STANDARD CORROSION-RESISTANT COATING.

B. STEEL RIGID FURRING CHANNELS: ASTM C 645, HAT SHAPED METAL AS FOLLOWS: 1. THICKNESS AND DEPTH: AS INDICATED ON DRAWINGS.

PROTECTIVE COATING: MANUFACTURER'S STANDARD CORROSION-RESISTANT COATING. C. GYPSUM BOARD PRODUCTS: PROVIDE GYPSUM AND CEMENTITIOUS TILE BACKER BOARD OF TYPES INDICATED ON DRAWINGS IN

1. WIDTHS: PROVIDE GYPSUM BOARD IN WIDTHS OF 48 INCHES.

MAXIMUM LENGTHS AVAILABLE THAT WILL MINIMIZE END-TO-END BUTT JOINTS IN EACH AREA INDICATED TO RECEIVE GYPSUM BOARD

2. EDGES: TAPERED, EXCEPT SQUARE AT MULTILAYER APPLICATIONS. REFERENCE SECTION 07540 FOR SHEATHING UNDER VERTICAL ROOFING SURFACES (PARAPETS).

D. JOINT TREATMENT MATERIALS: PROVIDE JOINT TREATMENT MATERIALS COMPLYING WITH ASTM C 475 AND THE RECOMMENDATIONS OF BOTH THE MANUFACTURERS OF SHEET PRODUCTS AND OF JOINT TREATMENT MATERIALS FOR EACH APPLICATION INDICATED.

E. ACCESSORIES: CORNERBEAD, EDGE TRIM, AND CONTROL JOINTS COMPLYING WITH ASTM C 1047 F. FASTENERS: PROVIDE FASTENERS OF TYPE, MATERIAL, SIZE, CORROSION RESISTANCE, HOLDING POWER, AND OTHER PROPERTIES

REQUIRED TO FASTEN STEEL FRAMING AND FURRING MEMBERS SECURELY TO SUBSTRATES INVOLVED; COMPLYING WITH THE RECOMMENDATIONS OF GYPSUM BOARD SYSTEM MANUFACTURERS FOR APPLICATIONS INDICATED.

 SELF-DRILLING, SELF-TAPPING, STEEL DRYWALL SCREWS COMPLYING WITH ASTM C 1002 FOR APPLICATIONS INDICATED. 2. FIRE RATED CONSTRUCTION: SCREW TYPE AND LENGTH SHALL COMPLY WITH APPLICABLE CODE REQUIREMENTS AND UL LISTINGS

AS INDICATED IN DRAWINGS.

3.1 INSTALLATION A. INSTALL PER MANUFACTURER'S WRITTEN INSTRUCTIONS. COMPLY WITH ASTM C 840 AND GA-216; ALL RAW EDGES MUST BE FINISHED.

B. PROVIDE CONTROL JOINTS AT A MAXIMUM SPACING OF 30' AND AT ONE JAMB OF EACH DOOR.

SECTION 09900 - PAINTING

1.1 WARRANTY

PROVIDE TWO YEAR WARRANTY AGAINST FADING. PEELING. CHALKING. AND FAILURES. WARRANTY SHALL COMMENCE FROM THE DAY OF SUBSTANTIAL COMPLETION. CONTRACTOR TO REPAINT SURFACES AS DIRECTED BY THE OWNER IF WARRANTY IS NOT ATTAINED WITHIN THE SPECIFIED PERIOD AT NO ADDITIONAL COST TO THE OWNER.

1.2 SUBMITTALS

CONTRACTOR SHALL PROVIDE PAINT SAMPLES OF EACH SPECIFIED PAINT COLOR FOR REVIEW BY THE OWNER'S REPRESENTATIVE.

PAINT PRODUCT DATA AND MATERIAL INVOICE TO BE PROVIDED IN CLOSE-OUT DOCUMENTS.

2.1 MATERIALS

MANUFACTURERS: ALL MATERIAL IN THIS SECTION IS TO BE PURCHASED BY THE GENERAL CONTRACTOR FROM SHERWIN WILLIAMS, PPG

INDUSTRIES INC., OR BEHR PROCESS CORPORATION.

MATERIAL COMPATIBILITY: PROVIDE BLOCK FILLERS, PRIMERS, UNDERCOATS AND FINISH-COAT MATERIALS THAT ARE FROM THE SAME MANUFACTURER AS THE FINISH COATS AND COMPATIBLE WITH ONE ANOTHER AND THE SUBSTRATES INDICATED UNDER CONDITIONS OF SERVICE AND APPLICATION, AS DEMONSTRATED BY MANUFACTURER BASED ON TESTING AND FIELD EXPERIENCE.

MATERIAL QUALITY: PROVIDE MANUFACTURER'S "BEST-QUALITY" PAINT MATERIAL OF THE VARIOUS COATING TYPES SPECIFIED. PAINT-MATERIAL CONTAINERS NOT DISPLAYING MANUFACTURER'S PRODUCT IDENTIFICATION WILL NOT BE ACCEPTABLE.

REGULATORY REQUIREMENTS:

1. SURFACE BURNING CHARACTERISTICS IN ACCORDANCE WITH ASTM E-84 FOR CLASS I OR A FINISH:

a. FLAME SPREAD (NON-COMBUSTIBLE SURFACES): LESS THAN 25.

b. SMOKE DENSITY (NON-COMBUSTIBLE SURFACES): LESS THAN 450.

2. PROVIDE PAINT AND COATING MATERIALS THAT CONFORM TO FEDERAL, STATE AND LOCAL RESTRICTIONS FOR VOLATILE ORGANIC COMPOUNDS (VOC) CONTENT.

2.4 PROJECT CONDITIONS

APPLY PAINTS ONLY WHEN THE TEMPERATURE OF SURFACES TO BE PAINTED AND SURROUNDING AIR TEMPERATURES ARE BETWEEN 50 AND 90 DEG F. DO NOT APPLY PAINT IN SNOW, RAIN, FOG OR MIST; OR WHEN THE RELATIVE HUMIDITY EXCEEDS 85 PERCENT; OR TO DAMP OR WET SURFACES. REFER TO MANUFACTURER SPECIFICATIONS FOR APPLICATIONS.

3.1 PREPARATION AND APPLICATION

GENERAL: REMOVE HARDWARE AND HARDWARE ACCESSORIES, PLATES, MACHINED SURFACES, LIGHTING FIXTURES AND SIMILAR ITEMS ALREADY INSTALLED THAT ARE NOT TO BE PAINTED. IF REMOVAL IS IMPOSSIBLE BECAUSE OF THE SIZE OR WEIGHT OF THE ITEM, PROVIDE SURFACE-APPLIED PROTECTION BEFORE SURFACE PREPARATION AND PAINTING.

SURFACE PREPARATION: CLEAN AND PREPARE SURFACES TO BE PAINTED ACCORDING TO MANUFACTURER'S WRITTEN INSTRUCTIONS FOR EACH PARTICULAR SUBSTRATE CONDITION AND AS SPECIFIED.

PAINT EACH SIDE OF EXTERIOR DOORS (INCLUDING TOP AND BOTTOM OF DOORS), FRAMES AND COILING DOORS TO MATCH ADJACENT WALLS UNLESS NOTED OTHERWISE.

APPLY FIRST COAT TO SURFACES AS SOON AS PRACTICAL AFTER PREPARATION AND BEFORE SUBSEQUENT SURFACE DETERIORATION.

1. DO NOT APPLY SUCCEEDING COATS UNTIL THE PREVIOUS COAT HAS CURED AS RECOMMENDED BY THE MANUFACTURER.

2. OMIT PRIMER ON METAL SURFACES THAT HAVE BEEN SHOP PRIMED AND TOUCHUP PAINTED.

3. IF UNDERCOATS, STAINS OR OTHER CONDITIONS SHOW THROUGH FINAL COAT OF PAINT, APPLY ADDITIONAL COATS UNTIL PAINT FILM IS OF UNIFORM FINISH, COLOR AND APPEARANCE. GIVE SPECIAL ATTENTION TO ENSURE EDGES, CORNERS, CREVICES, WELDS AND EXPOSED FASTENERS RECEIVE A DRY FILM THICKNESS EQUIVALENT TO THAT OF FLAT SURFACES.

FOG PAINT: USE SPRAY EQUIPMENT FOR APPLICATION OF PAINT AT LOCATIONS INDICATED ON DRAWINGS. USE AIRLESS SPRAY EQUIPMENT WITH ORIFICE SIZE AS RECOMMENDED BY THE MANUFACTURER. COLOR: AS INDICATED ON DRAWINGS.

MINIMUM COATING THICKNESS: APPLY PAINT MATERIALS NO THINNER THAN MANUFACTURER'S RECOMMENDED SPREADING RATE. PROVIDE THE TOTAL DRY FILM THICKNESS OF THE ENTIRE SYSTEM AS RECOMMENDED BY THE MANUFACTURER AND AS SPECIFIED.

PRIME COATS: BEFORE APPLYING FINISH COATS, APPLY A PRIME COAT OF MATERIAL, AS RECOMMENDED BY MANUFACTURER, TO MATERIAL THAT IS REQUIRED TO BE PAINTED OR FINISHED AND THAT HAS NOT BEEN PRIME COATED BY OTHERS. RECOAT PRIMED AND SEALED SURFACES WHERE EVIDENCE OF SUCTION SPOTS OR UNSEALED AREAS IN FIRST COAT APPEARS. TO ENSURE A FINISH COAT WITH NO BURN THROUGH OR OTHER DEFECTS DUE TO INSUFFICIENT SEALING.

PIGMENTED (OPAQUE) FINISHES: COMPLETELY COVER SURFACES AS NECESSARY TO PROVIDE A SMOOTH, OPAQUE SURFACE OF UNIFORM FINISH, COLOR, APPEARANCE AND COVERAGE. CLOUDINESS, SPOTTING, HOLIDAYS, LAPS, BRUSH MARKS, RUNS, SAGS, ROPINESS OR OTHER SURFACE IMPERFECTIONS WILL NOT BE ACCEPTABLE.

INTERIOR COLUMNS, JOISTS, GIRDERS, OVERHEAD PIPING, CONDUIT AND RACEWAYS SHALL BE PAINTED. COLOR: AS INDICATED ON DRAWINGS. COLUMNS ALONG EXTERIOR WALLS SHALL BE PAINTED TO MATCH ADJACENT WALL (FLOOR TO BOTTOM OF GIRDER). UNLESS NOTED OTHERWISE.

ALL UTILITY DEVICES, CONDUIT, PIPING, ETC. WITHIN 12 INCHES OF A PAINTED VERTICAL SURFACE SHALL BE PAINTED TO MATCH SURFACE AS ALLOWABLE BY THE UTILITY PROVIDER OR DEVICE MANUFACTURER.

ĸ EXTERIOR FIRE SUPPRESSION PIPING: PAINT ALL EXTERIOR FIRE SUPPRESSION PIPING TO MATCH ADJACENT DECK COLOR OR WALL SURFACE WHEN VERTICAL, OR AS INDICATED ON DRAWINGS.

PAINT ALL EXPOSED SHEET METAL FLASHING, COPING AND TRIM. COLOR: AS INDICATED ON DRAWINGS.

NO PAINTING OF ANY HOT DIPPED GALVANIZED METAL WILL BE ALLOWED UNLESS WRITTEN APPROVAL IS PROVIDED BY THE ARCHITECT

3.2 EXTERIOR FINISH SCHEDULE

BEHR, PPG INDUSTRIES INC., AND SHERWIN WILLIAMS (SW) ARE APPROVED MANUFACTURERS. PRODUCTS ARE SPECIFIED BELOW FOR EACH TYPE OF FINISH. USE ONLY ONE MANUFACTURER FOR EACH FINISH BUT ALL PRODUCTS SHALL COME FROM THE SAME CHOSEN

FERROUS METAL:

1. FIRST COAT: BEHR PREMIUM PLUS INT/EXT MULTI-SURFACE PRIMER AND SEALER (436) SW PRO INDUSTRIAL PRO-CRYL ACRYLIC PRIMER, B66W310

2. SECOND COAT: BEHR PREMIUM INT/EXT DIRECT-TO-METAL GLOSS (8200 SERIES) SW PRO INDUSTRIAL DTM INDUSTRIAL ACRYLIC GLOSS, B66W1051

3. FINISH COAT: BEHR PREMIUM INT/EXT DIRECT-TO-METAL GLOSS (8200 SERIES) SW PRO INDUSTRIAL DTM INDUSTRIAL ACRYLIC GLOSS, B66W1051

GALVANIZED METAL:

1. FIRST COAT: BEHR PREMIUM PLUS INT/EXT MULTI-SURFACE PRIMER AND SEALER (436)

SW PRO INDUSTRIAL PRO-CRYL ACRYLIC PRIMER, B66W310 2. SECOND COAT: BEHR PREMIUM INT/EXT DIRECT-TO-METAL GLOSS (8200 SERIES)

SW PRO INDUSTRIAL DTM INDUSTRIAL ACRYLIC GLOSS, B66W1051 3. FINISH COAT: BEHR PREMIUM INT/EXT DIRECT-TO-METAL GLOSS (8200 SERIES)

SW PRO INDUSTRIAL DTM INDUSTRIAL ACRYLIC GLOSS, B66W1051

PRECAST CONCRETE WALL PANELS:

1. FIRST COAT: BEHR PREMIUM PLUS INT/EXT MULTI-SURFACE PRIMER AND SEALER (436). SW LOXON CONCRETE & MASONRY PRIMER, INTERIOR/EXTERIOR LATEX, A24W8300

2. SECOND COAT: BEHR PREMIUM ELASTOMERIC MASONRY, STUCCO, & BRICK PAINT(68)

3. FINISH COAT: BEHR PREMIUM ELASTOMERIC MASONRY, STUCCO, & BRICK PAINT(68)

SW A-100 EXTERIOR 100% ACRYLIC SATIN. A82W151

SW A-100 EXTERIOR 100% ACRYLIC SATIN, A82W151

D. CEDAR FENCE:

1. FIRST COAT: BEHR PREMIUM SEMI-TRANSPARENT WEATHERPROOFING ALL-IN-ONE WOOD STAIN & SEALER 5077 TINT BASE; 5522 CEDAR NATURALTONE SW SUPERDECK SEMI-TRANSPARENT WATERBOREN STAIN, SD3T15

CONCRETE MASONRY UNIT:

1. FIRST COAT: KILZ PRO-X P50 BLOCK FILLER PRIMER SW PREPRITE BLOCK FILLER, B25W25

SW SHERLASTIC ELASTOMERIC COATING, A5W151

2. SECOND COAT: BEHR PREMIUM ELASTOMERIC MASONRY, STUCCO, & BRICK PAINT (68)

SW SHERLASTIC ELASTOMERIC COATING, A5W151 3. FINISH COAT: BEHR PREMIUM ELASTOMERIC MASONRY, STUCCO, & BRICK PAINT(68)

SEALED CONCRETE MASONRY UNIT:

1. SMOOTH CMU: ONE COAT OF OKON S-40.

SW LOXON VERTICAL WATER REPELLANTS 7% SILOXANE 7% SILOXANE, A10T7

2. SPLIT FACE CMU: TWO COATS OF OKON S-40.

TWO COATS OF SW LOXON VERTICAL WATER REPELLANTS 7% SILOXANE 7% SILOXANE, A10T7

ROOF WARNING LINES APPLIED TO TPO ROOFING SYSTEM:

SW EXTREME BONDING PRIMER B51W150

1. FIRST COAT: KILZ ADHESION BONDING PRIMER (2111)

2. SECOND COAT: BEHR PREMIUM INT/EXT DIRECT-TO-METAL GLOSS (8200 SERIES)

SW PRO INDUSTRIAL DTM ACRYLIC GLOSS, B66W1051

3. FINISH COAT: BEHR PREMIUM INT/EXT DIRECT-TO-METAL GLOSS (8200 SERIES) SW PRO INDUSTRIAL DTM ACRYLIC GLOSS, B66W1051

EXTERIOR VIVID. BRIGHT. DARK ACCENT COLORS: SUPERIOR COLOR RETENTION.

1. FIRST COAT: BEHR MARQUEE SATIN SW RESILIENCE EXTERIOR LATEX SATIN, K43W51

2. SECOND COAT: BEHR MARQUEE SATIN

SW RESILIENCE EXTERIOR LATEX SATIN, K43W51

3.3 INTERIOR FINISH SCHEDULE FERROUS METAL:

1. FIRST COAT: BEHR PREMIUM PLUS INT/EXT MULTI-SURFACE PRIMER AND SEALER (436)

SW PRO INDUSTRIAL PRO-CRYL ACRYLIC PRIMER, B66W310 2. SECOND COAT: BEHR PREMIUM INT/EXT DIRECT-TO-METAL GLOSS (8200 SERIES) SW PRO INDUSTRIAL DTM ACRYLIC GLOSS, B66W1051

3. FINISH COAT: BEHR PREMIUM INT/EXT DIRECT-TO-METAL GLOSS (8200 SERIES) SW PRO INDUSTRIAL DTM ACRYLIC GLOSS, B66W1051

GYPSUM BOARD WALLS:

1. FIRST COAT: KILZ PRO-X P10 PVA DRYWALL PRIMER SW HIGH BUILD DRYWALL PRIMER, B28W8601

2. SECOND COAT: BEHR PRO INTERIOR EGGSHELL (PR330) SW PROMAR 200 ZERO VOC INTERIOR LATEX EGGSHELL, B20W12651

3. FINISH COAT: BEHR PLUS INTERIOR EGGSHELL (PR330) SW PROMAR 200 ZERO VOC INTERIOR LATEX EGGSHELL, B20W12651

GYPSUM BOARD WALLS AT RESTROOMS:

1. FIRST COAT: KILZ PRO-X P10 PVA DRYWALL PRIMER SW HIGH BUILD DRYWALL PRIMER, B28W8601

2. SECOND COAT: BEHR PRO INTERIOR EGGSHELL (PR330) SW PROMAR 200 ZERO VOC INTERIOR LATEX EGGSHELL, B20W12651

3. FINISH COAT: BEHR PRO INTERIOR EGGSHELL (PR330) SW PROMAR 200 ZERO VOC INTERIOR LATEX EGGSHELL, B20W12651

GYPSUM BOARD CEILINGS:

1. FIRST COAT: KILZ PRO-X P10 PVA DRYWALL PRIMER SW HIGH BUILD DRYWALL PRIMER, B28W8601

2. SECOND COAT: BEHR PRO INTERIOR EGGSHELL (PR330) SW PROMAR 200 ZERO VOC INTERIOR LATEX EGGSHELL, B20W12651

3. FINISH COAT: BEHR PRO INTERIOR EGGSHELL (PR330) SW PROMAR 200 ZERO VOC INTERIOR LATEX EGGSHELL, B20W12651

E. PLYWOOD:

1. FIRST COAT: MINIWAX WATER-BASED PRE-STAIN WOOD CONDITIONER

2. SECOND COAT: MINIWAX POLYCRYLIC CLEAR SEMI-GLOSS FINISH (4444)

3. FINISH COAT: MINIWAX POLYCRYLIC CLEAR SEMI-GLOSS FINISH (4444)

OVERHEAD STRUCTURAL STEEL AND DECKING:

1. FINISH COAT: KILZ PRO-X DRY FALL FLAT (PX890) SW WATERBORNE ACRYILC DRY FALL FLAT, B42W1

SW PRO INDUSTRIAL PRO-CRYL ACRYLIC PRIMER, B66W310

METAL DOOR FRAMES:

1. FIRST COAT: BEHR PREMIUM PLUS INT/EXT MULTI-SURFACE PRIMER AND SEALER (436)

2. SECOND COAT: BEHR PREMIUM INT/EXT DIRECT-TO-METAL GLOSS (8200 SERIES) SW PRO INDUSTRIAL HIGH PERFORMANCE ARCYLIC, SEMI-GLOSS, B66W651

3. FINISH COAT: BEHR PREMIUM INT/EXT DIRECT-TO-METAL GLOSS (8200 SERIES)

SW PRO INDUSTRIAL HIGH PERFORMANCE ARCYLIC, SEMI-GLOSS, B66W651

CONCRETE MASONRY UNIT AT WASH DOWN AREA:

1. FIRST COAT: BEHR PREMIUM CONCRETE & MASONRY (BLOCK FILLER) WATERPROOFER (870)

2. SECOND COAT: MONOCHEM EPOXYGUARD 200 WATERBORNE EPOXY ACRYLIC COATING (8900) SW PRO INDUSTRIAL WATERBASED EPOXY, GLOSS (PART A), B73W311

3. FINISH COAT: MONOCHEM EPOXYGUARD 200 WATERBORNE EPOXY ACRYLIC COATING (8900)

SW PRO INDUSTRIAL WATERBASED EPOXY, GLOSS (PART A), B73W311

SW HEAVY DUTY BLOCK FILLER, B42W46

GYPSUM BOARD WALLS AT JANITOR'S CLOSET: 1. FIRST COAT: KILZ PREMIUM INT/EXT WATER-BASE PRIMER (1300)

SW HIGH BUILD DRYWALL PRIMER B28W8601

2. SECOND COAT: MONOCHEM EPOXYGUARD 200 WATERBORNE EPOXY ACRYLIC COATING (8900)

SW PRO INDUSTRIAL PRECATALYZED WATERBASED EPOXY, K45W00151

SW PRO INDUSTRIAL PRECATALYZED WATERBASED EPOXY, K45W151 3. FINISH COAT: MONOCHEM EPOXYGUARD 200 WATERBORNE EPOXY ACRYLIC COATING (8900)

SECTION 107313 AWNINGS

2.1 MATERIALS

A. AWNTEX BY TRI VANTAGE.

B. LOCATION AS INDICATED ON DRAWINGS.

1. AWNTEX 160 FR OPEN WEAVE AWNING FABRIC. COLOR: AS INDICATED IN DRAWINGS. APPROXIMATE 13.9% OPENNESS PANELS TO BE MADE IN 24' X 4' SIZES AND ANCHORED TO TOPS OF EXISTING STEEL I' BEAMS OF TRELLIS. 2. ALUMINUM FRAMES: 1" X 2" EXTRUDED ALUMINUM STAPLE-STITCH TUBES WITH SPREADERS TO KEEP FABRIC TIGHT. FRAMES TO BE MILL ALUMINUM FINISH.

for Code Compliance



ISSUE BLOCK CHECKED BY:

DOCUMENT DATE: 11.06.2023






DOCUMENTS WITHOUT AN ARCHITECT

SIGNATURE SHALL BE CONSIDERE

CS1.2

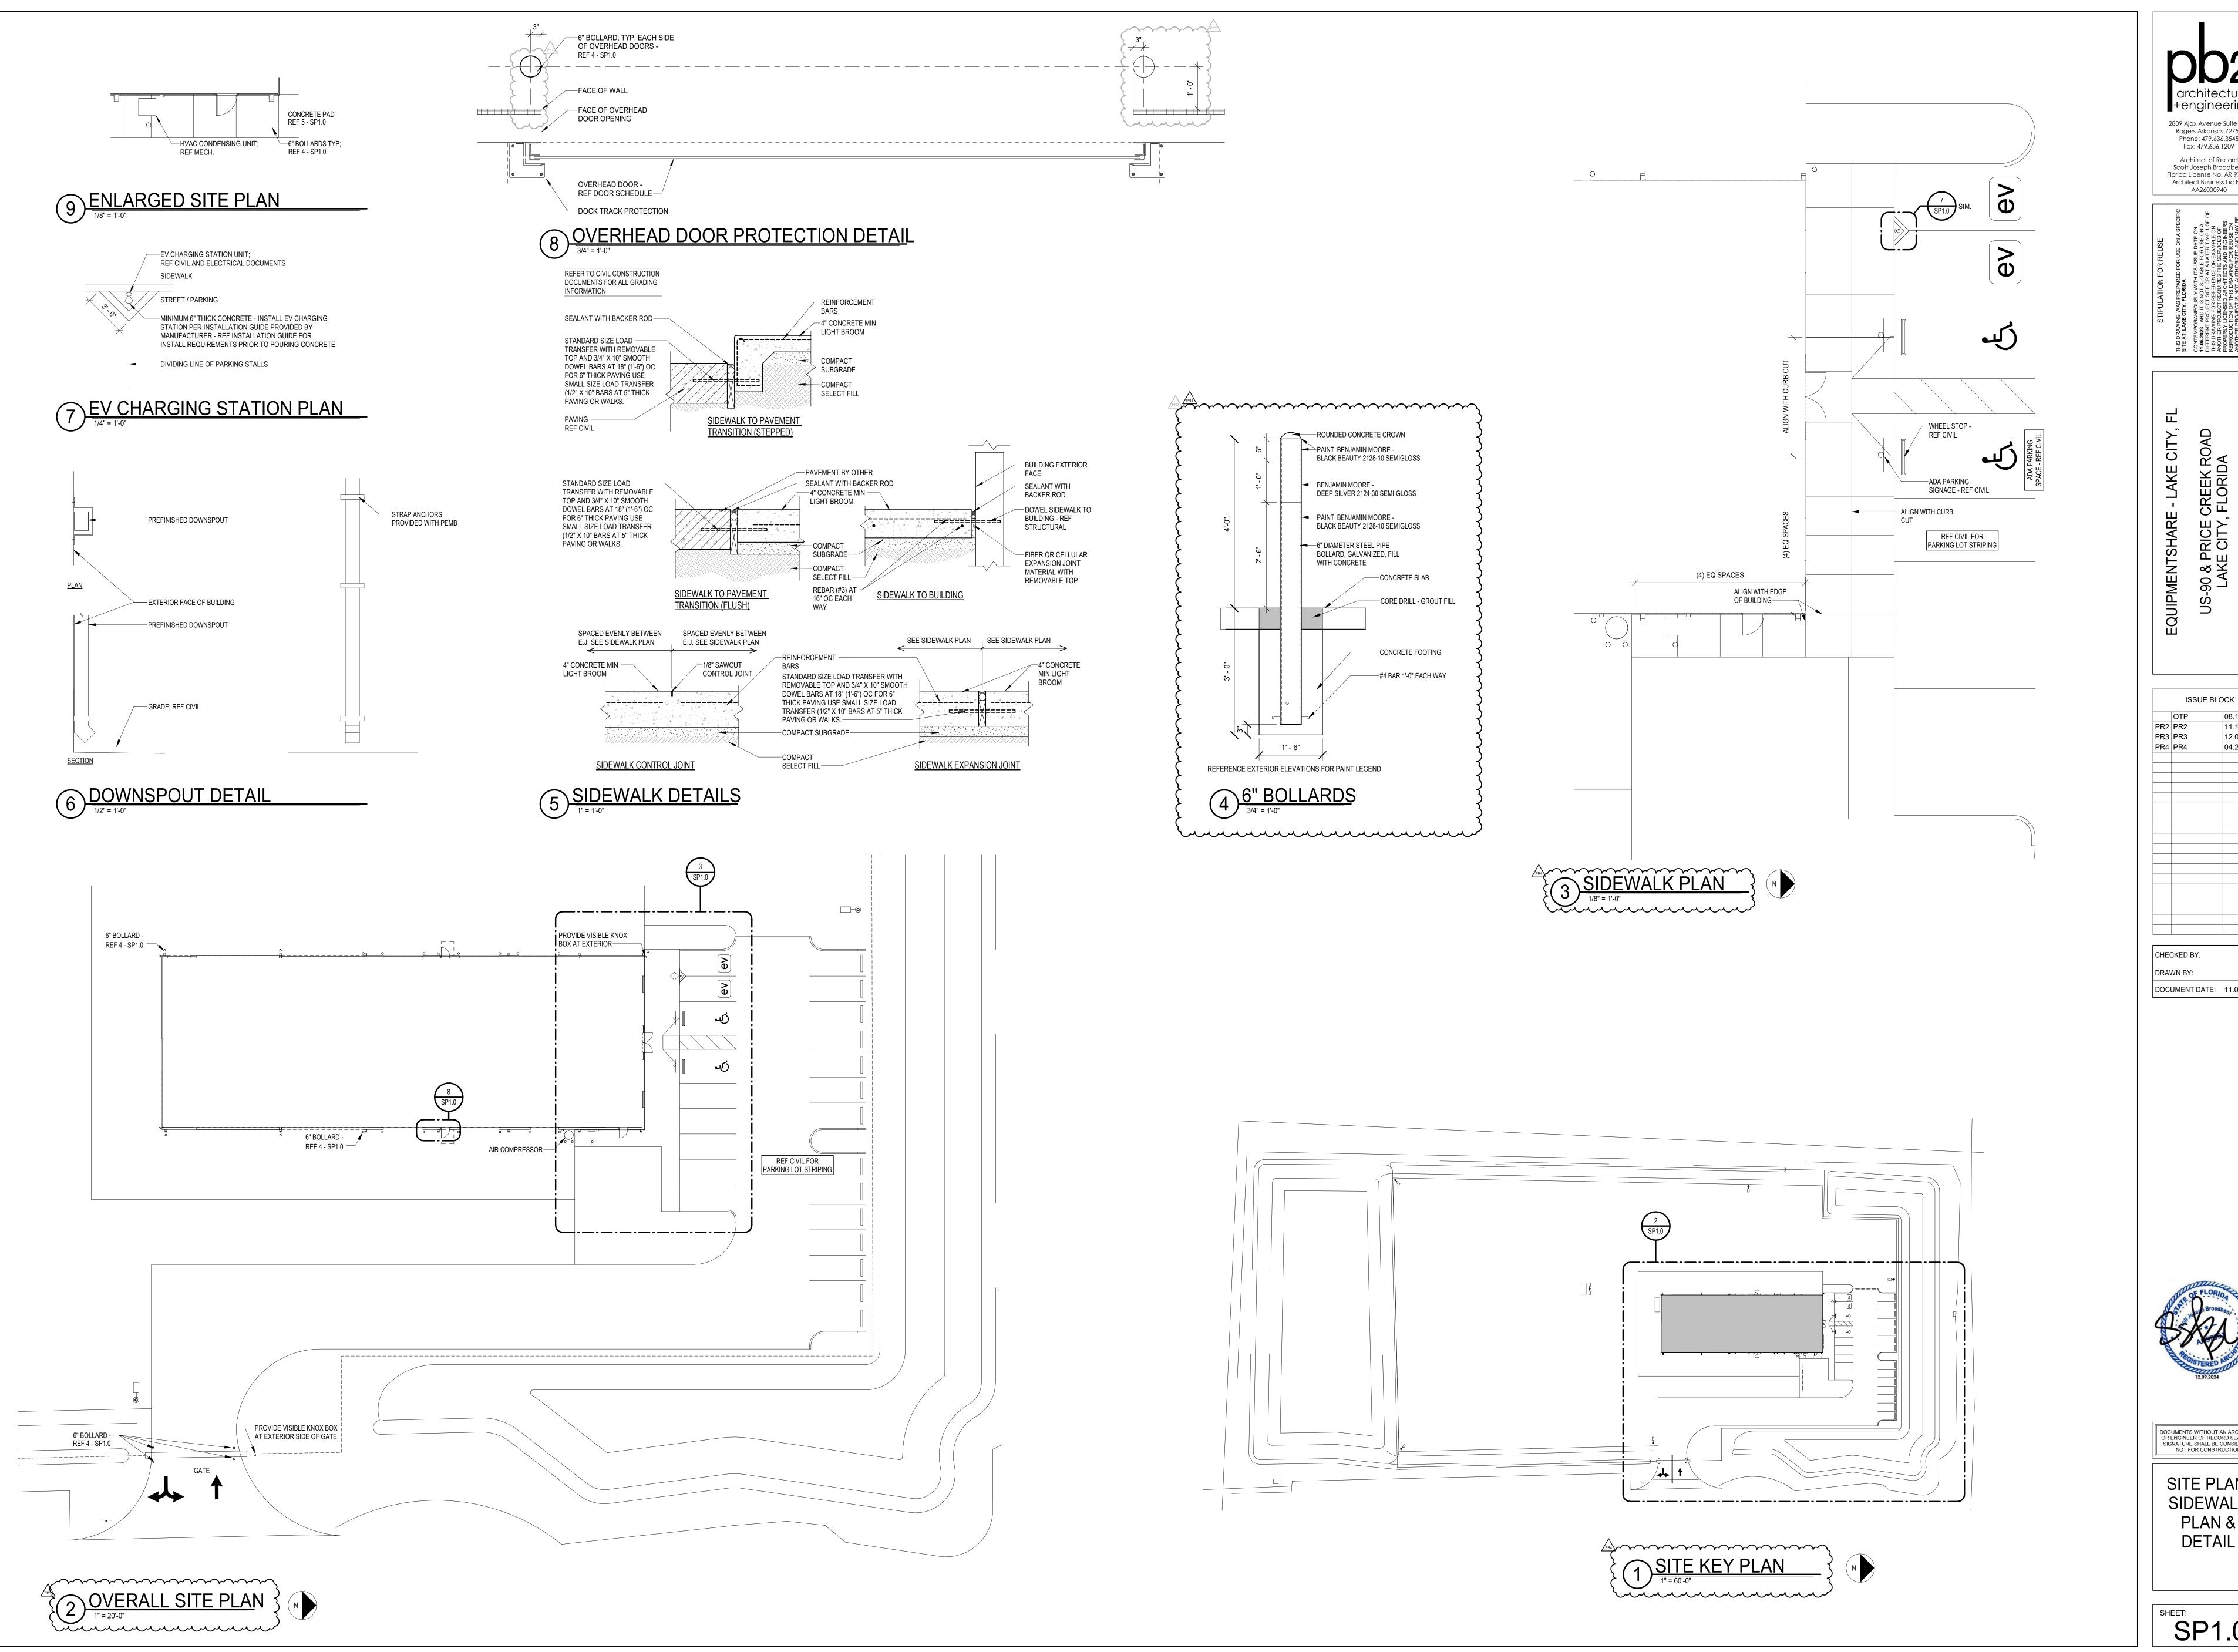

+engineering 2809 Ajax Avenue Suite 100 Rogers Arkansas 72758 Phone: 479.636.3545 Fax: 479.636.1209 Architect of Record Scott Joseph Broadbent Florida License No. AR 97891 Architect Business Lic No. AA26000940

CREEK ROAD , FLORIDA

CHECKED BY: DOCUMENT DATE: 11.06.2023


08.11.2023 11.10.2023 12.01.2023

04.25.2024



DOCUMENTS WITHOUT AN ARCHITECT OR ENGINEER OF RECORD SEAL AND SIGNATURE SHALL BE CONSIDERED NOT FOR CONSTRUCTION SITE PLAN, SIDEWALK PLAN & DETAIL

SP1.0

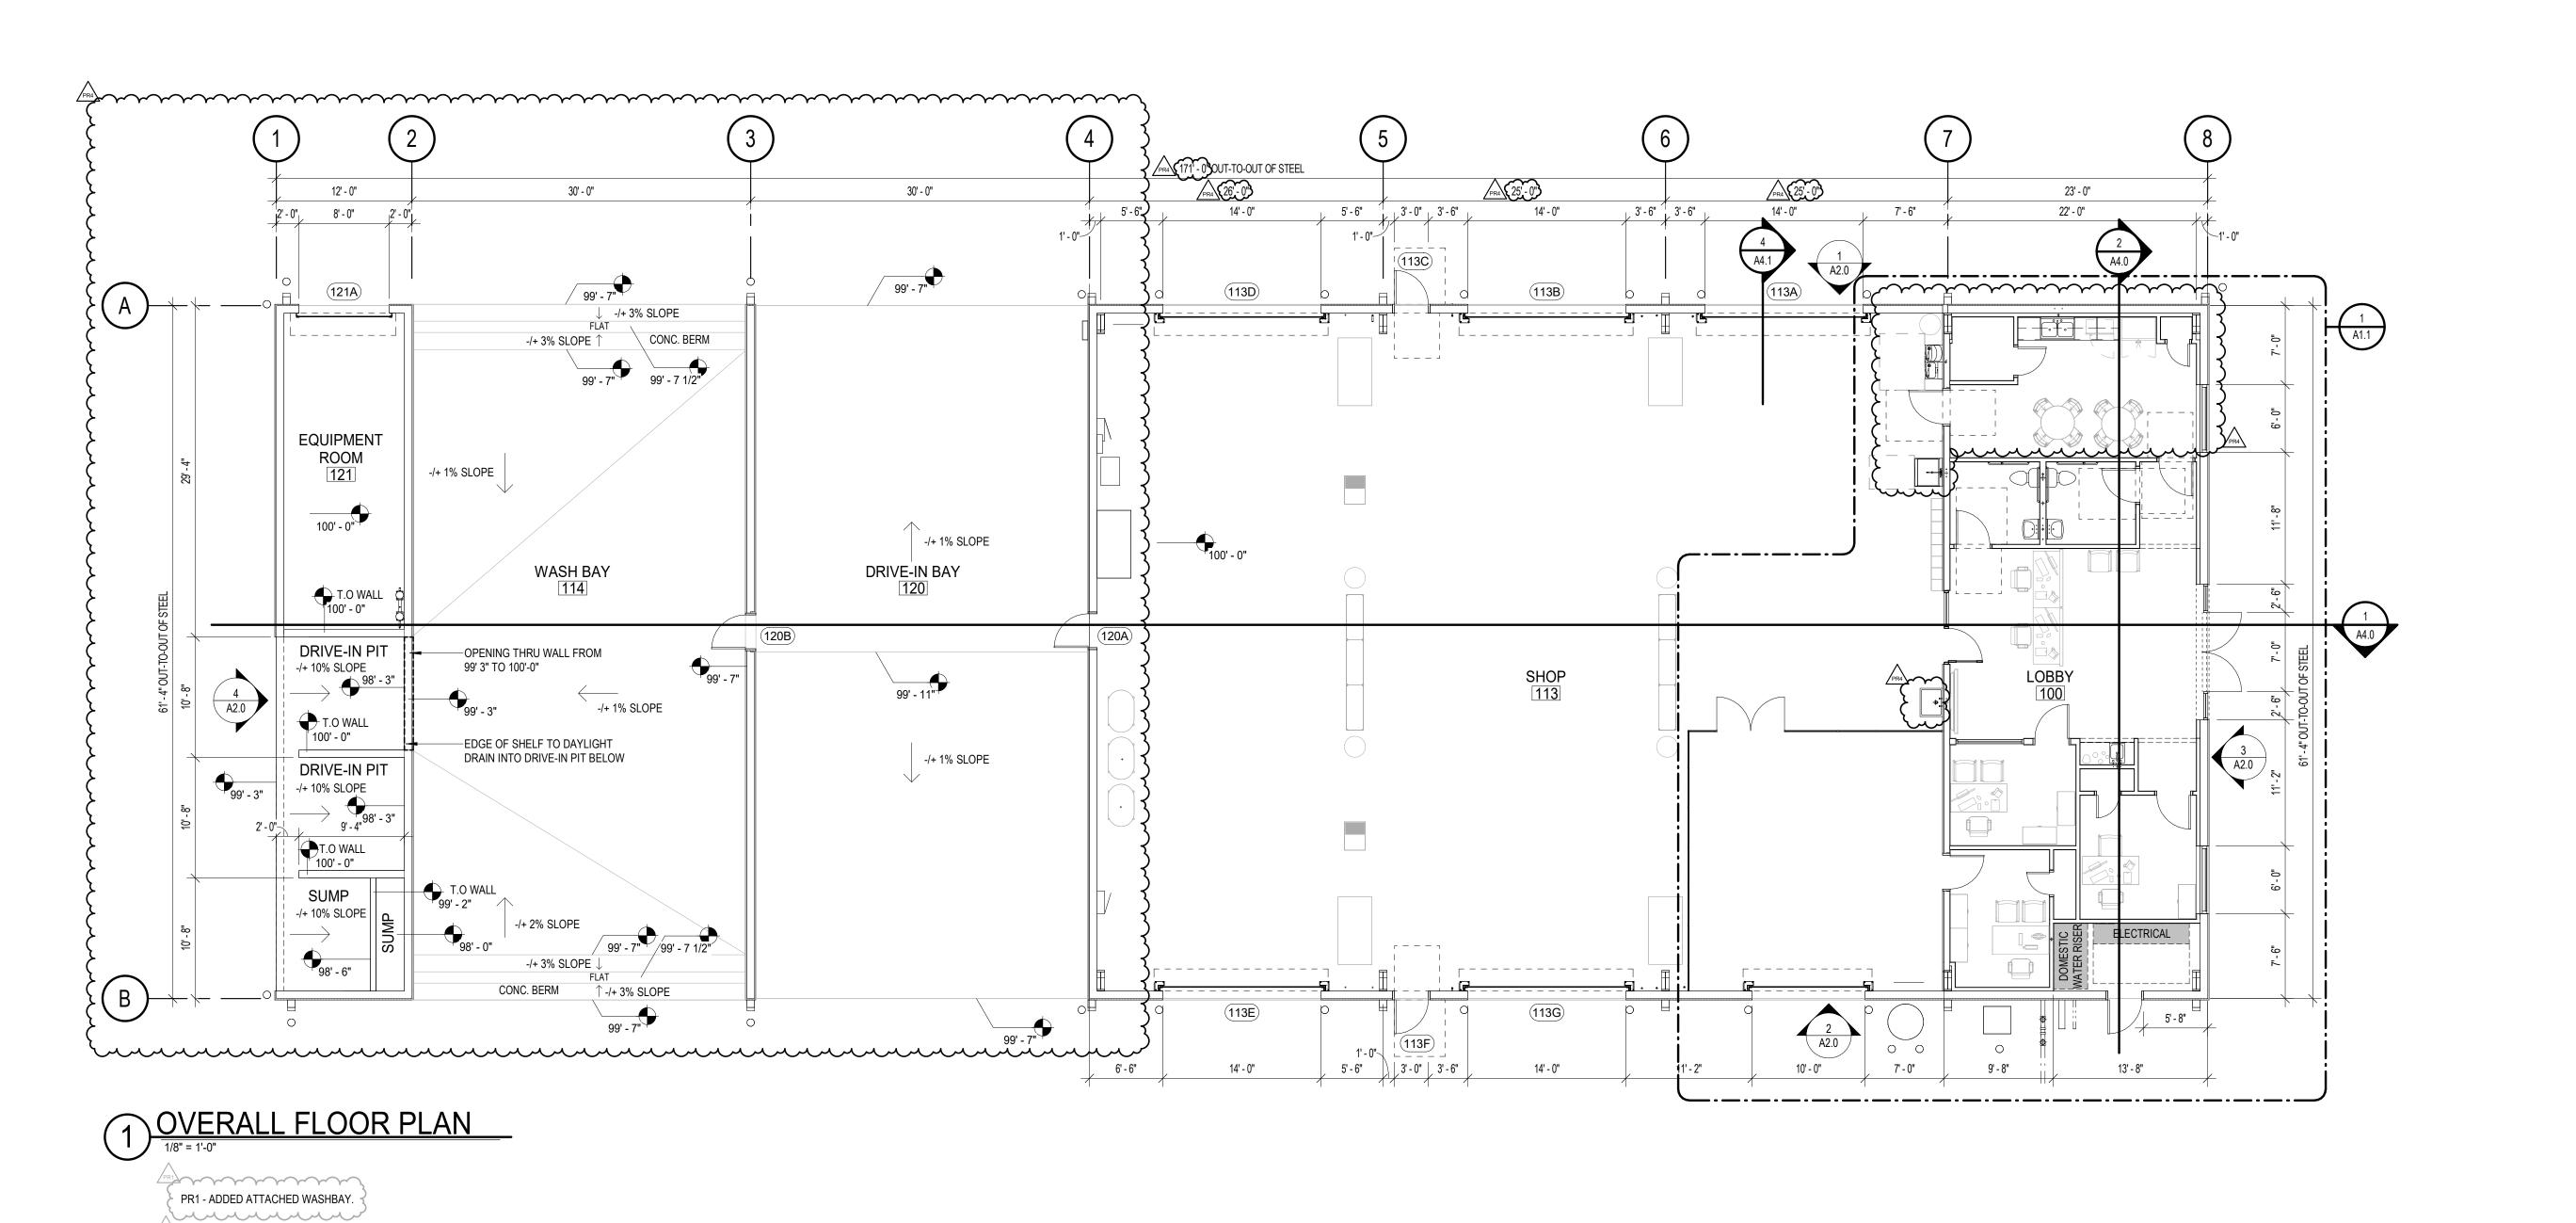

PR2 - REMOVED ATTACHED WASHBAY.

PR3 - ADDED EXTERIOR CANOPY.
REMOVED (2) REDUNDANT BOLLARDS AT REAR CORNERS OF BUILDING ALONG GRIDLINE 1.



STIPULATION FOR REUSE

THIS DRAWING WAS PREPARED FOR USE ON A SPECIFIC SITE AT: LAKE CITY, FLORIDA

CONTEMPORANEOUSLY WITH ITS ISSUE DATE ON 11.06.2023 AND IT IS NOT SUITABLE FOR USE ON A DIFFERENT PROJECT SITE OR ATA LATER TIME. USE OF THIS DRAWING FOR REFERENCE OR EXAMPLE ON ANOTHER PROJECT REQUIRES THE SERVICES OF PROPERTY LICENSED ARCHITECTS AND ENGINEERS. REPRODUCTION OF THIS DRAWING FOR REUSE ON ANOTHER PROJECT IS NOT AUTHORIZED AND MAY BE CONTRARY TO THE LAW.

US-90 & PRICE CREEK ROAD
LAKE CITY, FLORIDA

			JOB
	ISSUE	BLOCK	
	OTP	08.11.20	23
PR1	PR1	10.13.20	23
PR2	PR2	11.10.20)23
PR3	PR3	12.01.20)23
PR4	PR4	04.25.20)24
	I .		
CHE	CKED BY:		〈 G


DRAWN BY: HLB / AAS

DOCUMENT DATE: 11.06.2023





A1.0

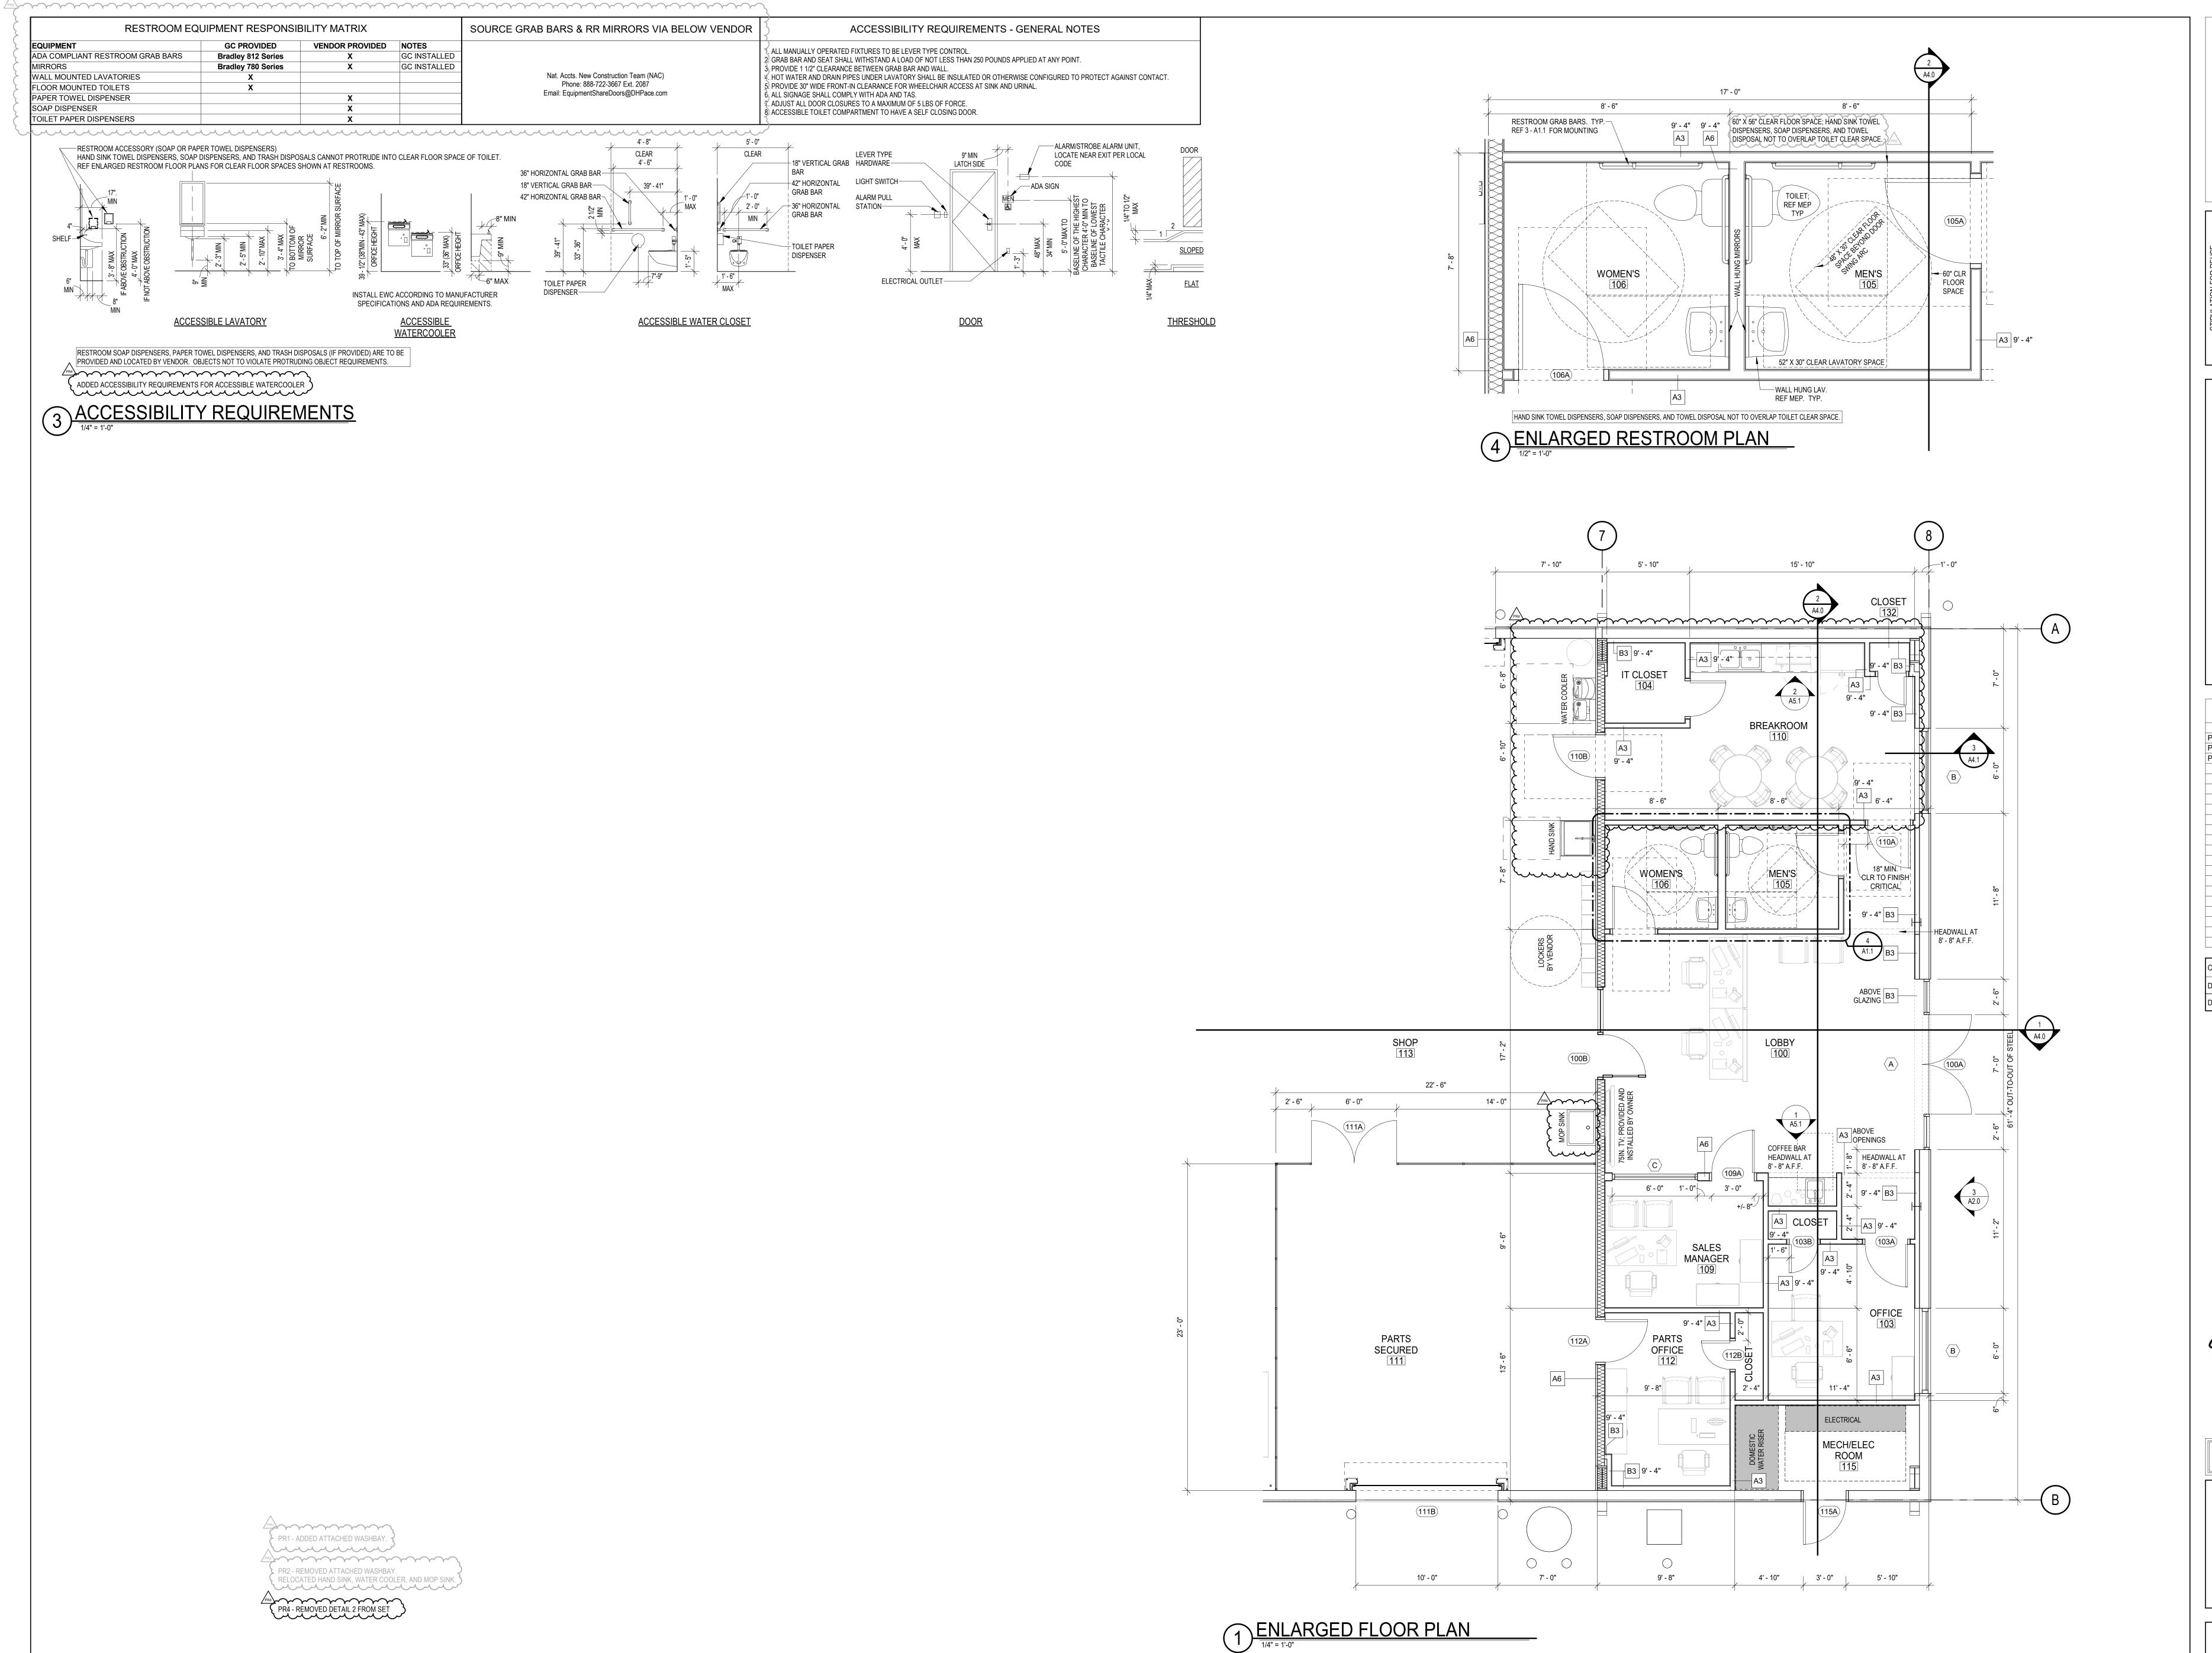

architecture
+engineering

2809 Ajax Avenue Suite 100
Rogers Arkansas 72758
Phone: 479.636.3545
Fax: 479.636.1209

Architect of Record
Scott Joseph Broadbent
Florida License No. AR 97891
Architect Business Lic No.
AA26000940

THIS DRAWING WAS PREPARED FOR USE ON A SPECIFIC SITE AT: LAKE CITY, FLORIDA

CONTEMPORANEOUSLY WITH ITS ISSUE DATE ON A 11.06.2023 AND IT IS NOT SUITABLE FOR USE ON A DIFFERENT PROJECT SITE OR AT A LATER TIME. USE OF THIS DRAWING FOR REFERENCE OR EXAMPLE ON ANOTHER PROJECT REQUIRES THE SERVICES OF PROPERLY LUCENSED ARCHITECTS AND ENGINEERS. REPRODUCTION OF THIS DRAWING FOR REUSE ON ANOTHER PROJECT IS NOT AUTHORIZED AND MAY BE CONTRARY TO THE LAW.


EQUIPMENTSHARE - LAKE CITY, FL US-90 & PRICE CREEK ROAD LAKE CITY, FLORIDA



DOCUMENTS WITHOUT AN ARCHITECT
OR ENGINEER OF RECORD SEAL AND
SIGNATURE SHALL BE CONSIDERED
NOT FOR CONSTRUCTION

ENLARGED
FLOOR
PLANS


A1.1

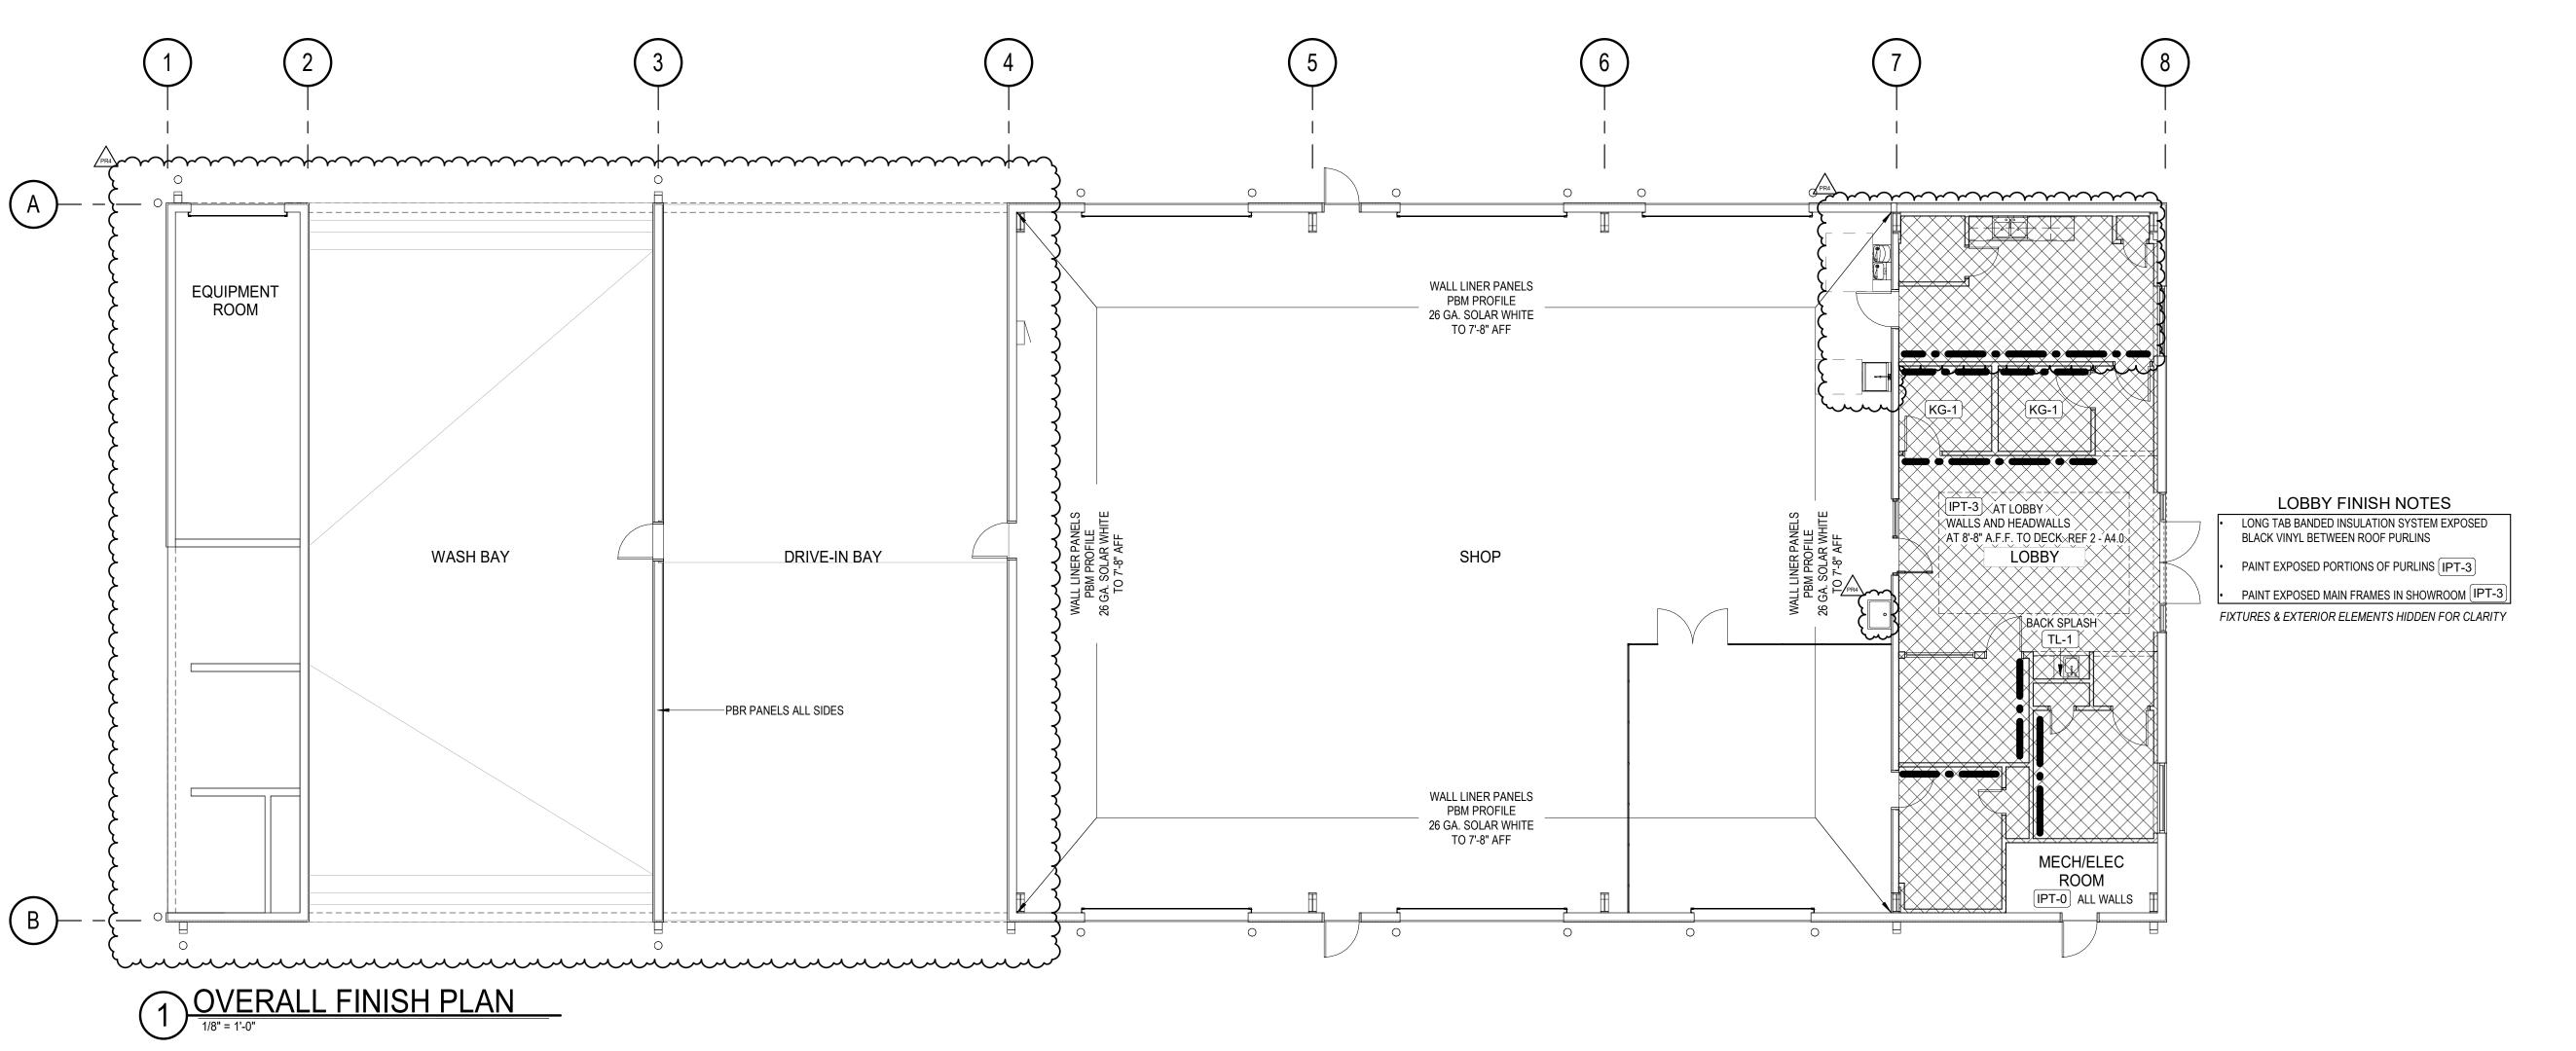


PR1 - ADDED ATTACHED WASHBAY.

PR2 - REMOVED ATTACHED WASHBAY.

PR3 - ADDED EXTERIOR CANOPY.

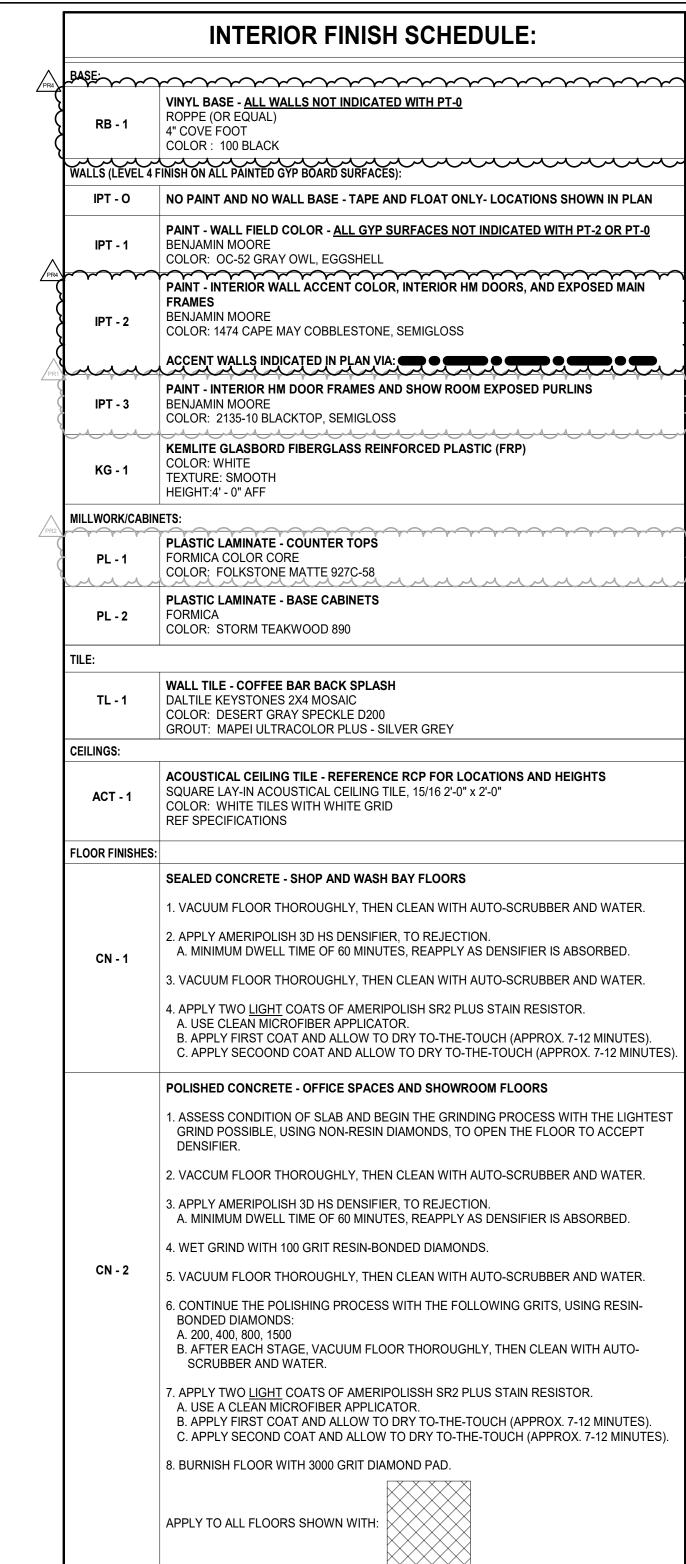

ALL ELECTRICAL DEVICES (SWITCHES, OUTLETS, FACEPLATES, ETC.) TO BE GRAY.

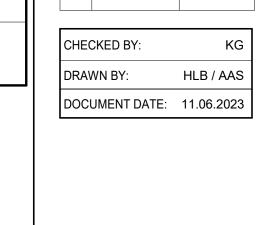

ISSUE BLOCK

10.13.2023 11.10.2023

12.01.2023 04.25.2024

+engineering

2809 Ajax Avenue Suite 100


Fax: 479.636.1209

Architect of Record

Scott Joseph Broadbent

Florida License No. AR 97891 Architect Business Lic No. AA26000940

Rogers Arkansas 72758 Phone: 479.636.3545

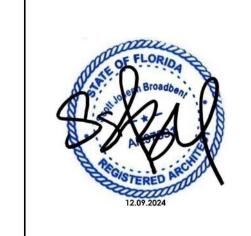




2 DOOR/FRAME COLOR DIAGRAM


SHEET:

—HOLLOW METAL FRAMES [IPT-3]

HOLLOW METAL DOORS IPT-3

SHEET: **A1.2**

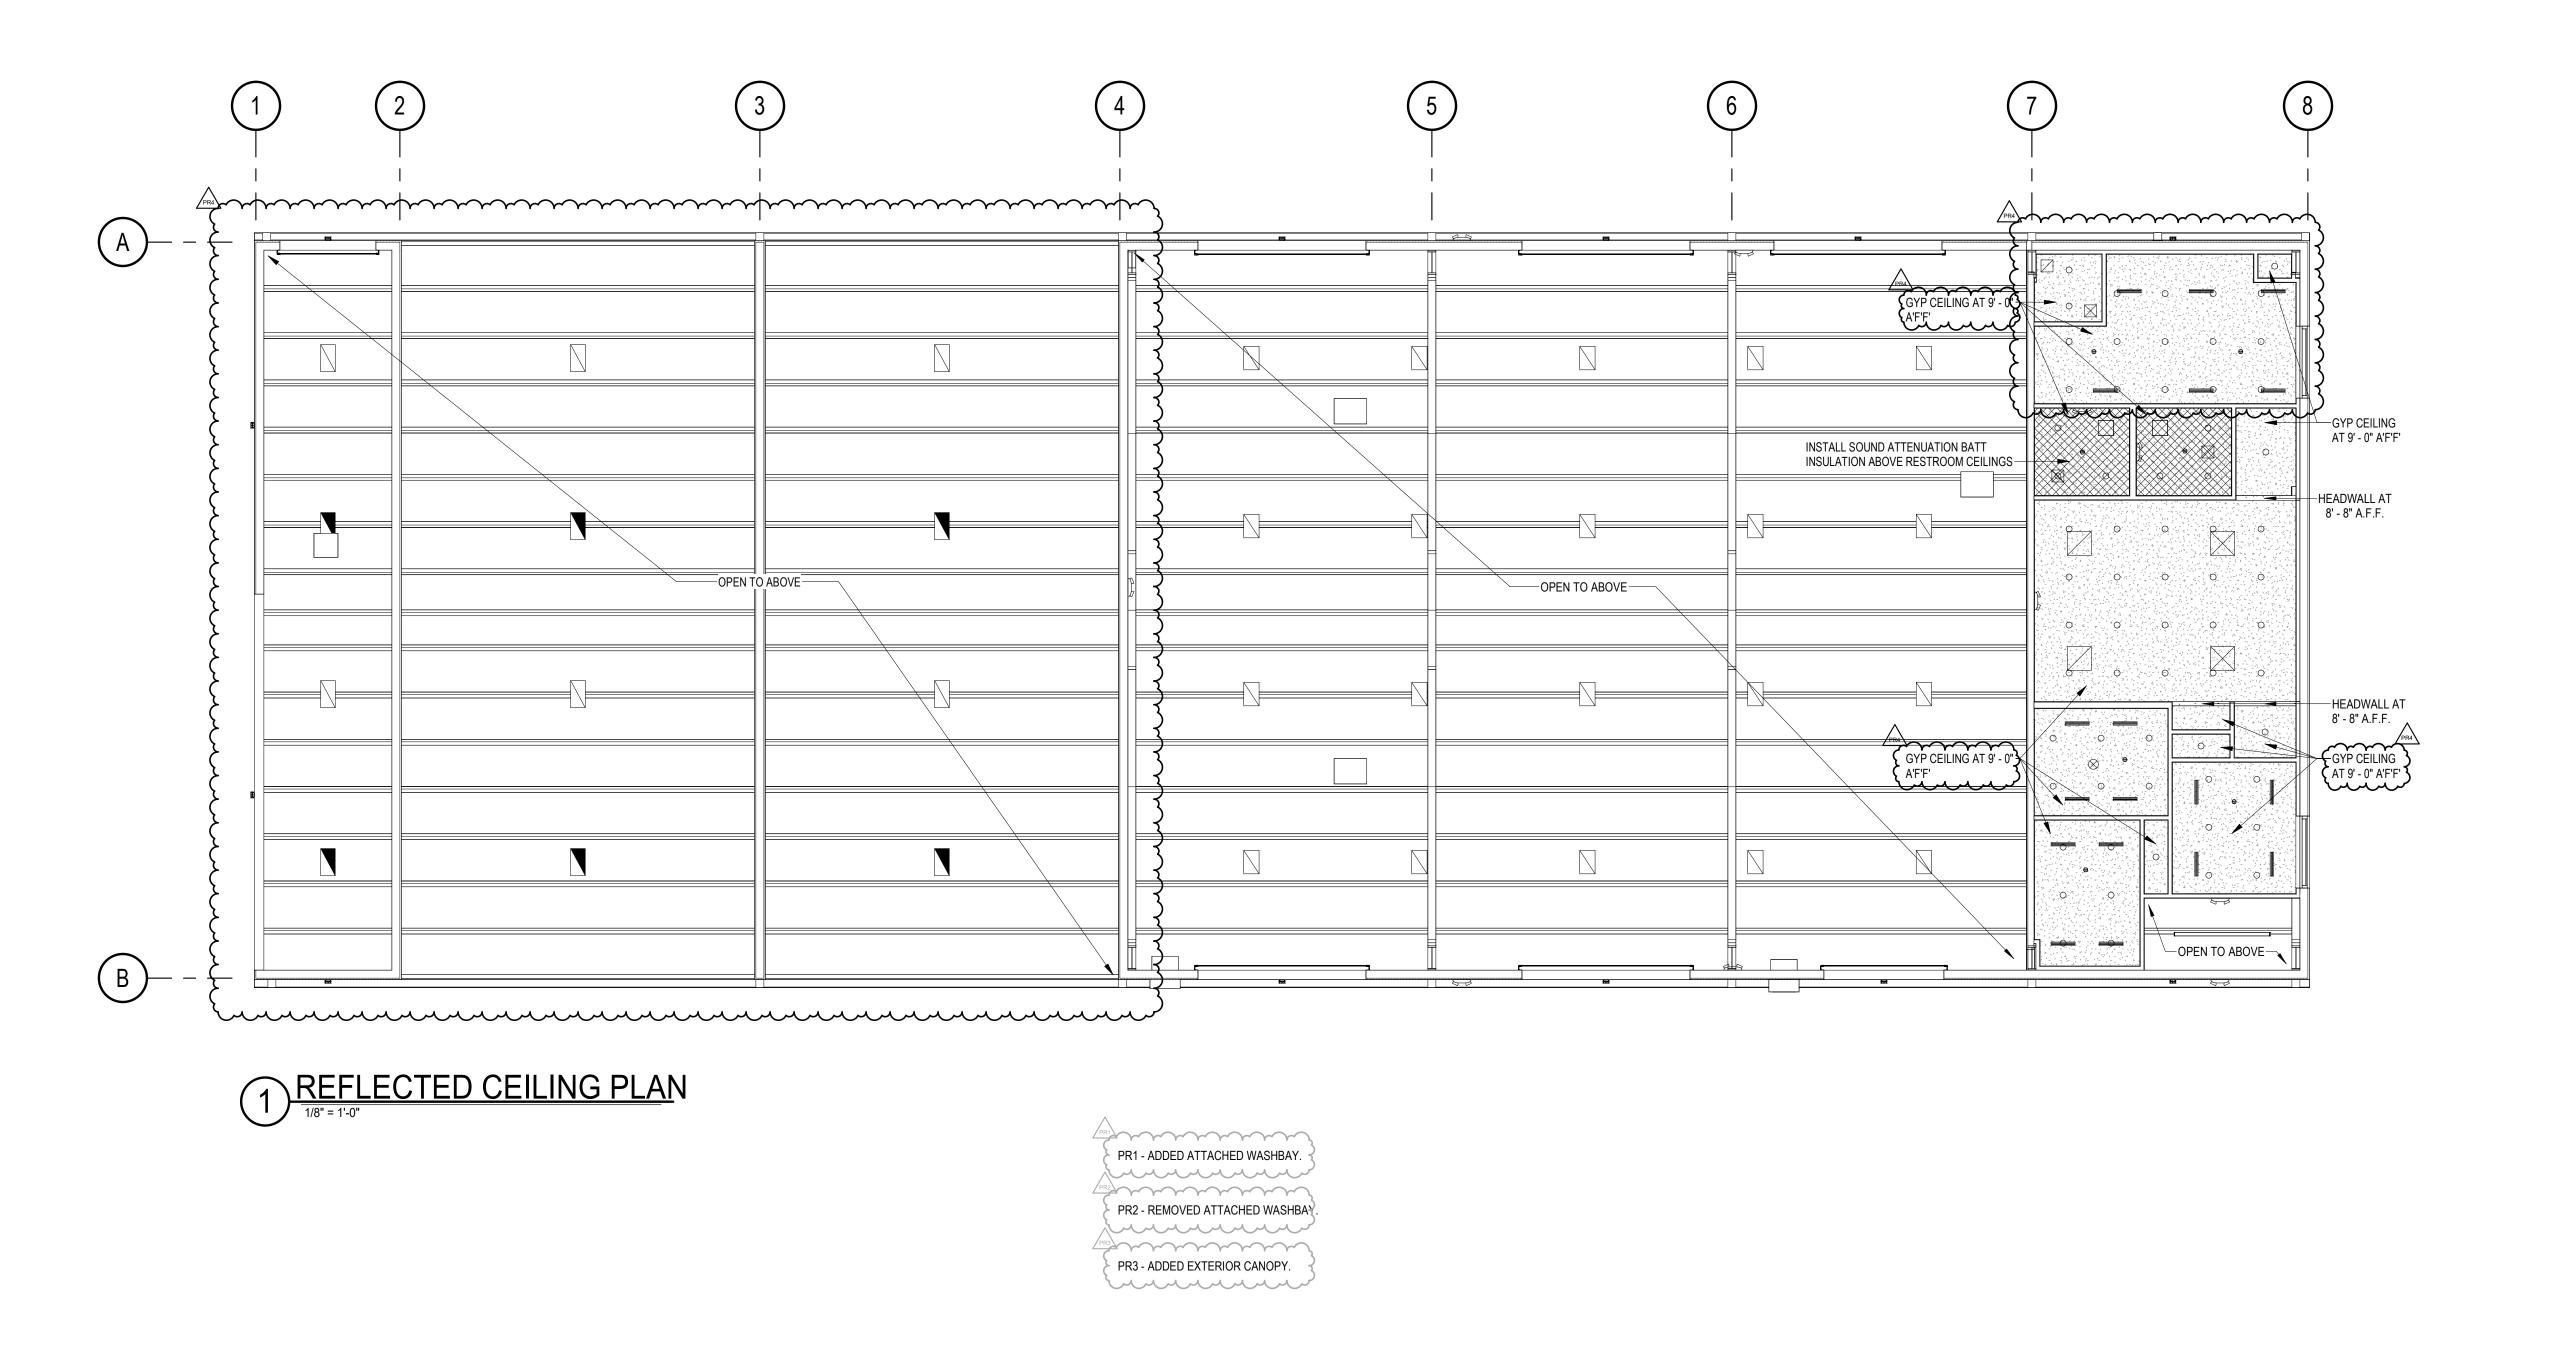

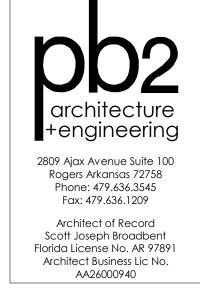

STIPULATION FOR REUSE

THIS DRAWING WAS PREPARED FOR USE ON A SPECIFIC SITE AT: LAKE CITY, FLORIDA

CONTEMPORANEOUSLY WITH ITS ISSUE DATE ON 11.06.2023 AND IT IS NOT SUITABLE FOR USE ON A DIFFERENT PROJECT SITE OR AT A LATER TIME. USE OF THIS DRAWING FOR REFERENCE OR EXAMPLE ON ANOTHER PROJECT REQUIRES THE SERVICES OF PROPERLY LICENSED ARCHITECTS AND ENGINEERS. REPRODUCTION OF THIS DRAWING FOR REUSE ON ANOTHER PROJECT IS NOT AUTHORIZED AND MAY BE CONTRARY TO THE LAW.


EQUIPMENTSHAKE - LAKE CITY, FL US-90 & PRICE CREEK ROAD LAKE CITY, FLORIDA

CHECKED BY: KG


DRAWN BY: HLB / AAS


DOCUMENT DATE: 11.06.2023



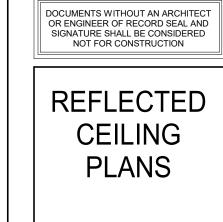

A1.3

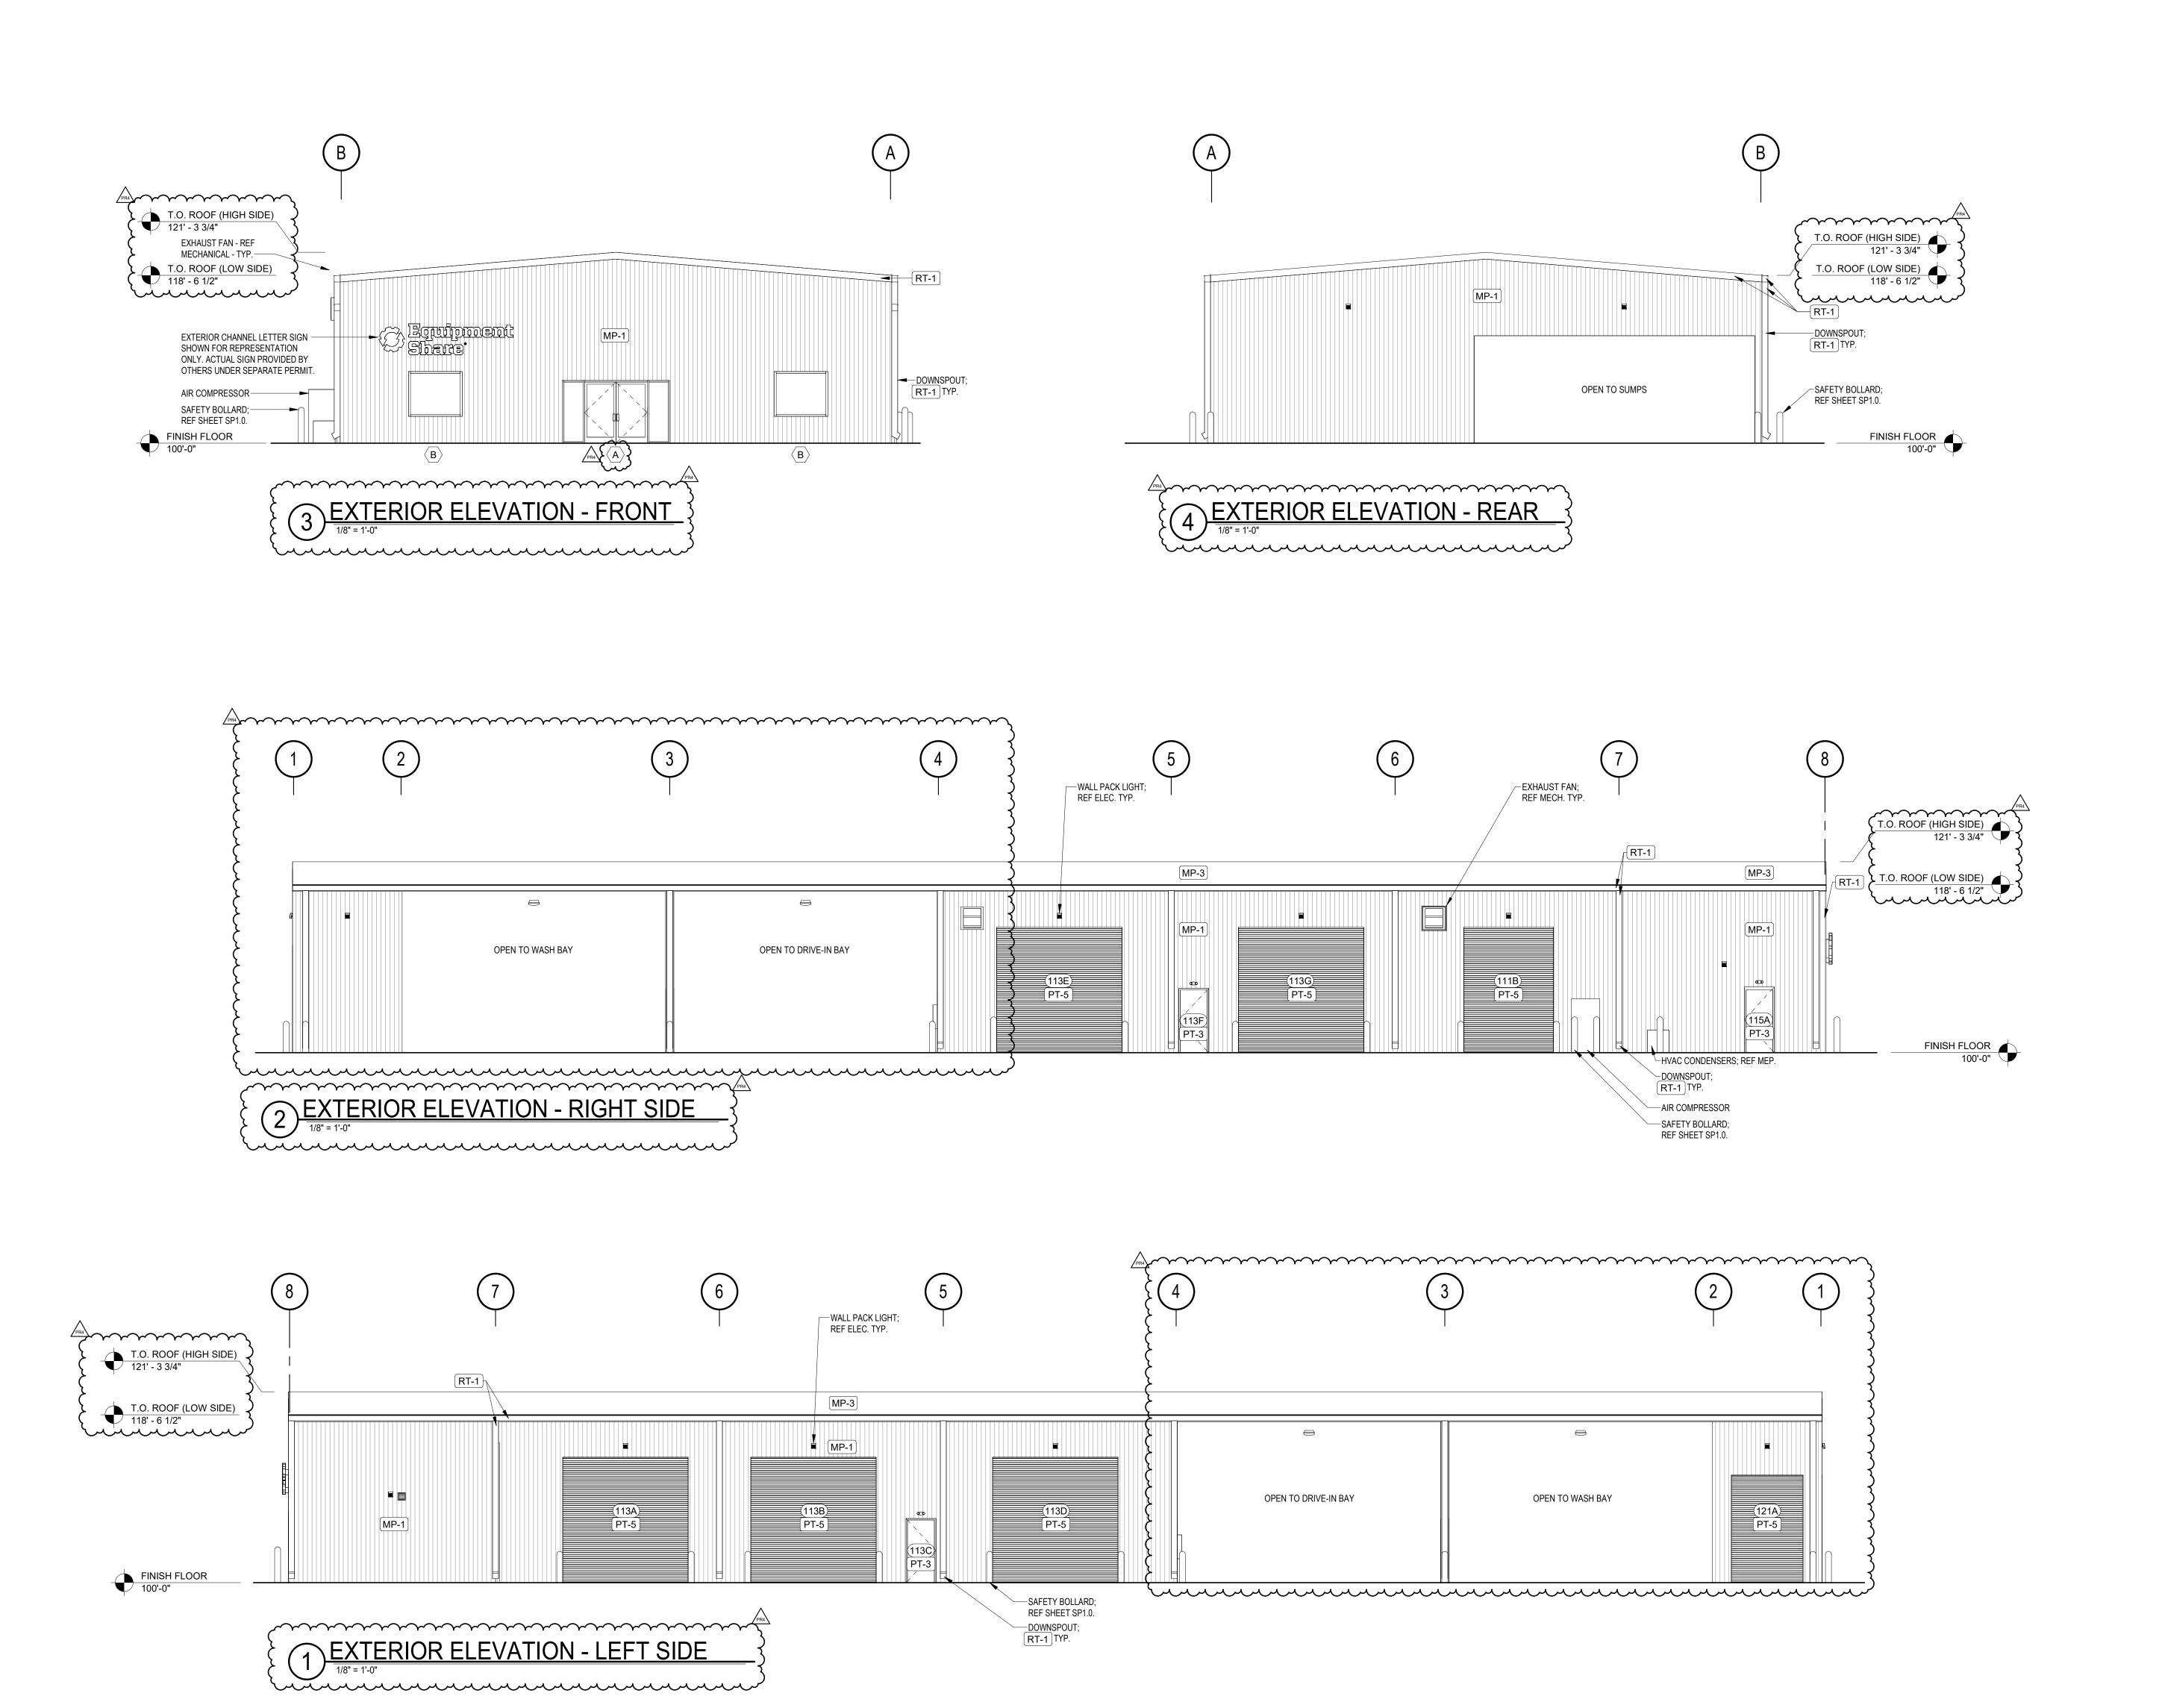

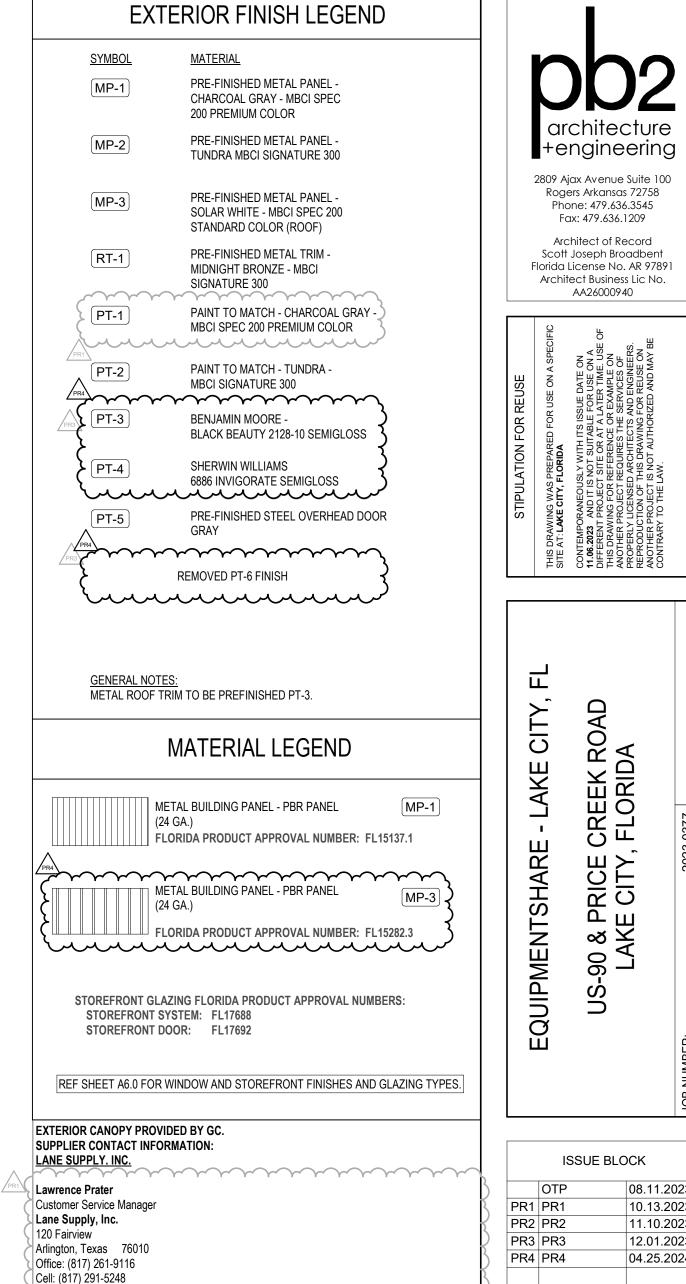

1. BUILDING ADDRESS SHALL BE POSTED ON THE BUILDING

AND VISIBLE TO THE PUBLIC ROADWAY.

ISSUE BLOCK 10.13.2023 11.10.2023 12.01.2023 04.25.2024 GENERAL NOTES: 2. ALL EXPOSED CONDUITS SHALL BE PAINTED TO MATCH ADJACENT

> CHECKED BY: HLB / AAS DRAWN BY: DOCUMENT DATE: 11.06.2023



DOCUMENTS WITHOUT AN ARCHITECT OR ENGINEER OF RECORD SEAL AND SIGNATURE SHALL BE CONSIDERED NOT FOR CONSTRUCTION **EXTERIOR** ELEVATIONS


PRI PR1 - ADDED ATTACHED WASHBAY. PRZ PR2 - REMOVED ATTACHED WASHBAY. , comment of PR3 PR3 - ADDED EXTERIOR CANOPY.

SHEET: A2.0

GENERAL ROOF PLAN NOTES

- REF MEP DRAWINGS FOR PENETRATION LOCATIONS; NOT ALL PENETRATIONS ARE SHOWN ON THIS PLAN. COORDINATE ALL PENTRATION FLASHING WITH PEMB PROVIDER TO ENSURE WARRANTY REQUIREMENTS ARE UPHELD.
- MECHANICAL INFORMATION SHOWN ON THIS DRAWING IS FOR GENERAL COORDINATION ONLY; REF MEP DRAWINGS.
- 3. REFER TO PEMB PACKAGE FOR ANY ROOF FLASHING AND WEATHERPROOFING DETAILS.
- 4. ROOF INSULATION PROVIDED BY THE PEMB PROVIDER, AND INTENDED TO COMPLY WITH ALL APPLICABLE
- ENERGY CODE REQUIREMENTS FOR CONDITIONED PORTIONS OF BUILDING.5. ROOF PANEL COLOR TO COMPLY WITH ENERGY CODE REQUIREMENTS FOR LOW SLOPED ROOFING.



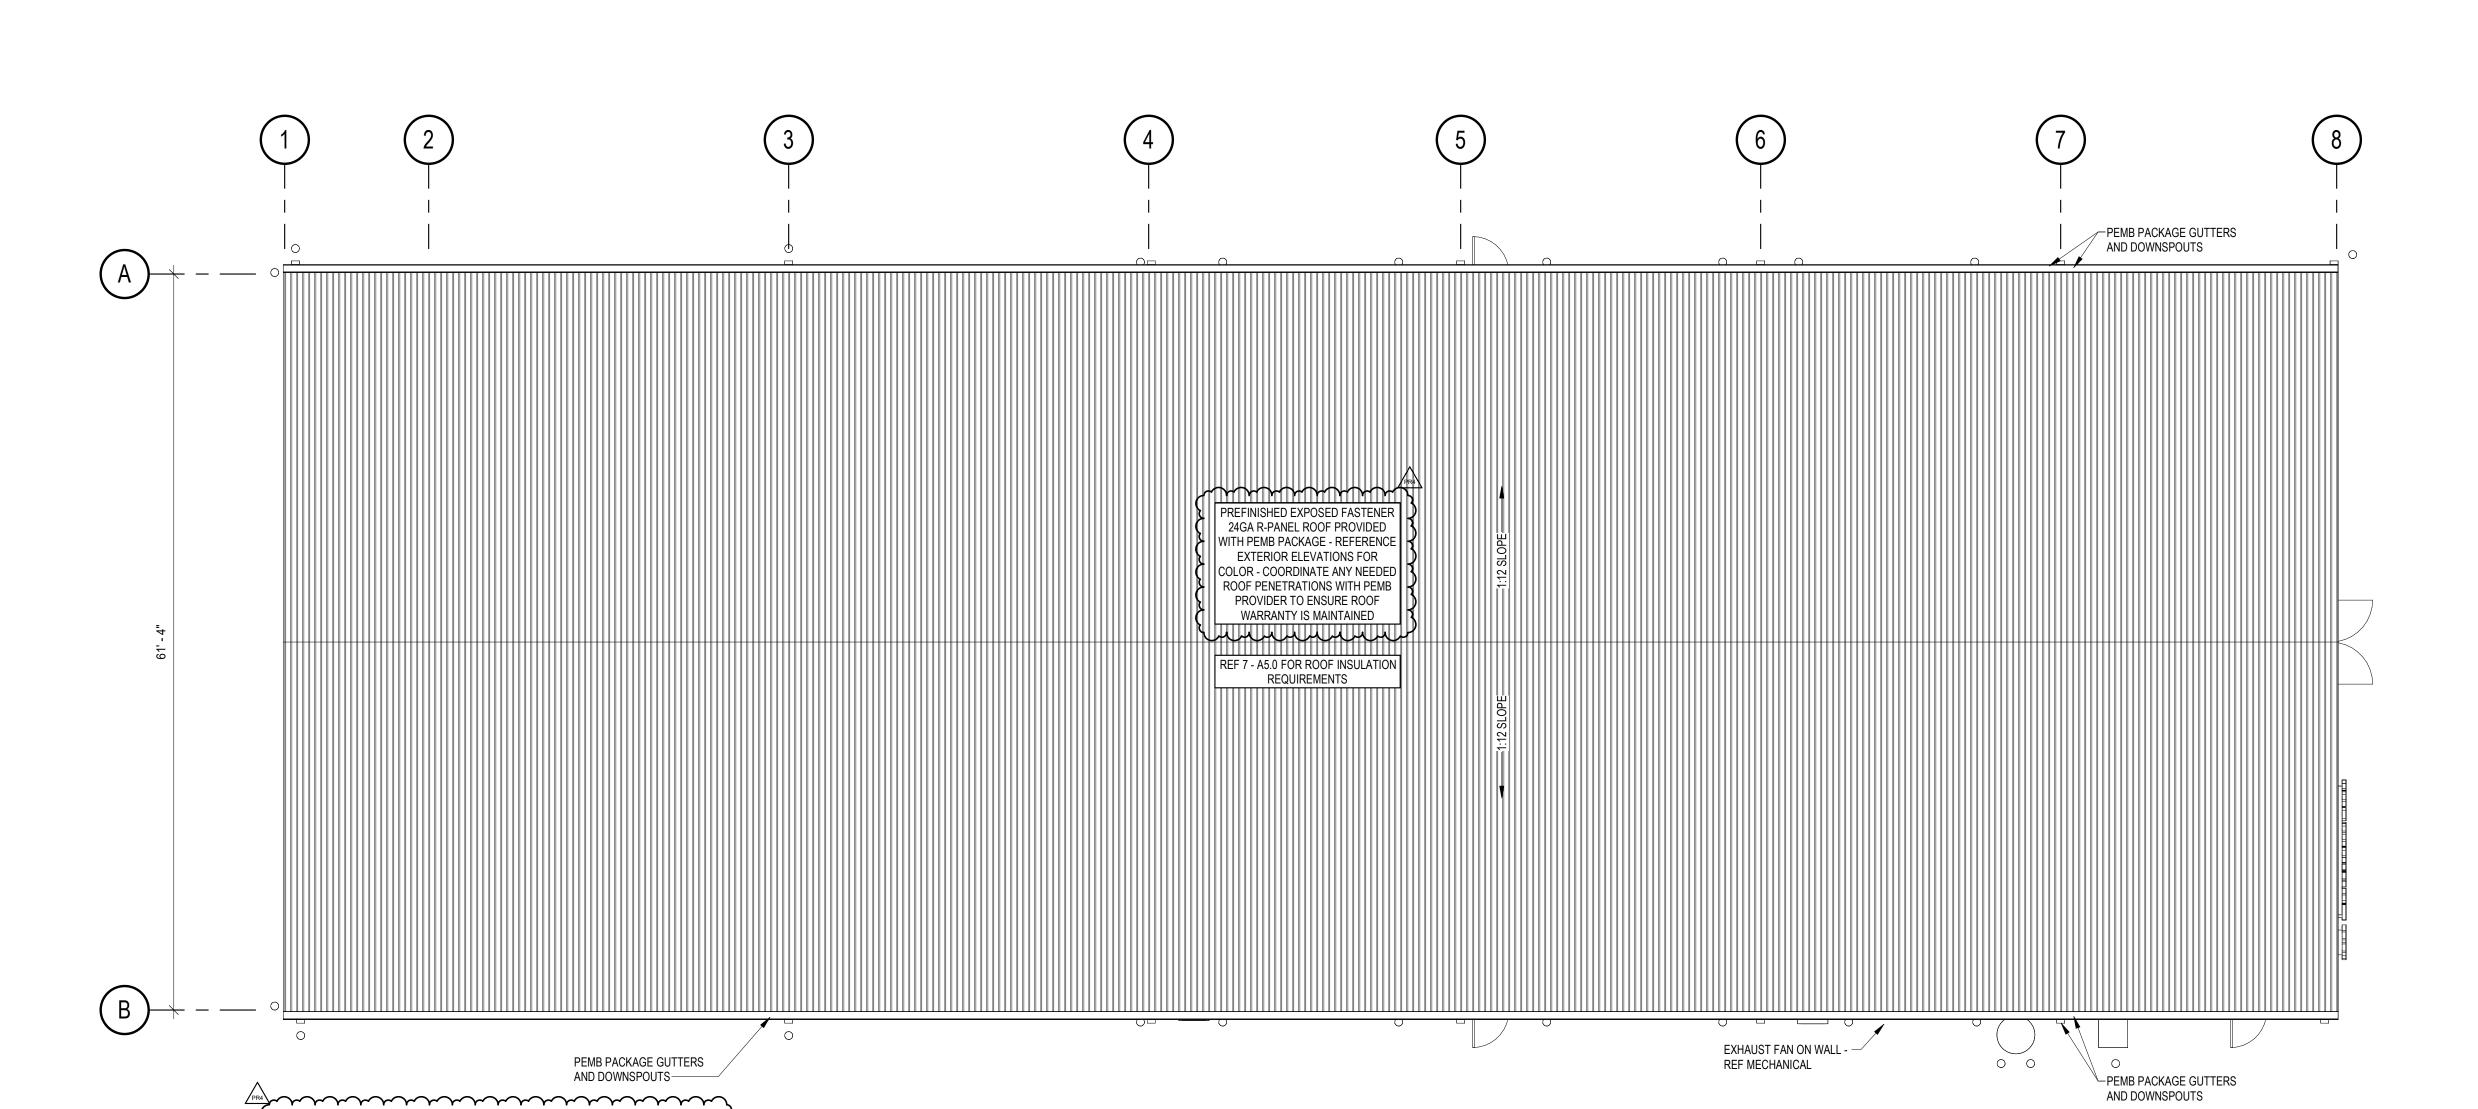

STIPULATION FOR REUSE

THIS DRAWING WAS PREPARED FOR USE ON A SPINTE AT: LAKE CITY, FLORIDA

CONTEMPORANEOUSLY WITH ITS ISSUE DATE ON 11.06.2023 AND IT IS NOT SUITABLE FOR USE ON A DIFFERENT PROJECT SITE OR AT A LATER TIME. US THIS DRAWING FOR REFERENCE OF EXAMPLE ON ANOTHER PROJECT REQUIRES THE SERVICES OF PROPERLY LICENSED ARCHITECTS AND ENGINEER REPRODUCTION OF THIS DRAWING FOR REUSE ON ANOTHER PROJECT IS NOT AUTHORIZED AND MAY CONTRARY TO THE LAW.

CHECKED BY: KG
DRAWN BY: HLB / AAS
DOCUMENT DATE: 11.06.2023



DOCUMENTS WITHOUT AN ARCHITECT OR ENGINEER OF RECORD SEAL AND SIGNATURE SHALL BE CONSIDERED NOT FOR CONSTRUCTION

ROOF PLAN


HEET:

1/8" = 1'-0" PLANS REVISED EXTENSIVELY; REVIEW THUROUGHLY

PR1 - ADDED ATTACHED WASHBAY.

PR2 - REMOVED ATTACHED WASHBAY.

PR3 - ADDED EXTERIOR CANOPY.

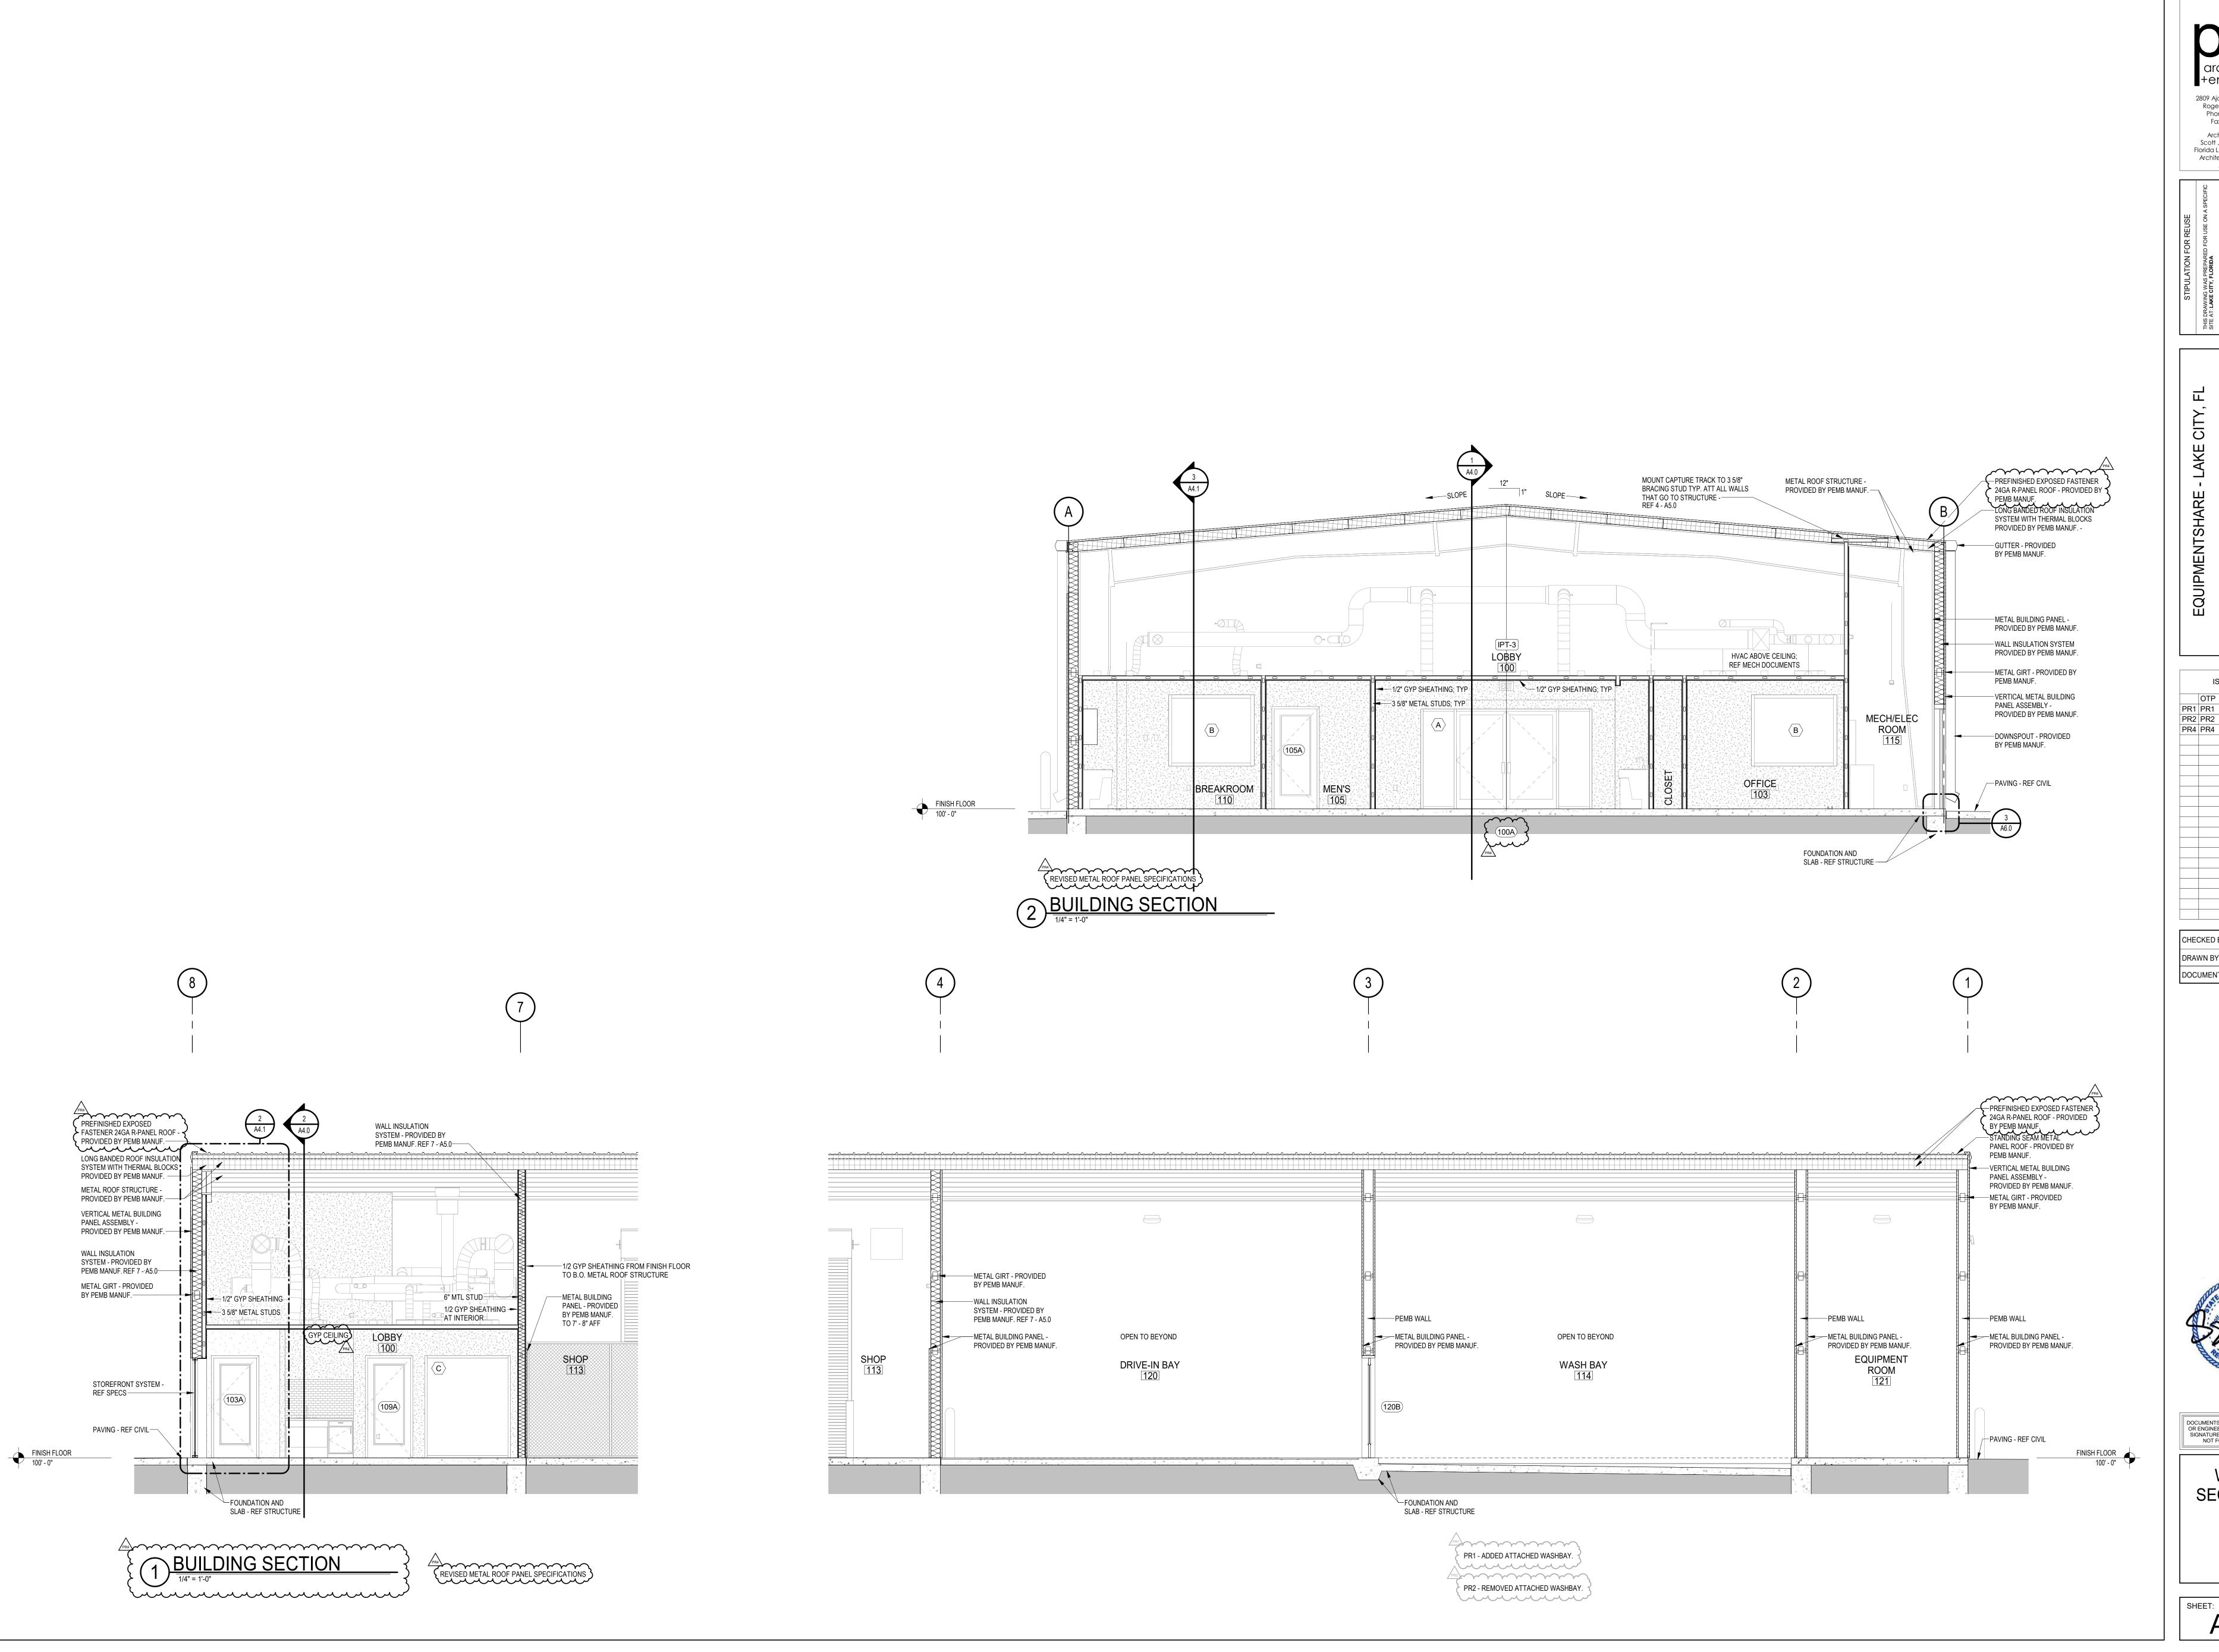



THIS DRAWING WAS PREPARED FOR USE ON A SPECIFIC SITE AT: LAKE CITY, FLORIDA

CONTEMPORANEOUSLY WITH ITS ISSUE DATE ON 11.06.2023 AND IT IS NOT SUITE OR A LATER TIME. USE OF DIFFERENT PROJECT SITE OR ALA LATER TIME. USE OF THIS DRAWING FOR REFERENCE OR EXAMPLE ON ANOTHER PROJECT REQUIRES THE SERVICES OF PROPERLY LICENSED ARCHITECTS AND ENGINEERS. PROPERLY LOCENSED ARCHITECTS AND ENGINEERS. REPRODUCTION OF THIS DRAWING FOR REUSE ON ANOTHER PROJECT IS NOT AUTHORIZED AND MAY BE CONTRARY TO THE LAW.

US-90 & PRICE CREEK ROAD
LAKE CITY, FLORIDA

| SSUE BLOCK | OTP | 08.11.2023 | PR1 | PR1 | 10.13.2023 | PR2 | PR2 | 11.10.2023 | PR4 | PR4 | 04.25.2024 |

CHECKED BY: KG

DRAWN BY: HLB / AAS

DOCUMENT DATE: 11.06.2023



DOCUMENTS WITHOUT AN ARCHITECT
OR ENGINEER OF RECORD SEAL AND
SIGNATURE SHALL BE CONSIDERED
NOT FOR CONSTRUCTION


WALL

WALL SECTIONS

SHEET: **A4.0**

PR1 - ADDED ENLARGED WASHBAY DETAILS

PR2 - REMOVED ENLARGED WASHBAY DETAILS

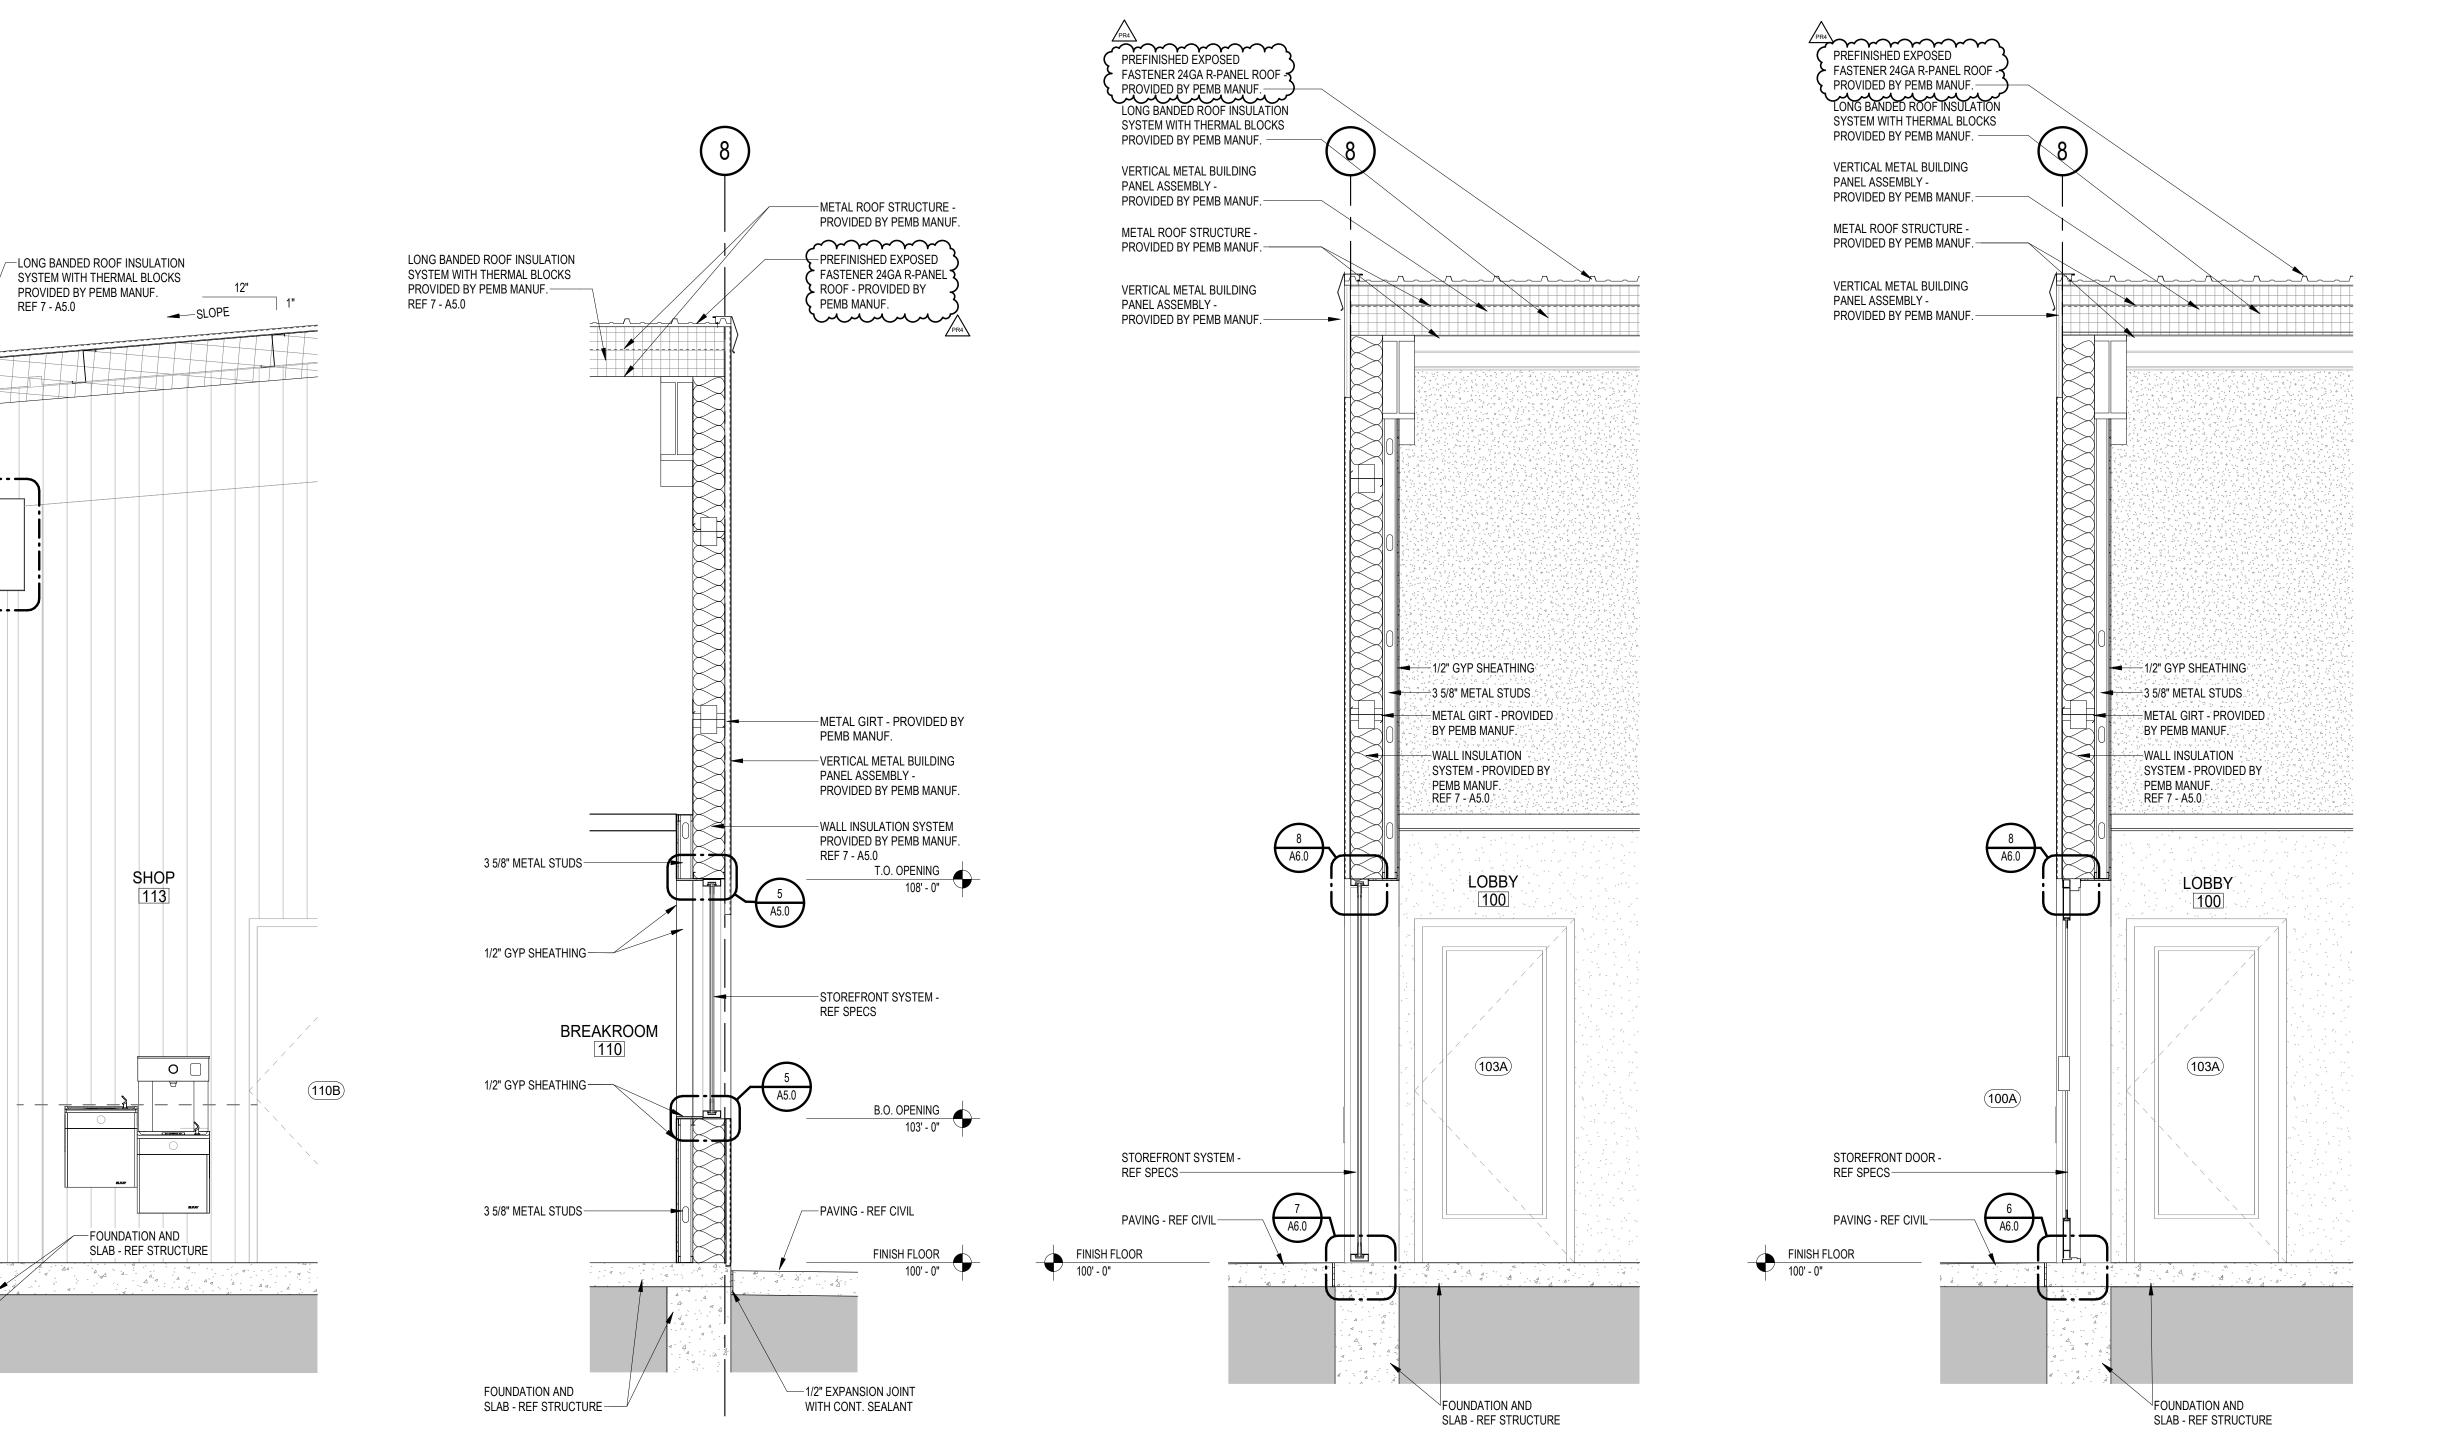

architecture
+engineering

2809 Ajax Avenue Suite 100
Rogers Arkansas 72758
Phone: 479.636.3545
Fax: 479.636.1209

Architect of Record
Scott Joseph Broadbent
Florida License No. AR 97891
Architect Business Lic No.
AA26000940

THIS DRAWING WAS PREPARED FOR USE ON A SPECIFIC SITE AT: LAKE CITY, FLORIDA

CONTEMPORANEOUSLY WITH ITS ISSUE DATE ON 41.06.2023 AND IT IS NOT SUITABLE FOR USE ON A DIFFERENT PROJECT SITE OR AT A LATER TIME. USE OF THIS DRAWING FOR REFERENCE OR EXAMPLE ON ANOTHER PROJECT REQUIRES THE SERVICES OF PROPERLY LICENSED ARCHITECTS AND ENGINEERS. REPRODUCTION OF THIS DRAWING FOR REUSE ON ANOTHER PROJECT IS NOT AUTHORIZED AND MAY BE CONTRARY TO THE LAW.

EQUIPMENTSHARE - LAKE CITY, FL US-90 & PRICE CREEK ROAD LAKE CITY, FLORIDA



DOCUMENTS WITHOUT AN ARCHITECT
OR ENGINEER OF RECORD SEAL AND
SIGNATURE SHALL BE CONSIDERED
NOT FOR CONSTRUCTION

WALL
SECTIONS

A4.1

REMOVED DETAIL 5 FROM SET.

PREFINISHED EXPOSED

FASTENER R-PANEL ROOF -

PROVIDED BY PEMB MANUF.

METAL ROOF STRUCTURE -PROVIDED BY PEMB MANUF. —

VERTICAL METAL BUILDING PANEL ASSEMBLY -

PROVIDED BY PEMB MANUF. —

METAL GIRT - PROVIDED BY PEMB MANUF.

WALL INSULATION SYSTEM -PROVIDED BY PEMB MANUF.— REF 7 - A5.0

OVERHEAD COILING

1/2" EXPANSION JOINT WITH CONT. SEALANT—

PAVING - REF CIVIL-

DOOR - REF A6.0-

SECTION AT OVERHEAD DOOR

3 SECTION AT WINDOW AND FURRING


1/2" = 1'-0"

BUILDING SECTION AT STOREFRONT

1/2" = 1'-0"

SECTION AT STOREFRONT DOOR

1/2" = 1'-0"

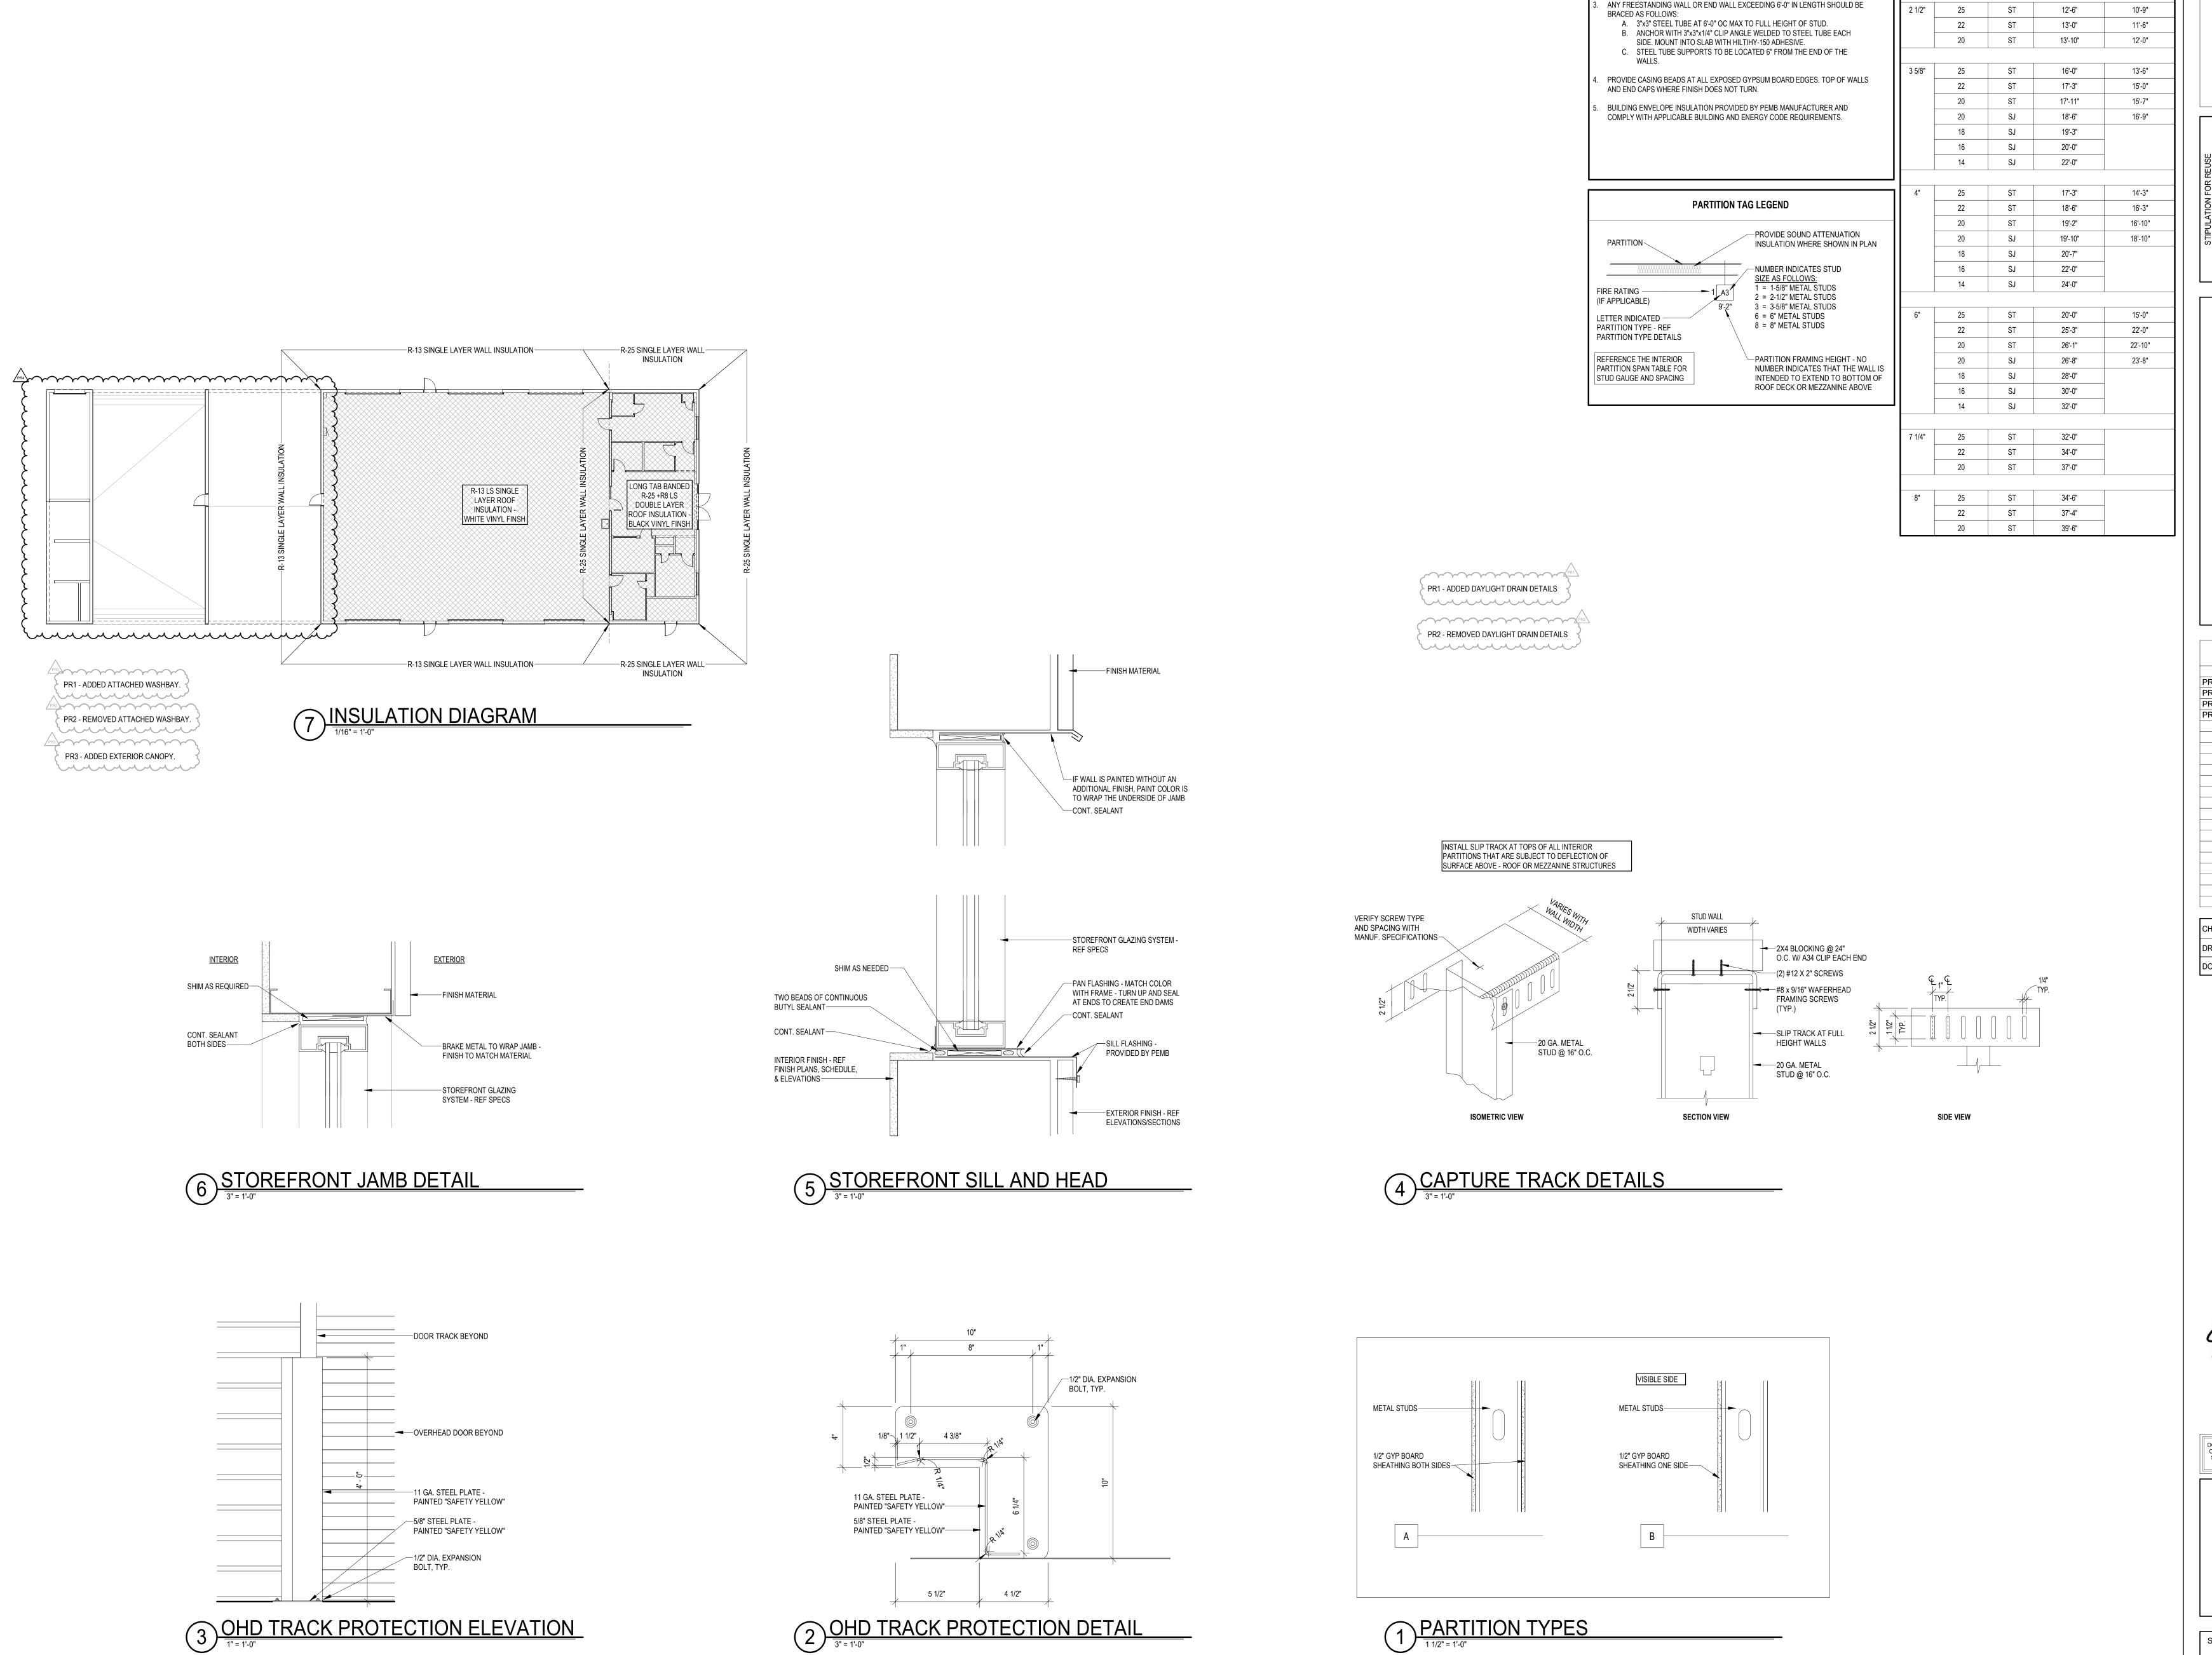

architecture
+engineering

2809 Ajax Avenue Suite 100
Rogers Arkansas 72758
Phone: 479.636.3545
Fax: 479.636.1209

Architect of Record
Scott Joseph Broadbent
Florida License No. AR 97891
Architect Business Lic No.

METAL STUD HEIGHT/GAUGE TABLE

TYPE

SIZE

GAUGE

1 5/8" 25 ST

MAX UNSUPPORTED HIEGHT

24" OC

8'-3"

16" OC

9'-6"

GENERAL NOTES

REFER TO INTERIOR FINISH PLANS FOR LOCATION OF WAINSCOT AND ALL

REFER TO STRUCTURAL FOR LOAD BEARING PARTITIONS.

INTERIOR FINISHES.

LEGITY, FLORIDA

TO WAS PREPARED FOR USE ON A SPECIFIC

ECITY, FLORIDA

ECITY, FLORIDA

ECITY, FLORIDA

ECITY, FLORIDA

ALCHIFECT OR USE ON A SPECIFIC

AND IT IS NOT SUITABLE FOR USE ON A

NO IT IS NOT SUITABLE FOR USE ON A

NO IT IS NOT SUITABLE FOR USE ON A

WOLL OF REFERENCE OR EXAMPLE ON

GEORGE PREVIOURES OF

CENSED AND ENGINEERS.

ON OF THIS DRAWING FOR REUSE ON

OUTEL IS NOT AUTHORIZED AND MAY BE

OTHE LAW.

EQUIPMENTSHARE - LAKE CITY, FL US-90 & PRICE CREEK ROAD LAKE CITY, FLORIDA

CHECKED BY: SJB

DRAWN BY: HLB

DOCUMENT DATE: 11.06.2023




DOCUMENTS WITHOUT AN ARCHITECT
OR ENGINEER OF RECORD SEAL AND
SIGNATURE SHALL BE CONSIDERED
NOT FOR CONSTRUCTION

DETAILS

A5.0

. MILLWORK MANUFACTURER TO FIELD VERIFY ALL DIMENSIONS PRIOR TO SUBMITTING SHOP DRAWINGS FOR REVIEW. 2. ALL MILLWORK SHOP DRAWINGS TO BE SUBMITTED TO EQUIPMENTSHARE REPRESENTATIVE FOR REVIEW AND APPROVAL. 3. ALL CABINET SUBSTRATE TO BE 3/4" A/C PLYWOOD UNLESS NOTED OTHERWISE. 4. ALL PLYWOOD SUBSTRATE TO BE COVERED WITH LAMINATE AT INDICATED IN MILLWORK DETAILS. INSTALL LAMINATE PER MANUFACTURERS RECOMMENDATIONS. 5. ALL DRAWERS TO BE CONSTRUCTED OF MELAMINE OR SOLID WOOD FULL HEIGHT. WOOD TO BE BIRCH, OR APPROVED EQUAL. FACE OF DRAWERS TO BE LAMINATED PER DRAWINGS. 6. ALL DRAWERS TO HAVE FULL EXTENSION DRAWER GLIDES, 75# MINMUM. 7. ALL DRAWER TO BE A MINIMUM OF 20" DEEP. 8. ALL SHELVES TO BE CONSTRUCTED OF 3/4" A/C PLYWOOD ON ALL SURFACES. 9. ALL ADJUSTABLE CABINET SHELVES TO BE MOUNTED 5MM BORING SYSTEM (NO METAL STANDARDS ALLOWED) . O. PROVIDE 2" GROMMET AND COVÉR AT ALL LOCATIONS INDICATED ON DRAWINGS. COLOR TO MATCH WITH PL SURFACE SURRONDING. 1. METAL SUPPORT BRACKETS AT COUNTERTOPS TO BE WOODWORKEREXPRESS.COM SKU# 10730729, WHITE OR APPROVED EQUAL. 2. WHERE DOORS OR DRAWERS SIT ADJACENT TO A SIDE WALL, PROVIDE 2" FILLER TO MATCH CABINET FINISHES BETWEEN DOORS OR DRAWERS AND SIDE WALL.

MILLWORK SHEET NOTES: INTERIOR FINISH SCHEDULE: 4" COVE FOOT BENJAMIN MOORE BENJAMIN MOORE IPT - 2 IPT - 3 BENJAMIN MOORE

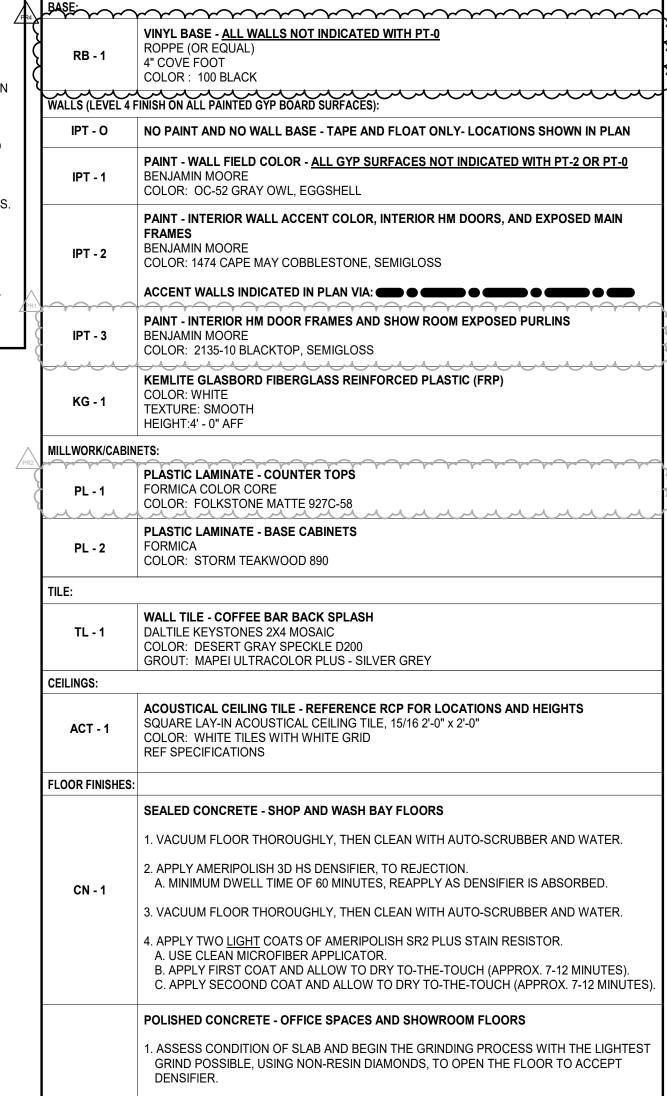

2. VACCUM FLOOR THOROUGHLY, THEN CLEAN WITH AUTO-SCRUBBER AND WATER.

A. MINIMUM DWELL TIME OF 60 MINUTES, REAPPLY AS DENSIFIER IS ABSORBED.

5. VACUUM FLOOR THOROUGHLY, THEN CLEAN WITH AUTO-SCRUBBER AND WATER.

6. CONTINUE THE POLISHING PROCESS WITH THE FOLLOWING GRITS, USING RESIN-

B. AFTER EACH STAGE, VACUUM FLOOR THOROUGHLY, THEN CLEAN WITH AUTO-

B. APPLY FIRST COAT AND ALLOW TO DRY TO-THE-TOUCH (APPROX. 7-12 MINUTES).

7. APPLY TWO <u>LIGHT</u> COATS OF AMERIPOLISSH SR2 PLUS STAIN RESISTOR.

ALL ELECTRICAL DEVICES (SWITCHES, OUTLETS, FACEPLATES, ETC.) TO BE GRAY.

3. APPLY AMERIPOLISH 3D HS DENSIFIER, TO REJECTION.

4. WET GRIND WITH 100 GRIT RESIN-BONDED DIAMONDS.

BONDED DIAMONDS:


A. 200, 400, 800, 1500

SCRUBBER AND WATER.

APPLY TO ALL FLOORS SHOWN WITH

A. USE A CLEAN MICROFIBER APPLICATOR.

8. BURNISH FLOOR WITH 3000 GRIT DIAMOND PAD.

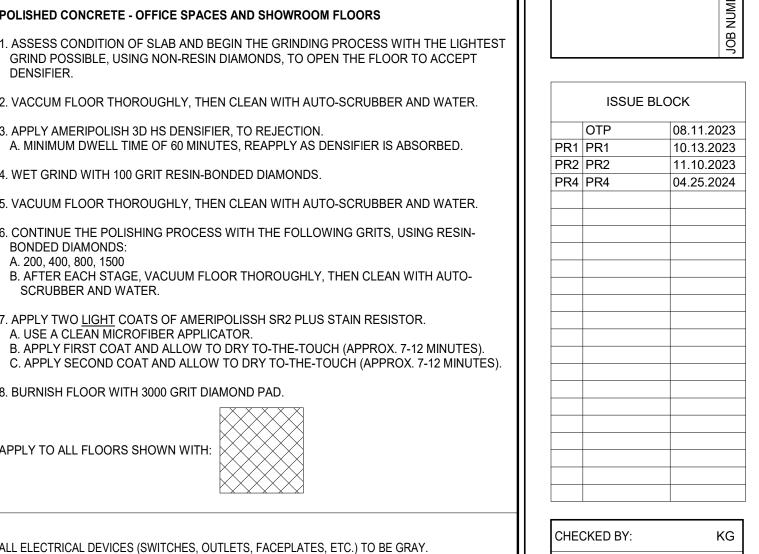

90

+engineering

2809 Ajax Avenue Suite 100

Rogers Arkansas 72758

Phone: 479.636.3545

Fax: 479.636.1209

Architect of Record


Scott Joseph Broadbent


Florida License No. AR 97891

Architect Business Lic No.

AA26000940

HLB / AAS DRAWN BY: DOCUMENT DATE: 11.06.2023

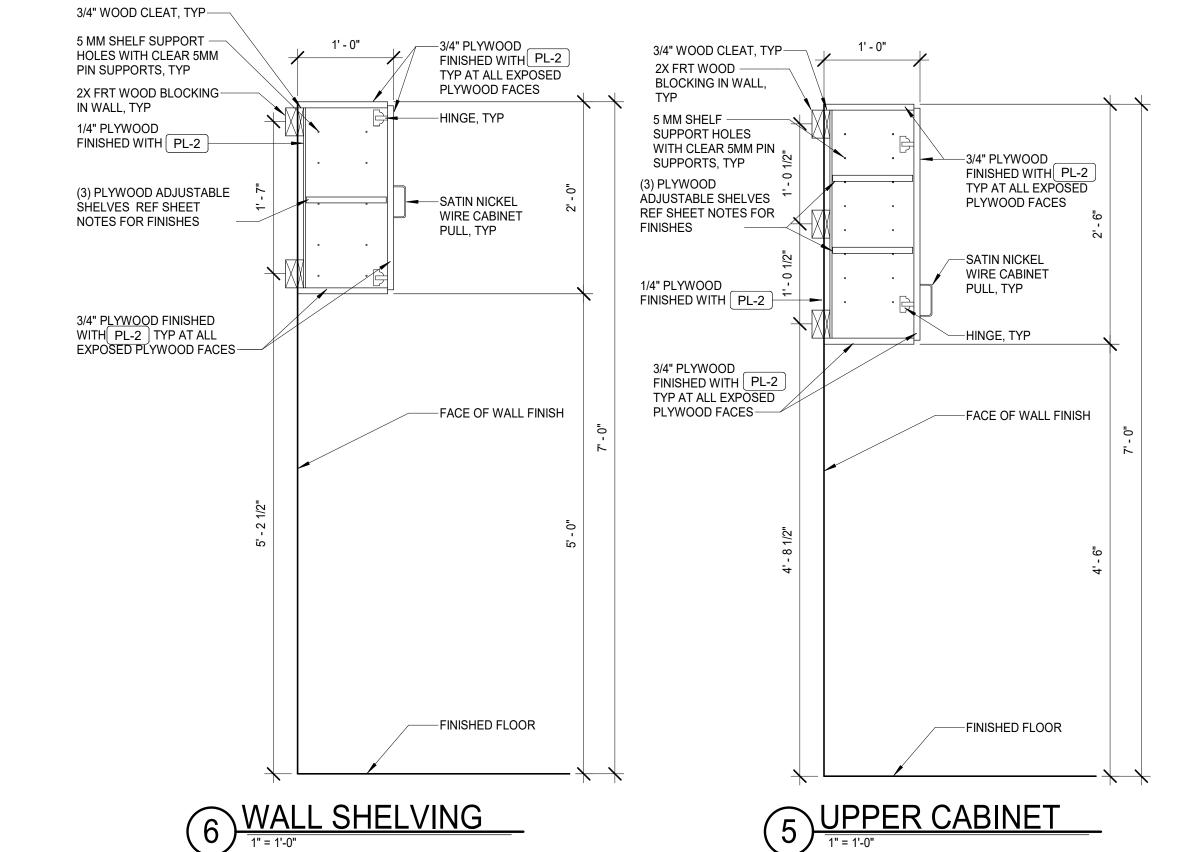

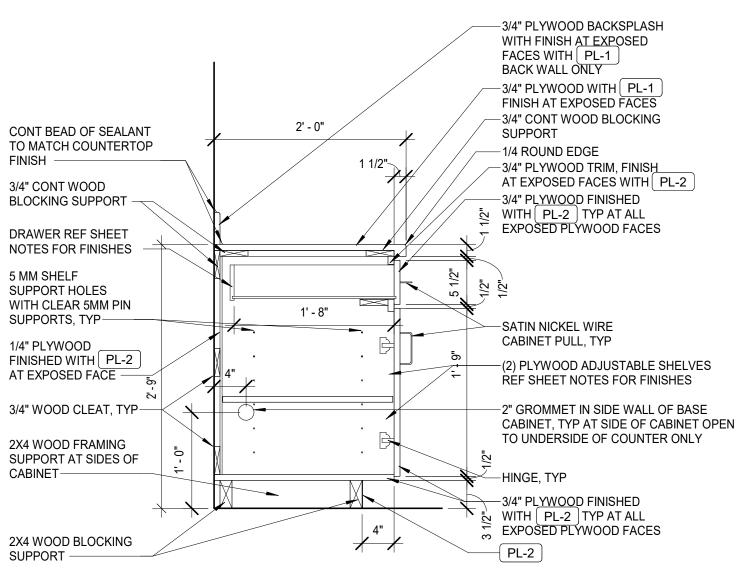

CLEARANCE `

7" 6" MAX 11" MIN

4 SINK BASE CABINET

SINK AND FAUCET - REF MEP -

CONT BEAD OF SEALANT TO

3/4" CONT WOOD

2X4" CONT WOOD

REF MEP—

1/4" PLYWOOD

BLOCKING SUPPORT

DISPOSAL AND PLUMBING,

FINISHED WITH PL-2

AT EXPOSED FACE -

BLOCKING SUPPORT

ADA PIPE INSULATION-

3/4" CONT WOOD

2X4" CONT WOOD

BLOCKING SUPPORT-

BLOCKING SUPPORT

MATCH COUNTERTOP FINISH -

-3/4" PLYWOOD BACKSPLASH

WITH FINISH AT EXPOSED

—3/4" PLYWOOD WITH∫ PL-1

FINISH AT EXPOSED FACES

—3/4" CONT WOOD BLOCKING

FACES WITH PL-1

BACK WALL ONLY

SUPPORT

—1/4 ROUND EDGE

 \pm 3/4" PLYWOOD \equiv

AT EXPOSED FACE


FINISHED WITH PL-2


—3/4" PLYWOOD FINISHED

WITH | PL-2 | TYP AT ALL

EXPOSED PLYWOOD FACES

3 DOOR AND DRAWER BASE CABINET

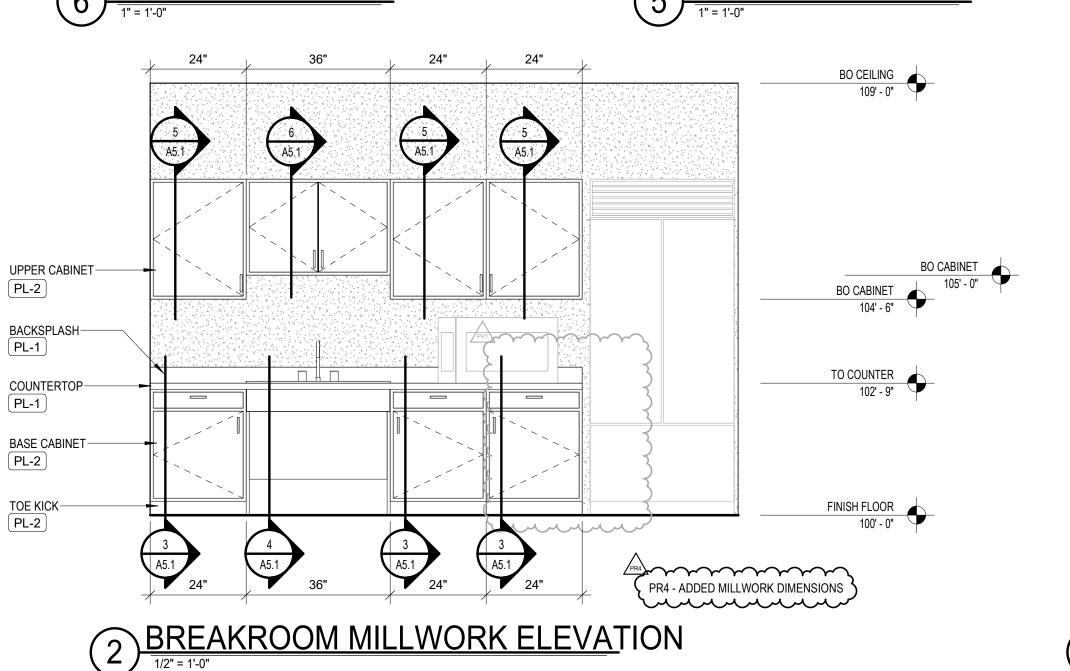

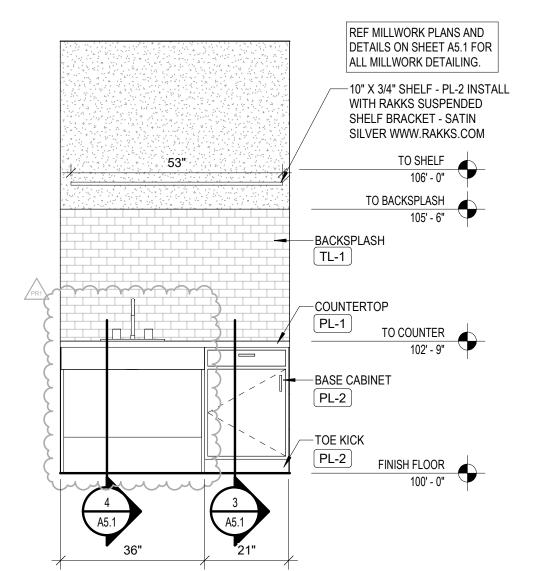


1 COFFEE BAR MILLWORK ELEVATION



DOCUMENTS WITHOUT AN ARCHITECT SIGNATURE SHALL BE CONSIDERED NOT FOR CONSTRUCTION INTERIOR DETAILS AND ELEVATIONS

SHEET: A5.1

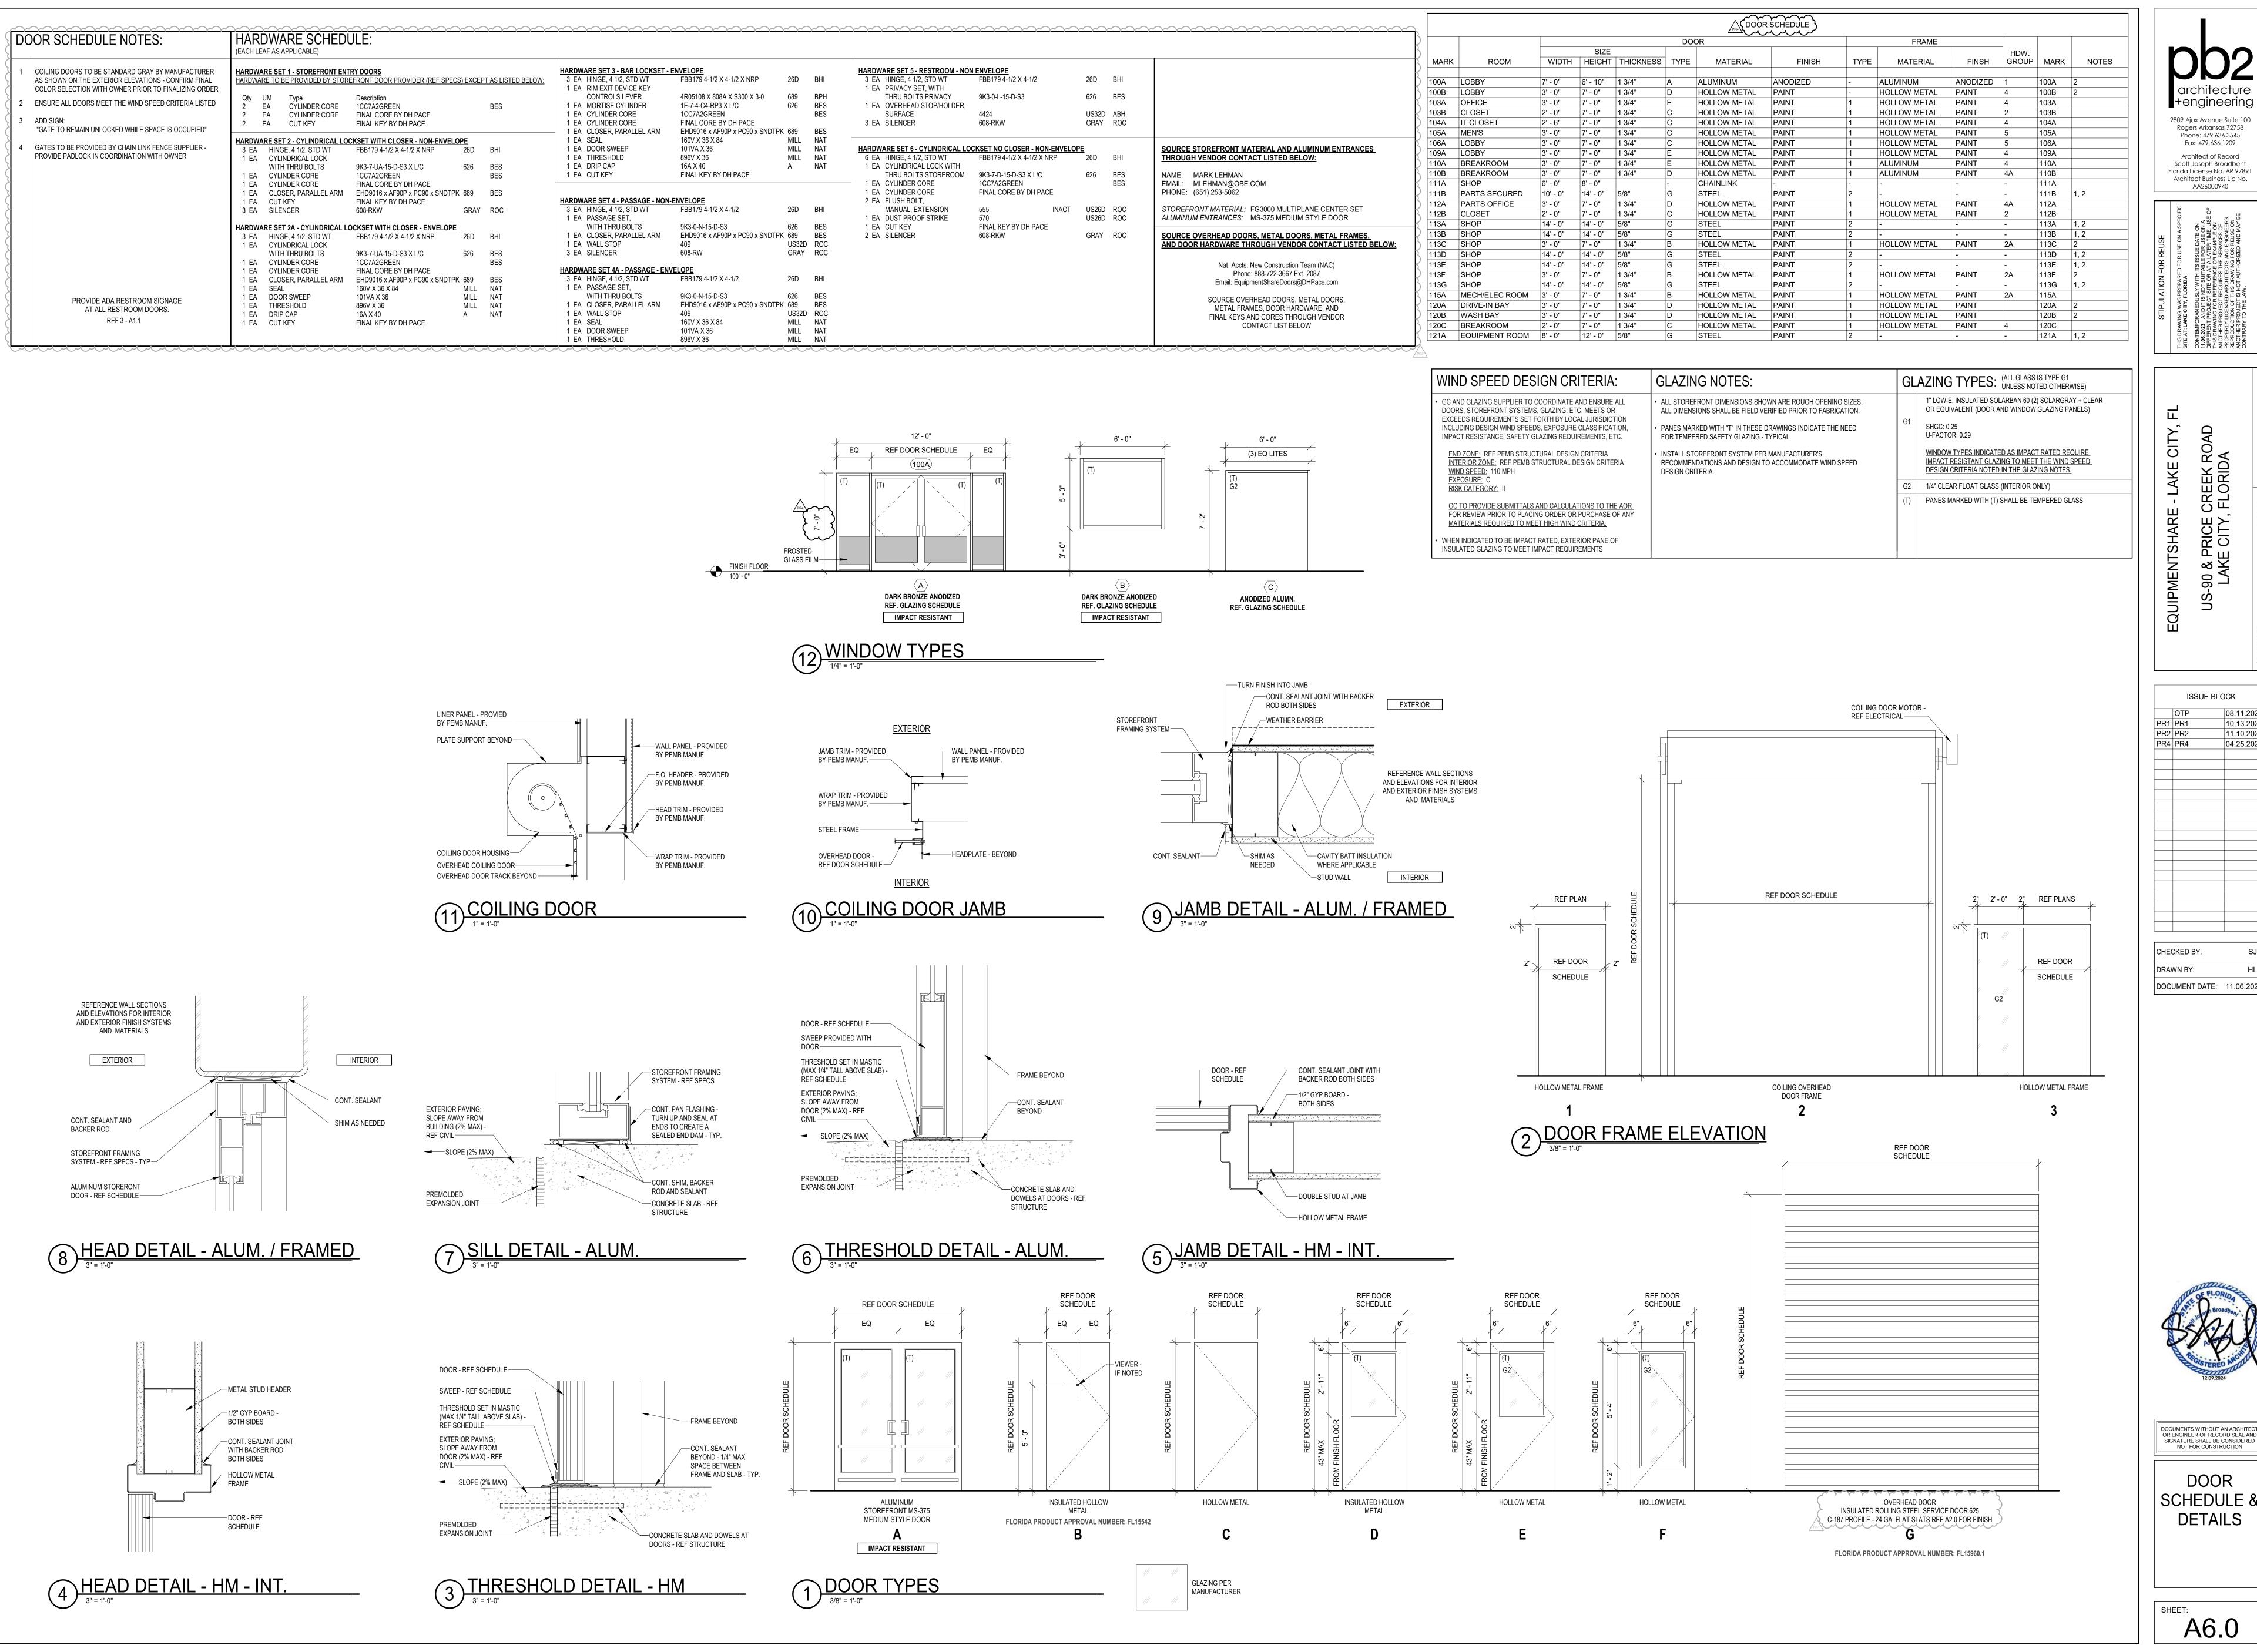

+engineering 2809 Aiax Avenue Suite 100 Rogers Arkansas 72758 Phone: 479.636.3545 Fax: 479.636.1209 Architect of Record Scott Joseph Broadbent Florida License No. AR 97891 Architect Business Lic No. AA26000940

90 A

ISSUE BLOCK 10.13.2023 11.10.2023 04.25.2024 CHECKED BY: DRAWN BY: DOCUMENT DATE: 11.06.2023



SIGNATURE SHALL BE CONSIDERE NOT FOR CONSTRUCTION DOOR SCHEDULE & **DETAILS**

SHEET: A6.0