

PERMIT WORKSHEET

page 1 of 2

PERMIT NUMBER



Installer Brent Strickland License # IH 1104218
 Installer Mobile Phone # 386-365-7043
 Address of home being installed 248 NW McCall Trail
Lakeland, FL 32055
 Manufacturer Fleetwood Length x width 58x28

NOTE: if home is a single wide fill out one half of the blocking plan
 if home is a triple or quad wide sketch in remainder of home


I understand Lateral Arm Systems cannot be used on any home (new or used)
 where the sidewall ties exceed 5 ft 4 in.

Installer's initials B.S.

Typical pier spacing

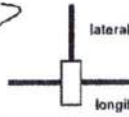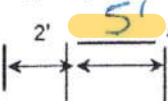

Show locations of Longitudinal and Lateral Systems
 (use dark lines to show these locations)

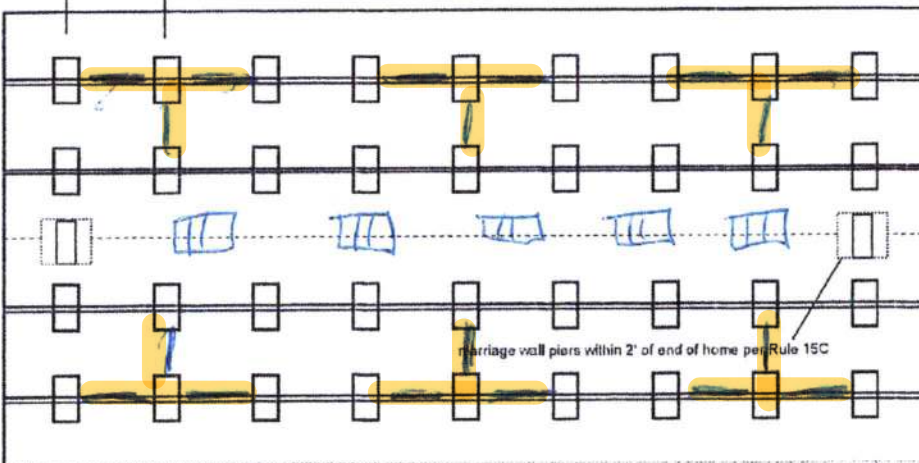

Anthony Islam

04-28-2022

New Home ☐ Used Home ☒

Home installed to the Manufacturer's Installation Manual ☐

Home is installed in accordance with Rule 15-C ☒

Single wide ☐ Wind Zone II ☒ Wind Zone III ☐

Double wide ☒ Installation Decal # 89552

Triple/Quad ☐ Serial # GAFLR54B74556HS

Roof System: ☒ Typical ☐ Hinged

PIER SPACING TABLE FOR USED HOMES

Load bearing capacity	Footer size (sq in)	16" x 16" (256)	18 1/2" x 18 1/2" (342)	20" x 20" (400)	22" x 22" (484)*	24" x 24" (576)*	26" x 26" (676)
1000 psf	3'	3'	4'	5'	6'	7'	8'
1500 psf	4' 6"	4' 6"	6'	7'	8'	8'	8'
2000 psf	6'	6'	8'	8'	8'	8'	8'
2500 psf	7' 6"	7' 6"	8'	8'	8'	8'	8'
3000 psf	8'	8'	8'	8'	8'	8'	8'
3500 psf	8'	8'	8'	8'	8'	8'	8'

* interpolated from Rule 15C-1 pier spacing table.

PIER PAD SIZES

I-beam pier pad size 17x25

Perimeter pier pad size 16x16

Other pier pad sizes (required by the mfg.) 17x25

Draw the approximate locations of marriage wall openings 4 foot or greater. Use this symbol to show the piers.

List all marriage wall openings greater than 4 foot and their pier pad sizes below.

Opening	Pier pad size

TIEDOWN COMPONENTS

Longitudinal Stabilizing Device (LSD)
 Manufacturer Diversion
 Longitudinal Stabilizing Device w/ Lateral Arms
 Manufacturer Diversion

POPULAR PAD SIZES

Pad Size	Sq In
16 x 16	256
16 x 18	288
18.5 x 18.5	342
16 x 22.5	360
17 x 22	374
13 1/4 x 26 1/4	348
20 x 20	400
17 3/16 x 25 3/16	441
17 1/2 x 25 1/2	446
24 x 24	576
26 x 26	676

ANCHORS

4 ft ☒ 5 ft ☐

FRAME TIES

within 2' of end of home spaced at 5' 4" oc ☒

OTHER TIES

	Number
Sidewall	<u>24</u>
Longitudinal	<u>4</u>
Marriage wall	<u>8</u>
Shearwall	<u>4</u>

PERMIT NUMBER

POCKET PENETROMETER TEST

The pocket penetrometer tests are rounded down to _____ psf
or check here to declare 1000 lb. soil ☒ without testing.

X 1000 X 1000 X 1000

POCKET PENETROMETER TESTING METHOD

1. Test the perimeter of the home at 6 locations.
2. Take the reading at the depth of the footer.
3. Using 500 lb. increments, take the lowest reading and round down to that increment.

X 1000 X 1000 X 1000

TORQUE PROBE TEST

The results of the torque probe test is 290 inch pounds or check here if you are declaring 5' anchors without testing _____. A test showing 275 inch pounds or less will require 5 foot anchors.

Note: A state approved lateral arm system is being used and 4 ft. anchors are allowed at the sidewall locations. I understand 5 ft anchors are required at all centerline tie points where the torque test reading is 275 or less and where the mobile home manufacturer may requires anchors with 4000 lb holding capacity.

B.S. Installer's initials

ALL TESTS MUST BE PERFORMED BY A LICENSED INSTALLER

Installer Name Brent Strickland
Date Tested 4-26-22

Electrical

Connect electrical conductors between multi-wide units, but not to the main power source. This includes the bonding wire between multi-wide units. Pg. 29

Plumbing

Connect all sewer drains to an existing sewer tap or septic tank. Pg. 28

Connect all potable water supply piping to an existing water meter, water tap, or other independent water supply systems. Pg. 29

Site Preparation

Debris and organic material removed ☒
Water drainage: Natural Swale Pad ☒ Other _____

Fastening multi wide units

Floor: Type Fastener: lags Length: 5" Spacing: 16"
Walls: Type Fastener: screws Length: 4" Spacing: 16"
Roof: Type Fastener: lags Length: 6" Spacing: 16"
For used homes a min. 30 gauge, 8" wide, galvanized metal strip will be centered over the peak of the roof and fastened with galv. roofing nails at 2" on center on both sides of the centerline.

Gasket (weatherproofing requirement)

I understand a properly installed gasket is a requirement of all new and used homes and that condensation, mold, mildew and buckled marriage walls are a result of a poorly installed or no gasket being installed. I understand a strip of tape will not serve as a gasket.

Installer's initials B.S.

Type gasket Foam
Pg. 22

Installed:
Between Floors Yes ☒
Between Walls Yes ☒
Bottom of ridgebeam Yes ☒

Weatherproofing

The bottomboard will be repaired and/or taped. Yes ☒ Pg. _____
Siding on units is installed to manufacturer's specifications. Yes ☒
Fireplace chimney installed so as not to allow intrusion of rain water. Yes ☒

Miscellaneous

Skirting to be installed. Yes ☒ No _____
Dryer vent installed outside of skirting. Yes _____ N/A ☒
Range downflow vent installed outside of skirting. Yes _____ N/A ☒
Drain lines supported at 4 foot intervals. Yes ☒
Electrical crossovers protected. Yes ☒
Other: _____

Installer verifies all information given with this permit worksheet is accurate and true based on the manufacturer's installation instructions and or Rule 15C-1 & 2

Installer Signature B. Strickland Date 4-26-22

Proposed


Adams FA

1456 SQ

52'
58

6'

28

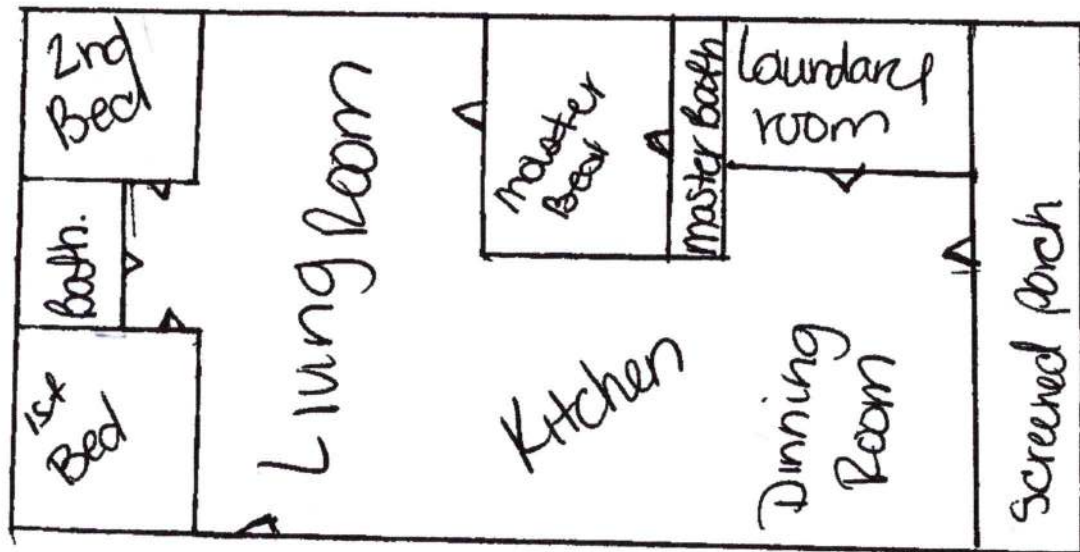

4/26/22

Manufacturer Address

Fleetwood Homes of GA., Inc.
Hwy 82 West
Pearson, GA 31642

Plant Number

#54

Date of Manufacture HUD No.

3-5-94

GEO 778574/778575

Manufacturer's Serial Number and Model and Identification

GAFLR54A74556-HS/GAFLR54B74556-HS 4583P

Design Approval (D.A.P.A.)

RADCO

This manufactured home is designed to comply with the federal manufactured home construction and safety standards in force at time of manufacture.
(For additional information, consult owner's manual.)

The factory installed equipment includes:

Equipment	Manufacturer	Model Designation
For heating	Coleman	EB164
For air cooling		
For cooking	Magic Chef	3510P
Refrigerator	Magic Chef	RB171P1W
Water heater	Rheem	71-325
Washer		
Clothes Dryer		
Dishwasher		
Garbage Disposal		
Fireplace	Coleman	36ECM

DESIGN WIND

ZONE MAP

Zone I
Standard Wind
15 mph sustained
15 mph gust

Zone II
Standard Wind
25 mph sustained
25 mph gust



SEMI-RIGID LOAD
ZONE MAP

Zone I
Standard Wind
15 mph sustained
15 mph gust

Zone II
Standard Wind
25 mph sustained
25 mph gust



COMFORT HEATING

This manufactured home has been thoroughly inspected to conform with the requirements of the federal manufactured home construction and safety standards for all equipment when automatic zone I.

Heating equipment manufacturer and model (see list at left).
The above heating equipment has the capacity to maintain an average 70° F temperature in this home at outdoor temperatures of 0° F.

To maximize furnace operating economy, and to conserve energy, it is recommended that this home be installed where the outdoor winter design temperature (57° F) is not higher than 21° degrees Fahrenheit.

The above information has been calculated assuming a maximum wind velocity of 15 mph at standard atmospheric pressure.

COMFORT COOLING

☐ Air conditioner provided at factory (Alternate I)

Air conditioner manufacturer and model (see list at left).
Certified capacity — B.T.U. hours in accordance with the appropriate air conditioning and refrigeration institute standards.

The central air conditioning system provided in this home has been sized according to orientation of the front (hitch end) of the home facing — On this basis the system is designed to maintain an indoor temperature of 75° F when outdoor temperatures are — F dry bulb and — F wet bulb.

The temperature to which this home can be cooled will change depending upon the amount of exposure of the windows of this home to the sun's radiation. Therefore, the home's heat gains will vary dependent upon its orientation to the sun and any permanent shading provided. Information concerning the calculation of cooling loads at various locations, window exposures and shadings are provided in Chapter 22 of the 1981 edition of the ASHRAE Handbook of Fundamentals.

Information necessary to calculate cooling loads at various locations and orientations is provided in the special comfort cooling information provided with this home.

☐ Air conditioner not provided at factory (Alternate II)
The air distribution system of this home is suitable for the installation of central air conditioning.

The supply air distribution system installed in this home is sized for a maximum home central air conditioning system of up to 50,500 B.T.U. hours. The rated capacity when installed in accordance with the appropriate air conditioning and refrigeration institute standards, when the air conditioners of such air conditioners are rated at 0.3 inch water column static pressure or greater for the cooling air delivered to the manifold, tested home supply air distribution.

Information necessary to calculate cooling loads at various locations and orientations is provided in the special comfort cooling information provided with this home.

☐ Air conditioning not recommended (Alternate III)
The air distribution system of this home has not been designed in anticipation of the use with a central air conditioning system.

INFORMATION PROVIDED BY THE MANUFACTURER
NECESSARY TO CALCULATE SENSIBLE HEAT GAIN

Walls (without windows and doors)	12
Ceilings and roofs of light color	08
Ceilings and roofs of dark color	08
Floors	14
Air ducts in floor	13
Air ducts in ceiling	N/A
Air ducts installed outside the home	25

The following are the heat gains in this home:

Air ducts in floor	76.0
Air ducts in ceiling	N/A
Air ducts installed outside the home	47.0

To determine the required capacity of equipment for a central air conditioning system, the cooling load must be calculated. The cooling load is the sum of the sensible heat gains and the latent heat gains. The latent heat gains are the heat gains from moisture. The latent heat gains are the heat gains from moisture. The latent heat gains are the heat gains from moisture.

Each home's air conditioning system must be sized to accommodate all the heat gains. The latent heat gains are the heat gains from moisture. The latent heat gains are the heat gains from moisture. The latent heat gains are the heat gains from moisture.

OUTDOOR WINTER DESIGN TEMP. ZONES

