



STATE OF FLORIDA  
DEPARTMENT OF ENVIRONMENTAL PROTECTION  
ONSITE SEWAGE TREATMENT AND DISPOSAL  
SYSTEM (OSTDS)

PERMIT NO. 23-0235  
DATE PAID: 4/5/23  
FEE PAID: 425.00  
RECEIPT #: 1968912

APPLICATION FOR CONSTRUCTION PERMIT

APPLICATION FOR:

☒ New System ☐ Existing System ☐ Holding Tank ☐ Innovative  
☐ Repair ☐ Abandonment ☐ Temporary ☐

APPLICANT: Charles Hardy EMAIL: Chuck Hardy 20125@gmail.com

AGENT: Same TELEPHONE: 352-585-3270

MAILING ADDRESS: 20125 Bowman Rd. Spring Hill, FL 34610

TO BE COMPLETED BY APPLICANT OR APPLICANT'S AUTHORIZED AGENT. SYSTEMS MUST BE CONSTRUCTED BY A PERSON LICENSED PURSUANT TO 489.105(3) (m) OR 489.552, FLORIDA STATUTES. IT IS THE APPLICANT'S RESPONSIBILITY TO PROVIDE DOCUMENTATION OF THE DATE THE LOT WAS CREATED OR PLATTED (MM/DD/YY) IF REQUESTING CONSIDERATION OF STATUTORY GRANDFATHER PROVISIONS.

PROPERTY INFORMATION

OSTDS REMEDIATION PLAN? ☐ Y ☒ N

LOT: 2 BLOCK: \_\_\_\_\_ SUBDIVISION: Hunter Ridge PLATTED: 7

PROPERTY ID #: 25-38-15-00220-102 ZONING: \_\_\_\_\_ I/M OR EQUIVALENT: ☐ Y ☒ N

PROPERTY SIZE: 6.8 ACRES WATER SUPPLY: ☒ PRIVATE PUBLIC ☐ <=2000GPD ☐ >2000GPD

IS SEWER AVAILABLE AS PER 381.0065, FS? ☒ Y ☐ N DISTANCE TO SEWER: \_\_\_\_\_ FT

PROPERTY ADDRESS: 259 SW Mossy Oak Way, Lake City, FL 32024

DIRECTIONS TO PROPERTY: \_\_\_\_\_

BUILDING INFORMATION

☒ RESIDENTIAL ☐ COMMERCIAL

Unit No	Type of Establishment	No. of Bedrooms	Building Area Sqft	Commercial/Institutional System Design Table I, Chapter 62-6, FAC
1	<u>Storage building</u>	<u>0</u>	<u>3040</u>	
2				
3				
4				

☐ Floor/Equipment Drains ☐ Other (Specify) \_\_\_\_\_

SIGNATURE: Charles Hardy DATE: 5-4-2023

DEP 4015, 06-21-2022 (Obsoletes previous editions which may not be used)

Incorporated 62-6.004, FAC

Page 1 of 4

Handwritten notes in red ink at the top left corner, possibly including a date or reference number.

Handwritten notes in blue ink on the left side, possibly a list or a set of instructions.

Printed text in the upper middle section, likely a header or title, with some words appearing to be "PROCEEDINGS" and "OF THE" followed by illegible text.



Main body of the document containing multiple paragraphs of text, which is mostly illegible due to fading and low contrast. The text appears to be organized into several distinct sections or paragraphs.




STATE OF FLORIDA  
DEPARTMENT OF ENVIRONMENTAL PROTECTION  
APPLICATION FOR CONSTRUCTION PERMIT

Permit Application Number

23-0335

PART II - SITEPLAN

Scale: Each block represents 10 feet and 1 inch = 40 feet.

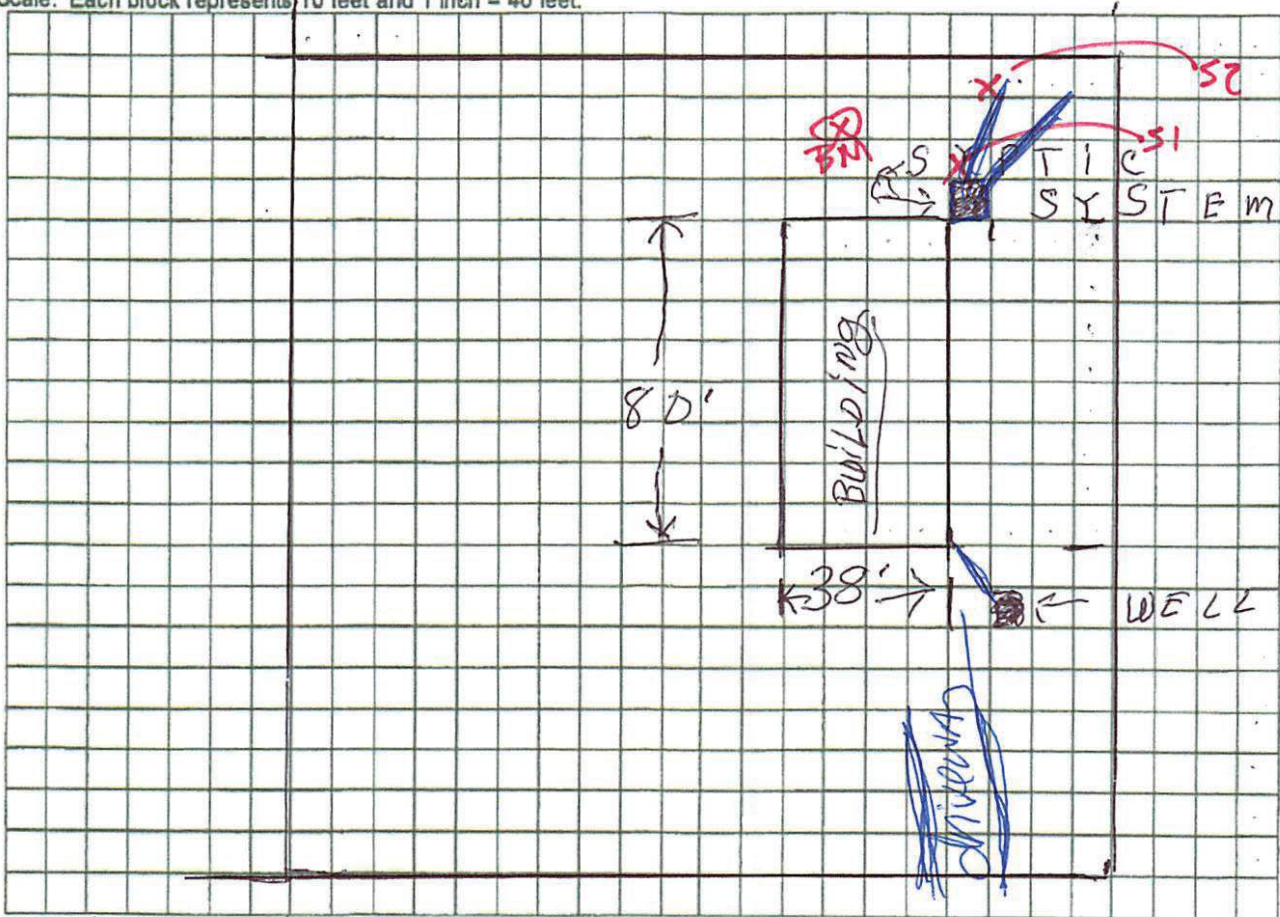

Notes: 2 SEPTIC SYSTEMS ONE FOR STORAGE BUILDING  
AND ONE FOR HOUSE (LATER)  
90 FEET AWAY FROM WELL INSTALL BY MYSELF

Site Plan submitted by:

Charles Hardy

MAY 4, 2023

Plan Approved

Not Approved

By

Date

5/15/23

County Health Department

ALL CHANGES MUST BE APPROVED BY THE COUNTY HEALTH DEPARTMENT

DEP 4015, 06-21-2022 (Obsoletes previous editions which may not be used)

Incorporated: 62-6.004, F.A.C.