



Mobile Home Permit Worksheet

Application Number:

Date:

New Home ☒ Used Home ☐

Home installed to the Manufacturer's Installation Manual
Home is installed in accordance with Rule 15-C

Installer: Reedy L. Kuehly License # 141038218
Address of home being installed: 847 NW AMANDA ST
LAKE CITY, FL 32055

Manufacturer: LINE OAK Length x Width: 20 x 36


NOTE: If home is a single wide fill out one half of the spacing plan.
If home is a triple or quad wide attach to remainder of home.
Undersigned Lateral Air Systems cannot be used on any home (new or used)
where the sidewall lies exceed 5 ft 4 in.

Installer's initials: RK

Typical pier spacing:



Show locations of Longitudinal and Lateral Systems
(use dash lines to show these locations)

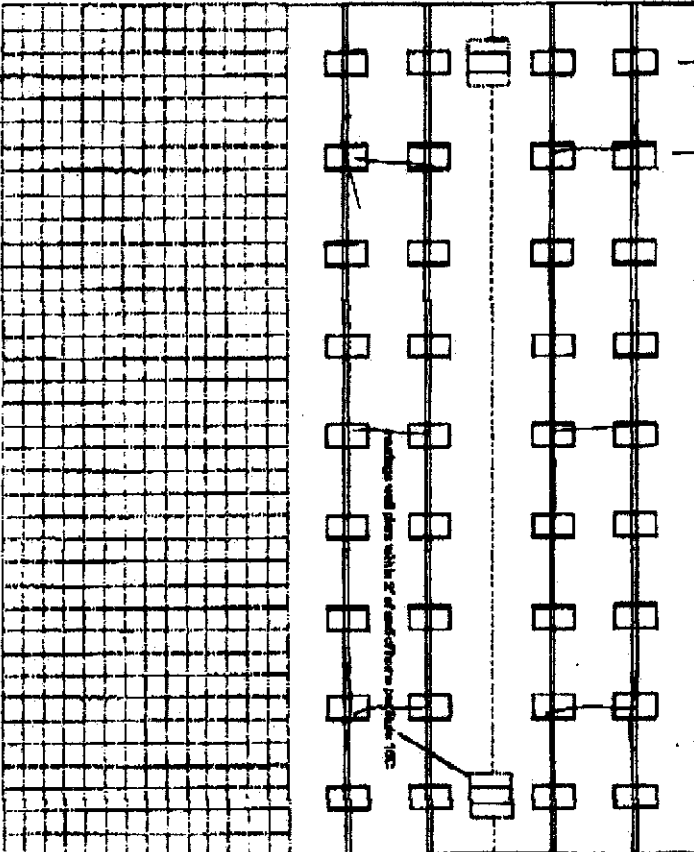

Single wide ☐ Wind Zone II ☒ Wind Zone III ☐
Double wide ☒ Installation Detail # 20202
Triple/Quad ☐ Serial # W4600 74897

PIER SPACING TABLE FOR USED HOMES

Load bearing capacity (sq ft)	16' x 16' (256)	16' 1/2' x 16' (172' (242))	20' x 20' (400)	22' x 22' (484)	24' x 24' (576)	26' x 26' (676)
16000 psf	3'	4'	5'	6'	7'	8'
15000 psf	4'	5'	6'	7'	8'	9'
14000 psf	5'	6'	7'	8'	9'	10'
13000 psf	6'	7'	8'	9'	10'	11'
12000 psf	7'	8'	9'	10'	11'	12'
11000 psf	8'	9'	10'	11'	12'	13'
10000 psf	9'	10'	11'	12'	13'	14'
9000 psf	10'	11'	12'	13'	14'	15'
8000 psf	11'	12'	13'	14'	15'	16'
7000 psf	12'	13'	14'	15'	16'	17'
6000 psf	13'	14'	15'	16'	17'	18'
5000 psf	14'	15'	16'	17'	18'	19'
4000 psf	15'	16'	17'	18'	19'	20'
3000 psf	16'	17'	18'	19'	20'	21'
2000 psf	17'	18'	19'	20'	21'	22'
1000 psf	18'	19'	20'	21'	22'	23'
500 psf	19'	20'	21'	22'	23'	24'
250 psf	20'	21'	22'	23'	24'	25'

* extrapolated from Rule 15-C-1 pier spacing table.

PIER PAD SIZES

1-beam pier pad size

Pediment pier pad size

Other pier pad sizes (required by the mfr.)

Draw the appropriate locations of marriage wall openings 4 foot or greater. Use this symbol to show the piers.

List all marriage wall openings greater than 4 foot and their pier pad sizes below.

Opening 19' Pier pad size mixed

TEARDROP COMPONENTS

Longitudinal Stabilizing Device (LSD)
Manufacturer Chlor-Flex

PORCH AIR PAD SIZES

Porch Size	54 sq ft
16' x 16'	256
16' x 18'	288
18' 5" x 18' 5"	342
18' x 22' 5"	380
17' x 22'	374
13' 1/4' x 28' 1/4'	348
20' x 20'	400
17' 3/8' x 25' 3/8'	441
17' 1/2' x 25' 1/2'	448
24' x 24'	576
26' x 26'	676

ANCHORS

FRAME TIES

CORNER TIES

Slidewall
Longitudinal Marriage wall
Shearwall

Mobile Home Permit Worksheet

Application Number: _____

Date: _____

POCKET PENETROMETER TEST

The pocket penetrometer tests are rounded down to 1000 psi and or check here to declare 1000 lb. soil without testing.

X 2 X _____ X _____

POCKET PENETROMETER TESTING METHOD

1. Test the perimeter of the home at 8 locations.
2. Take the reading at the depth of the footer.
3. Using 500 lb. increments, take the lowest reading and round down to that increment.

X _____ X _____ X _____

TORQUE PROBE TEST

The results of the torque probe test is N/A 1000 ft. pounds or check here if you are declaring 5 ft anchors without testing. A test exceeding 275 inch pounds or less will require 5 foot anchors.

Note: A state approved lateral arm system is being used and 4 ft anchors are allowed at the sidewall locations. 1 independent 5 ft anchors are required at all cantilever tie points where the torque test reading is 275 or less and where the mobile home manufacturer may require anchors with 4000 lb. holding capacity.

Installer's Initials

ALL TESTS MUST BE PERFORMED BY A LICENSED INSTALLER

Installer Name

Date Tested

Rush & Kuebler
1-7-25

Electrical

Connect electrical conductors between multi-wire units, but not to the main power source. This includes the bonding wire between multi-wire units. Pg. 11C-1

Plumbing

Connect all sewer drains to an existing sewer tap or septic tank. Pg. 11C-1
Connect all potable water supply piping to an existing water meter, water tap, or other independent water supply system. Pg. 11C-1

Site Preparation

Debris and organic material removed _____
Water drainage: Natural Swale Pad Other

Fastening multi-wire units

Floor: Type Fastener: longs Length: 4" Spacing: 20"
Wall: Type Fastener: anchors Length: 4" Spacing: 48"
Roof: Type Fastener: 1 1/4" Length: 1 1/4" Spacing: 48"
For used homes a min. 30 gauge, 8" wide, galvanized metal strip will be centered over the peak of the roof and fastened with galv. roofing nails at 2' on center on both sides of the centerline.

Gas/Hot Water/Propane (if installed)

I understand a properly installed gas/air is a requirement of all new and used homes and that condensation, mold, mildew and buckled materials are a result of a poorly installed or no gas/air being installed. I understand a strip of tape will not serve as a gas/air.

Installer's Initials

RUC

Type gas/air: factory
Pg. 10C-1

Installed: _____
Between Floors Yes _____
Between Walls Yes _____
Bottom of Ridgebeam Yes _____

Weatherproofing

The bottomboard will be repaired and/or taped. Yes ✓ Pg. 10C-1
Sliding on units is installed to manufacturer's specifications. Yes ✓
Fireplace chimney installed so as not to show intrusion of rain water. Yes ✓


Moisture Protection

Shading to be installed. Yes ✓ No _____
Dryer vent installed outside of siding. Yes _____ N/A _____
Range downflow vent installed outside of siding. Yes _____ N/A _____
Drain lines supported at 4 foot intervals. Yes _____
Electrical crossmembers protected. Yes _____
Other: _____

Installer verifies all information given with this permit worksheet is accurate and true based on the manufacturer's installation instructions and or Rule 15C-1 & 2

Installer Signature

Date 1-7-25

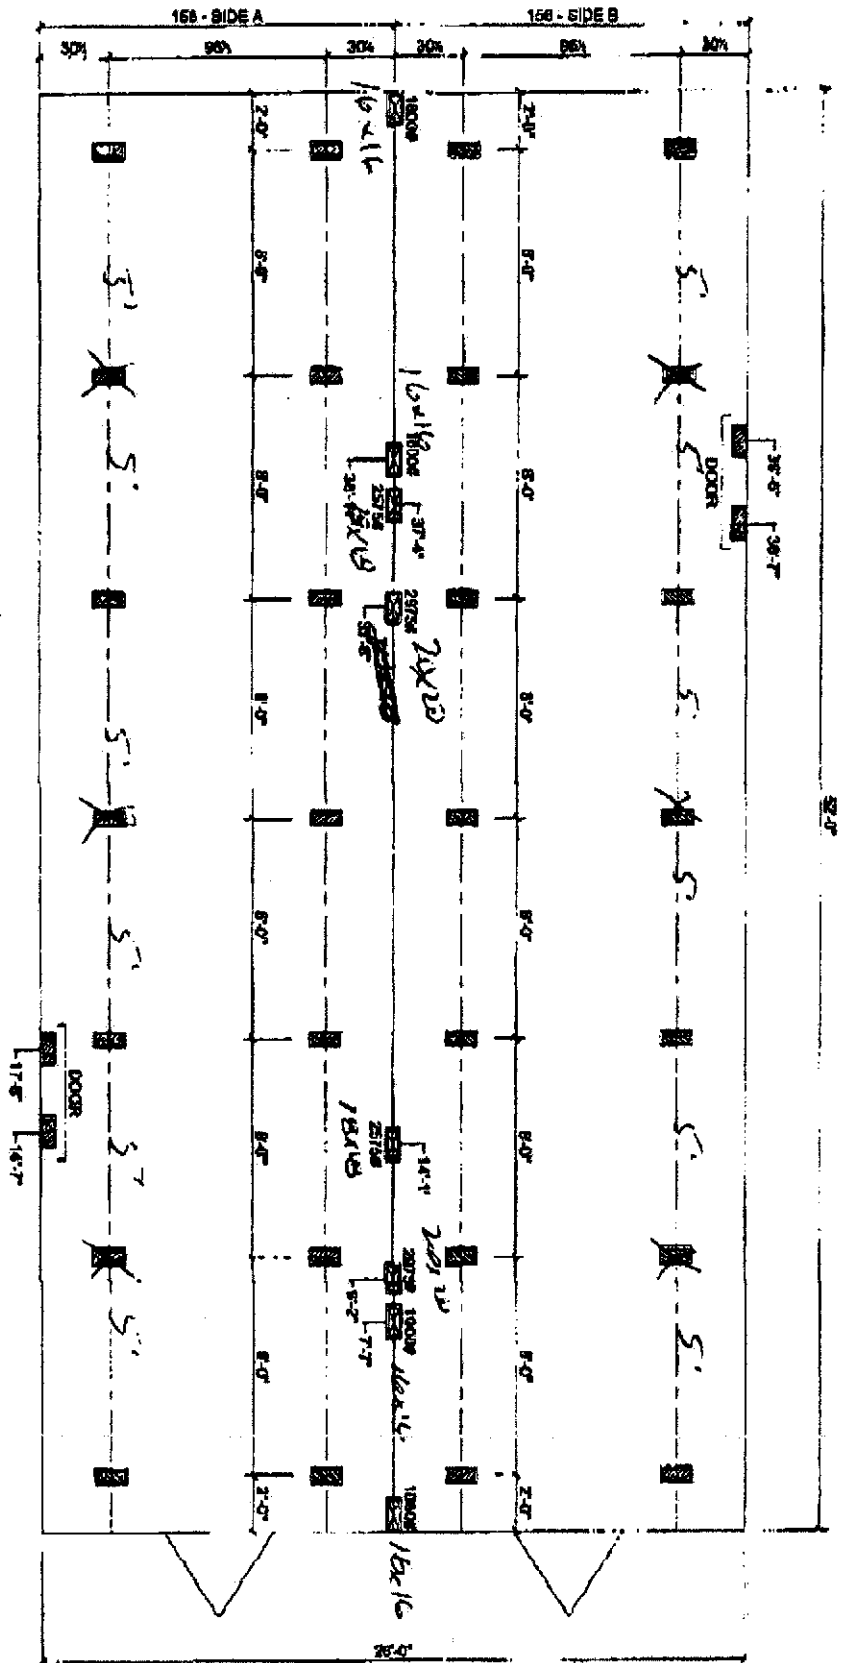

MARSHALL LINE OPENING SUPPORT PIER/TYP

REV: 05/16/22

FOUNDATION NOTES:

- THIS DRAWING IS DESIGNED FOR THE STANDARD WIND ZONE AND IS TO BE USED IN CONJUNCTION WITH THE INSTALLATION MANUAL AND ITS SUPPLEMENTS.
- FOOTINGS ARE REQUIRED FOR EXTERIOR ONLY QUALITY AND SPACING MAY VARY BASED ON PAD TYPE, SOIL CONDITION, ETC.
- FOOTINGS ARE REQUIRED AT SUPPORT POSTS, SEE INSTALLATION MANUAL FOR REQUIREMENTS.

Live Oak Homes
MODEL: D-2523H - 28 X 56
3-BEDROOM / 2-BATH

D-2523H