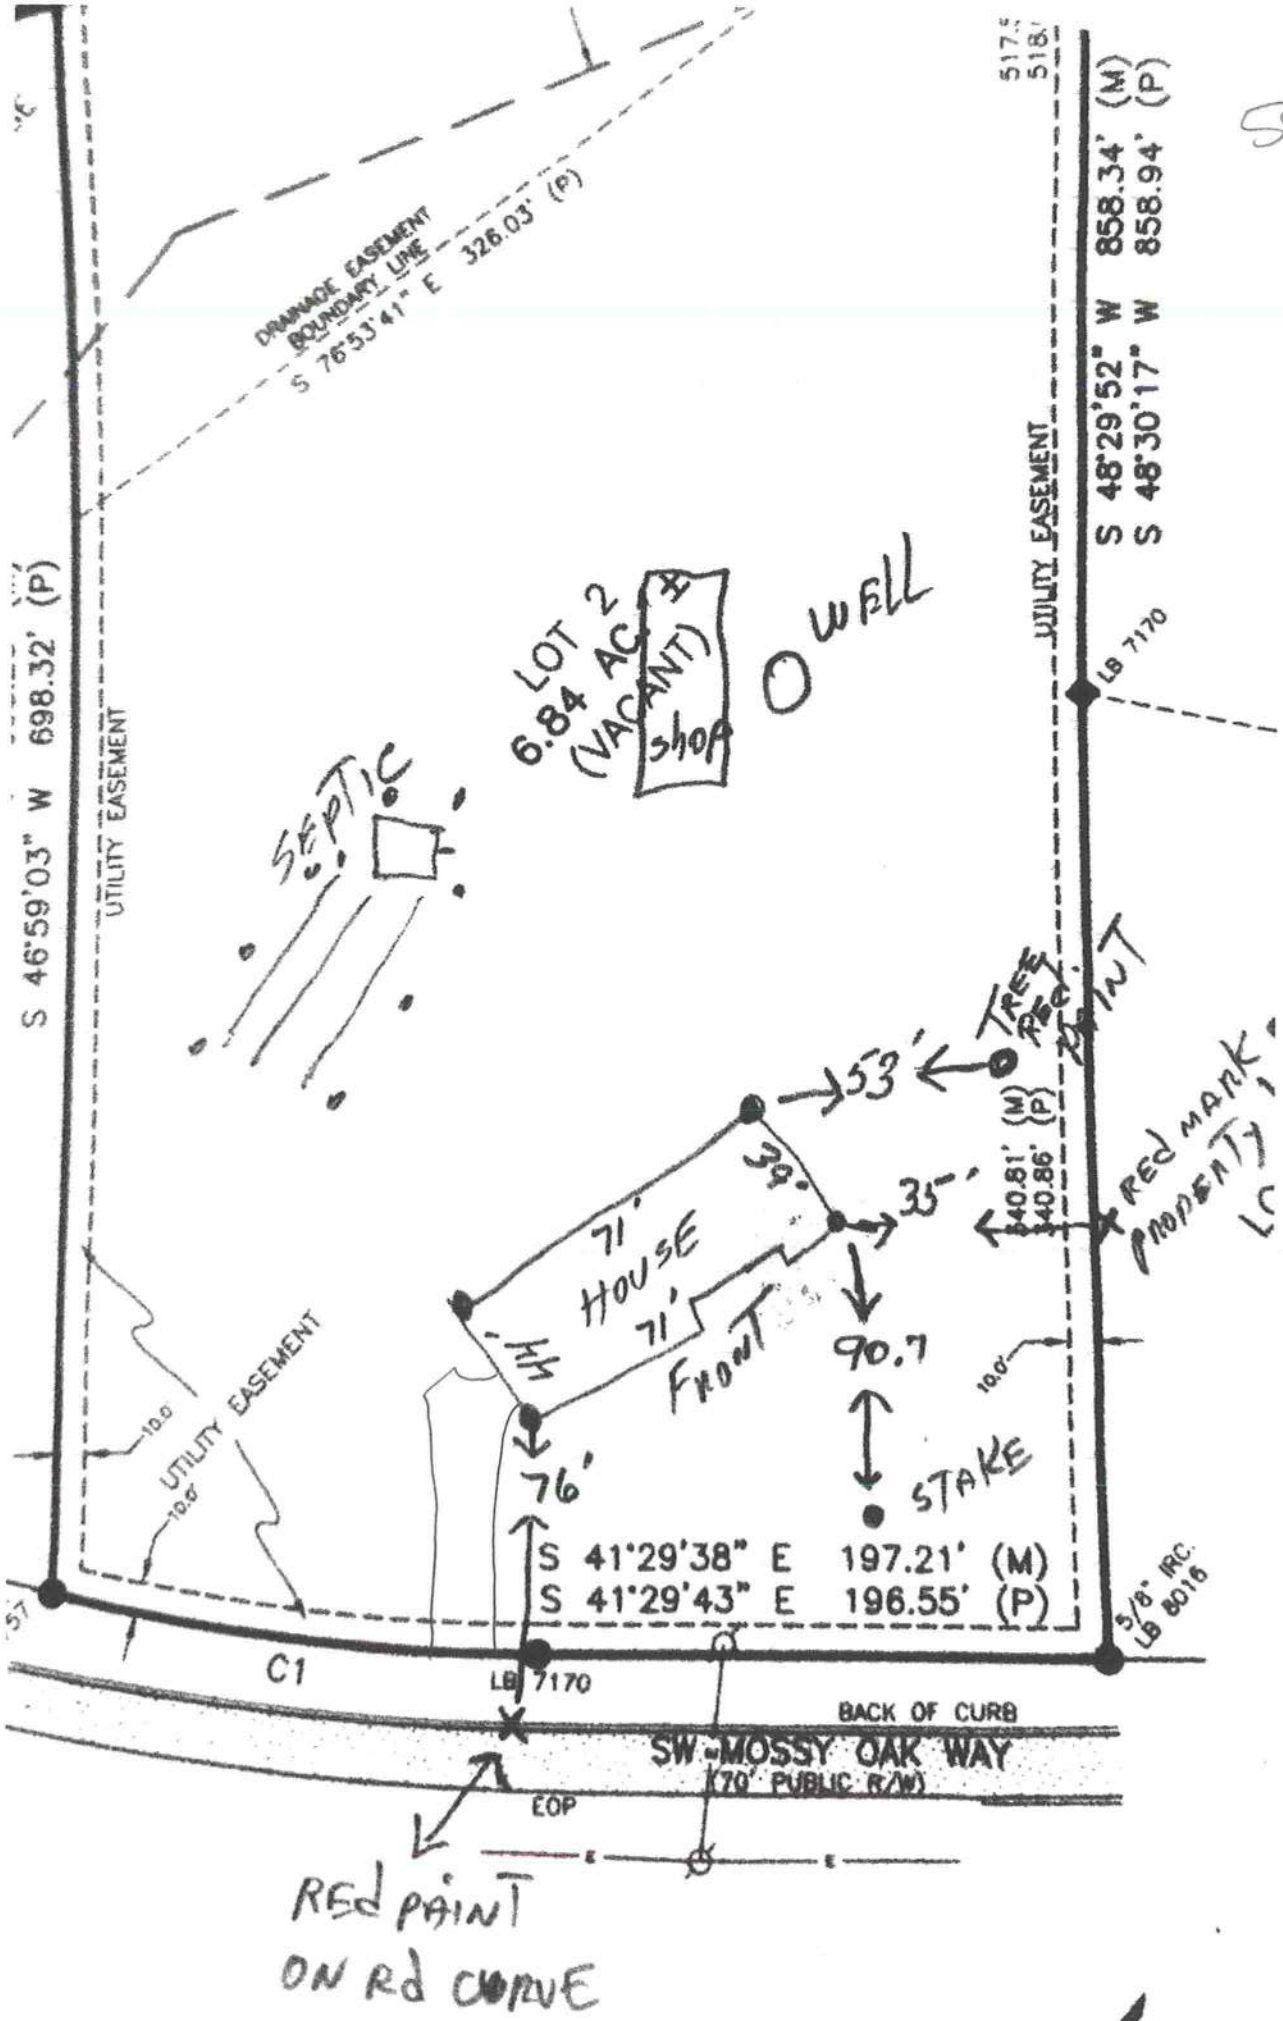
DRAINAGE EASEMENT
BOUNDARY LINE
S 76°53'41" E 326.03' (P)
S 46°59'03" W 698.32' (P)
UTILITY EASEMENT
UTILITY EASEMENT
S 48°29'52" W 858.34' (M)
S 48°30'17" W 858.94' (P)
LB 7170
LOT 2
6.84 AC
(VACANT)
shop
WELL
SEPTIC
TREE
RED PAINT
53'
39'
35'
40.81' (M)
40.86' (P)
RED MARK
PROPERTY
71'
HOUSE
71'
FRONT
90.7
10.0
UTILITY EASEMENT
10.0
10.0
76'
STAKE
S 41°29'38" E 197.21' (M)
S 41°29'43" E 196.55' (P)
5/8" IRC
LB 8016
C1
LB 7170
BACK OF CURB
SW MOSSY OAK WAY
(70' PUBLIC R/W)
EOP
RED PAINT
ON RD CURVE

56