STATE OF FLORIDA
DEPARTMENT OF HEALTH
ONSITE SEWAGE TREATMENT AND DISPOSAL SYSTEM
APPLICATION FOR CONSTRUCTION PERMIT

PERMIT NO. 21-0150
DATE PAID: 2/16/21
FEE PAID: 160.00
RECEIPT #: 1438885

APPLICATION FOR:
[ ] New System [ ] Existing System [ ] Holding Tank [ ] Innovative
[ ] Repair [ ] Abandonment [ ] Temporary [ ] _____

APPLICANT: ~~Trent Gieberg~~ George Smith Jr

AGENT: Trent Gieberg TELEPHONE: 397-0545

MAILING ADDRESS: 697 SE Holly Terrace

TO BE COMPLETED BY APPLICANT OR APPLICANT'S AUTHORIZED AGENT. SYSTEMS MUST BE CONSTRUCTED BY A PERSON LICENSED PURSUANT TO 489.105(3)(m) OR 489.552, FLORIDA STATUTES. IT IS THE APPLICANT'S RESPONSIBILITY TO PROVIDE DOCUMENTATION OF THE DATE THE LOT WAS CREATED OR PLATTED (MM/DD/YY) IF REQUESTING CONSIDERATION OF STATUTORY GRANDFATHER PROVISIONS.

PROPERTY INFORMATION

LOT: 37&38 BLOCK: — SUBDIVISION: Mayfair K-3 PLATTED: _____

PROPERTY ID #: 11-15-16 02911-337 ZONING: _____ I/M OR EQUIVALENT: [ Y / N ]

PROPERTY SIZE: 1.02 ACRES WATER SUPPLY: [✓] PRIVATE PUBLIC [ ]<=2000GPD [ ]>2000GPD

IS SEWER AVAILABLE AS PER 381.0065, FS? [ Y / N ] DISTANCE TO SEWER: _____ FT

PROPERTY ADDRESS: 559 SW Mayfair Ln 32024

DIRECTIONS TO PROPERTY: 247 South -1

BUILDING INFORMATION [/] RESIDENTIAL [ ] COMMERCIAL

| Unit No | Type of Establishment | No. of Bedrooms | Building Area Sqft | Commercial/Institutional System Design Table 1, Chapter 64E-6, FAC |
|---|---|---|---|---|
| 1 | add ~~gar~~ detached garage | | 520 sq ft | ORIGINAL ATTACHED |
| 2 | | | | |
| 3 | | | | |
| 4 | | | | |

[ ] Floor/Equipment Drains [ ] Other (Specify) _____

SIGNATURE: [signature] DATE: 2-16-21

DH 4015, 08/09 (Obsoletes previous editions which may not be used)
Incorporated 64E-6.001, FAC

STATE OF FLORIDA
DEPARTMENT OF HEALTH
APPLICATION FOR CONSTRUCTION PERMIT

Permit Application Number 21-0150

Scale: Each block represents 10 feet and 1 inch = 40 feet.

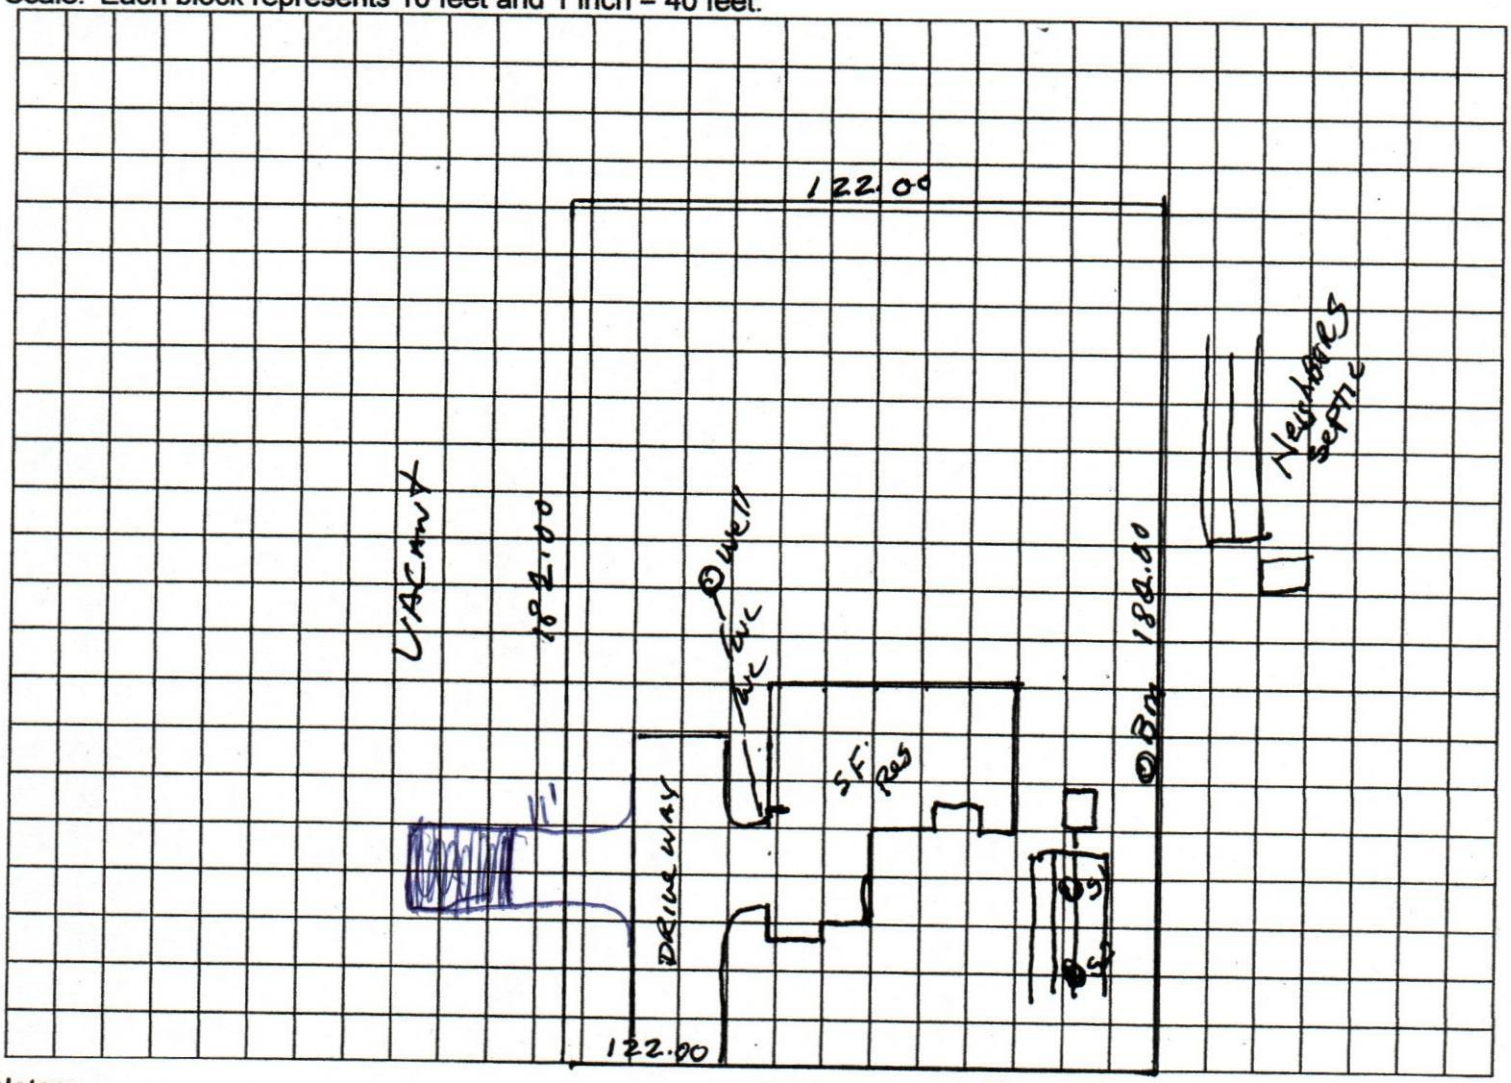


Notes:

MAYFAIR Lot # 37 UNIT 3 Owner owns both lots
TOTAR 0.51 ACRES

Site Plan submitted by: [signature] Owner

Plan Approved ✓ Not Approved ____ Date 2/17/21

By [signature] County Health Department

**ALL CHANGES MUST BE APPROVED BY THE COUNTY HEALTH DEPARTMENT**

21-8150

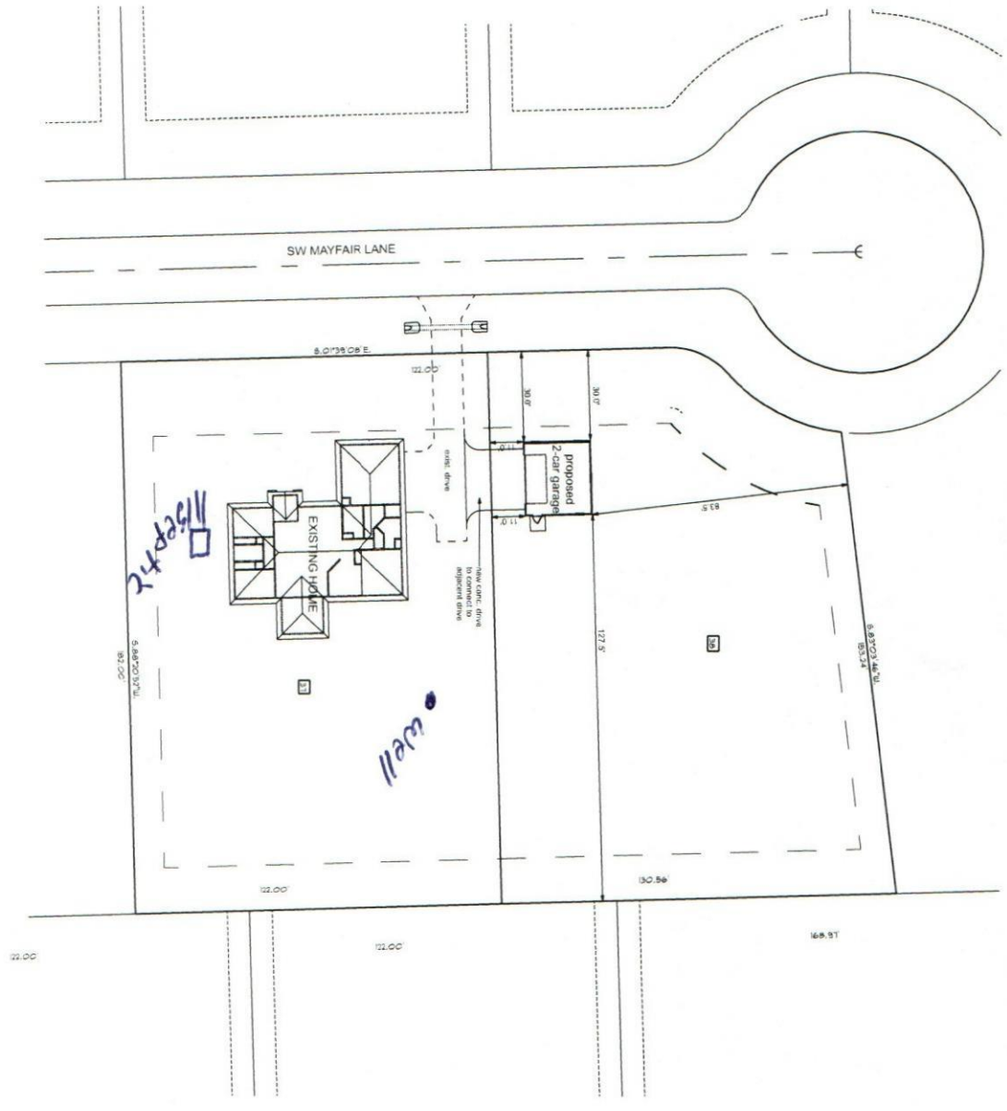


## SITE DATA

ZONING: RSF-2
MINIMUM LOT SIZE: 20,000 sf
FRONT/SIDE/REAR SETBACKS: 25'/10'/15'
FLOOD ZONE: ZONE "X"

DESCRIPTION
LOT 37&38 MAYFAIR SUBDIVISION

scale: 1" = 20'-0"

| | | | |
|---|---|---|---|
| SHEET A-2 | REVISIONS | DATE 1/14/26 | COASTAL ENGINEERING AND TESTING, INC. P.O. BOX 860125 ST. AUGUSTINE, FL. 32086 (904) 429-7536 C.O.A. # 00006701 |
| OF 5 | | APPROVED W.V.I.F. | LOT 37&38 MAYFAIR S/D - GARAGE |
| PROJECT NO 21-0851 | | DRAWN BY W.V.I.F. | SITE PLAN |
| | | | P.E. # 56001 |

559 SW Mayfair Ln.