

Walter H. Freese
11/18/11
P.E. # 98003

DALE AND MARY NANNY
RESIDENCE

128 SW NASSAU STREET
LAKE CITY, FL 32025
(386) 758-4209




CERTIFICATE OF AUTHORIZATION # 00087015

DRAWN BY
W.H.F.
DATE
11/18/11
APPROVED
W.H.F.

REVISIONS

SHEET
A-9
OF
10

PROJECT NO.
11.R036

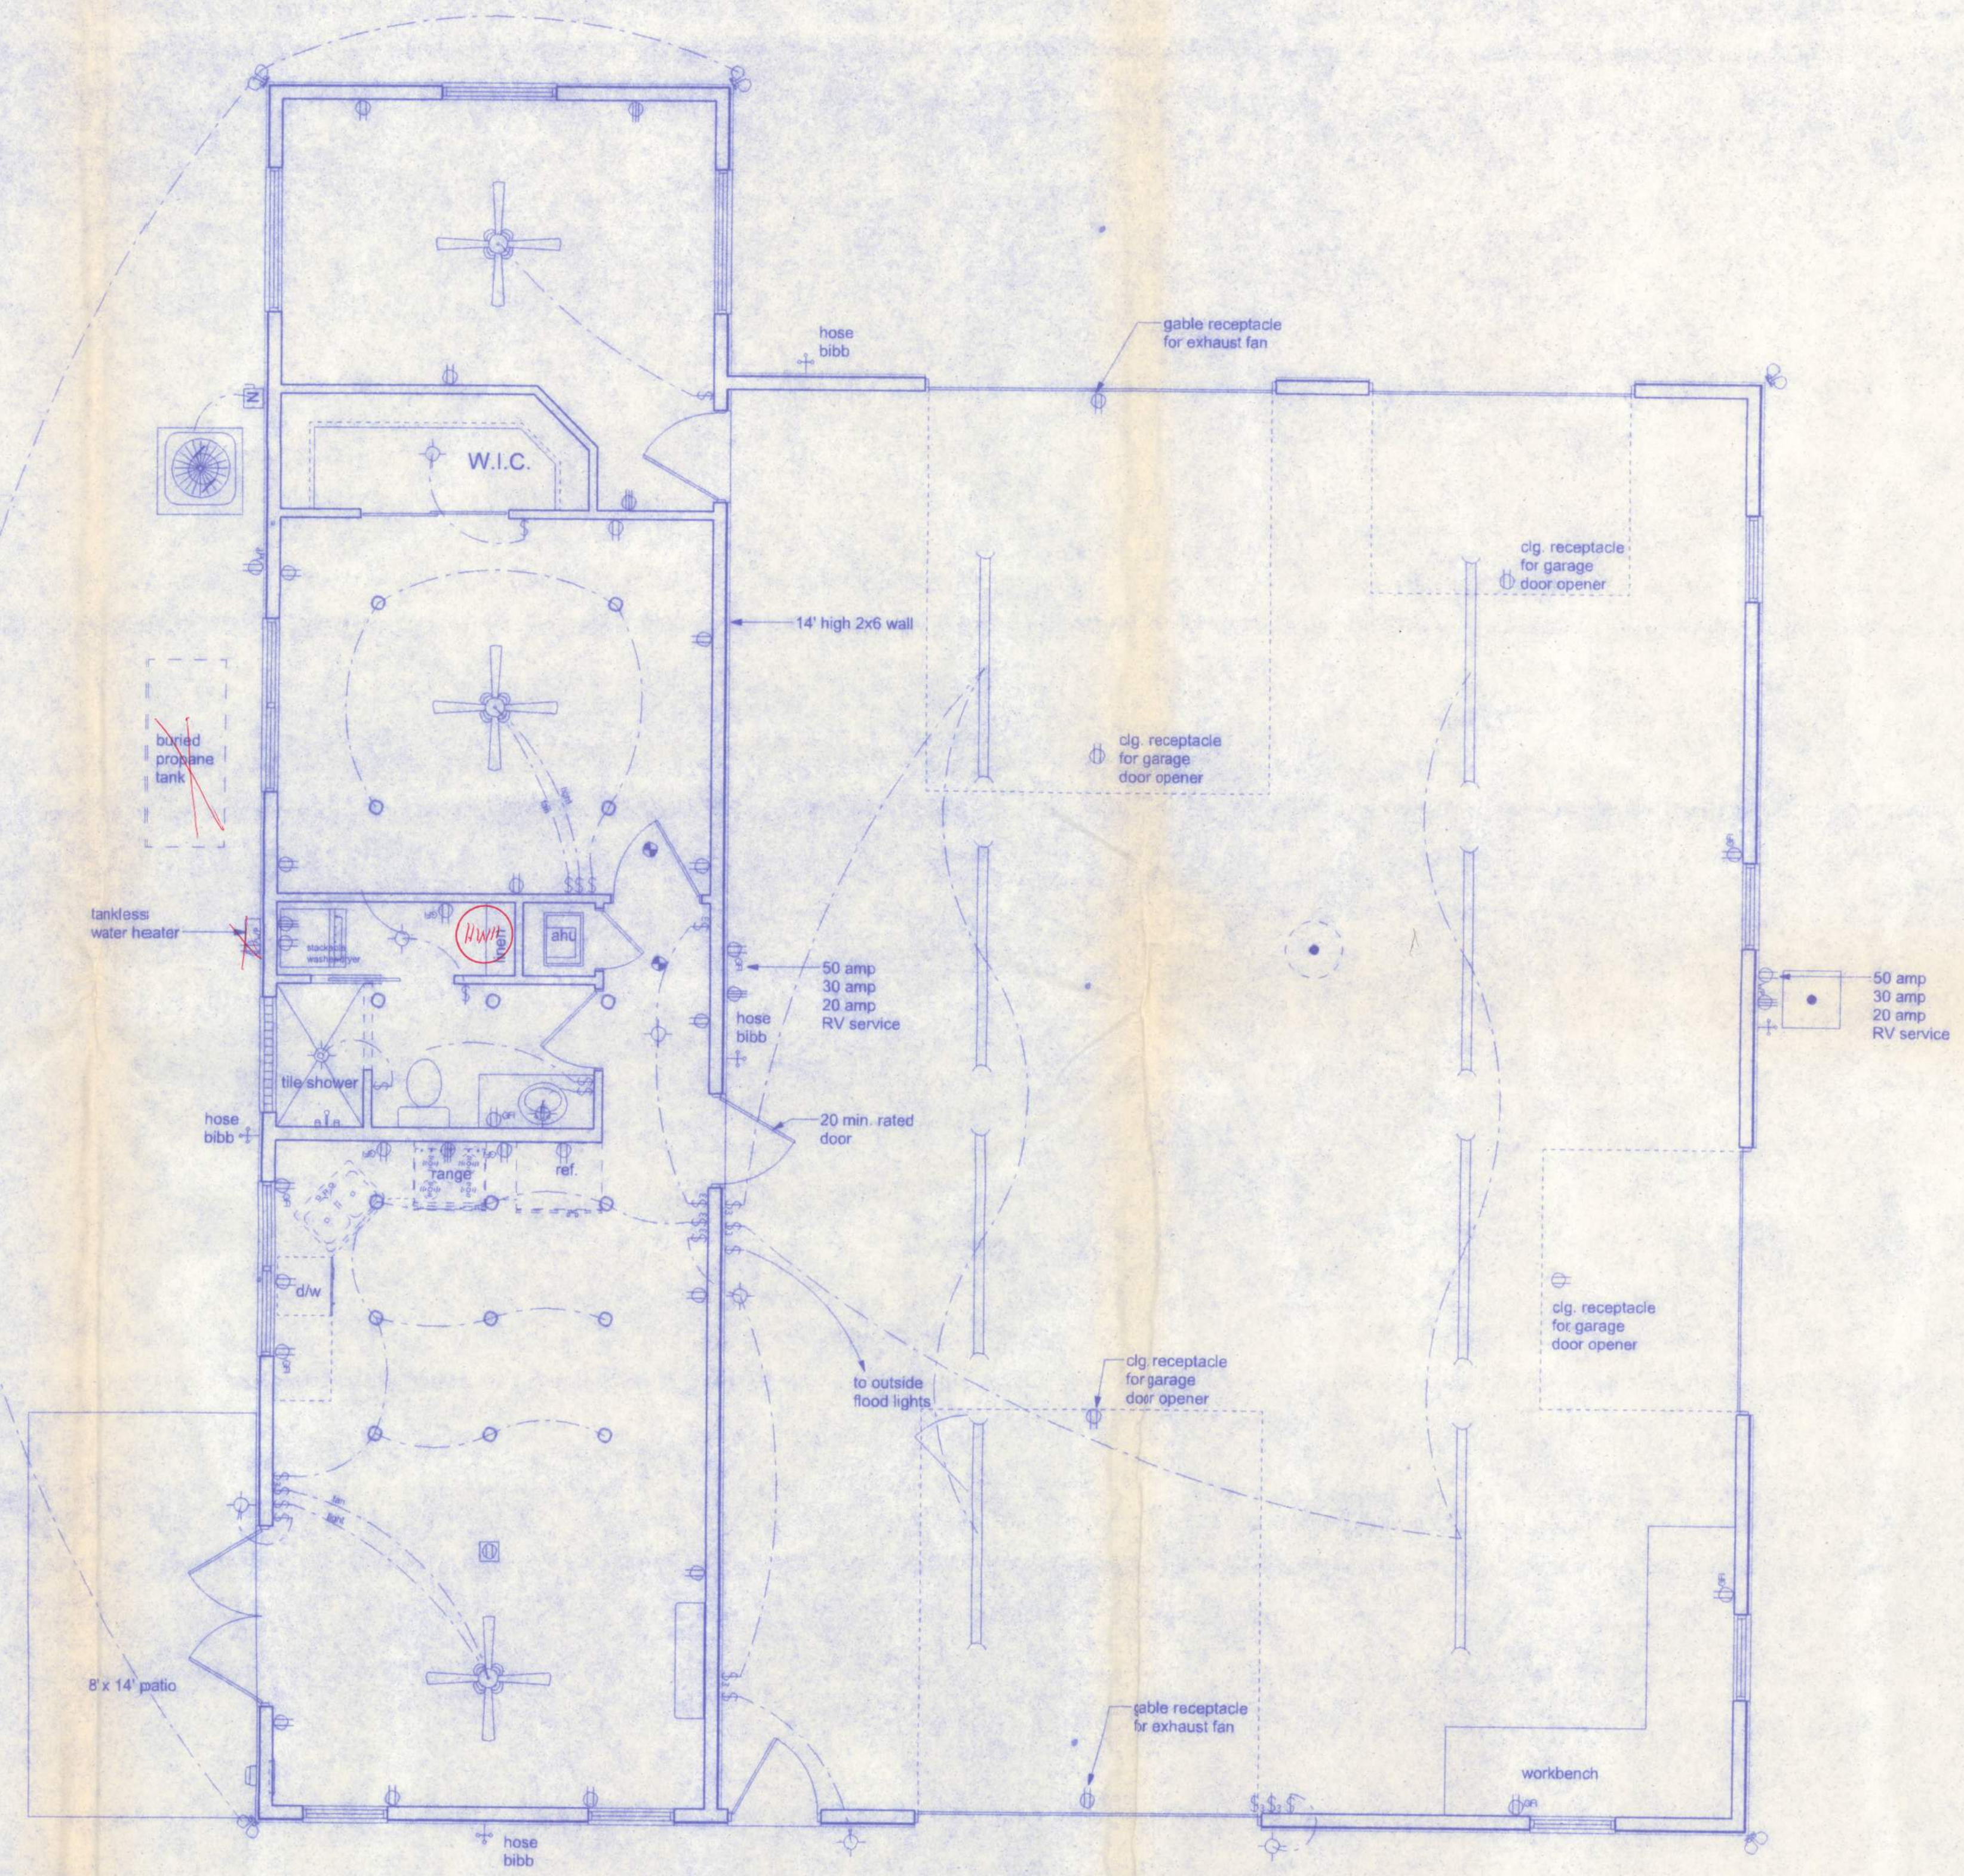

ELECTRICAL PLAN
SCALE: 1/4" = 1'-0"

ELECTRICAL	COUNT	SYMBOL
ceiling fan with spotlights	2	
8' strip lights fluorescent	8	
can light 6inch	16	
double spotlight	5	
electrical meter	1	
electrical panel	1	
motor	1	
non fused disconnect	1	
50 cfm exhaust fan	1	
floor outlet	2	
light	7	
outlet	18	
outlet 220v	6	
outlet gfi	10	
outlet wp	2	
smoke/CO2 detector	2	
switch	13	
switch 3 way	11	

NOTE:
all 120 volt, single phase, 15 and 20 ampere branch circuits supplying outlets installed in dwelling unit family rooms, dining rooms, living rooms, parlors, libraries, dens, bedrooms, sunroom, recreation rooms, closets, hallways, or similar rooms or areas shall be protected by a listed arc-fault circuit interrupter, combination type, installed to provide protection of the branch circuits.

ELECTRICAL PLAN NOTES

WIRE ALL APPLIANCES, HVAC UNITS AND OTHER EQUIPMENT PER MANUF. SPECIFICATIONS.

CONSULT THE OWNER FOR THE NUMBER OF SEPERATE TELEPHONE LINES TO BE INSTALLED.

INSTALLATION SHALL BE PER NAT'L. ELECTRIC CODE.

ALL SMOKE DETECTORS SHALL BE 120V W/ BATTERY BACKUP OF THE PHOTOELECTRIC TYPE, AND SHALL BE INTERLOCKED TOGETHER. INSTALL INSIDE AND NEAR ALL BEDROOMS.

TELEPHONE, TELEVISION AND OTHER LOW VOLTAGE DEVICES OR OUTLETS SHALL BE AS PER THE OWNER'S DIRECTIONS, & IN ACCORDANCE W/ APPLICABLE SECTIONS OF NEC-LATEST EDITION.

ELECTRICAL CONTR SHALL PREPARE "AS-BUILT" SHOP DWGS INDICATING ALL ELECTRICAL WORK, INCLUDING ANY CHANGES TO THE ELEC. PLAN, ADDNS TO THE ELEC. PLAN, RISER DIAGRAM, AS-BUILT PANEL, SCHEDULE W/ ALL CKTS IDENTIFIED W/ CKT Nr., DESCRIPTION & BRKR. SERVICE ENT. & ALL UNDERGROUND WIRE LOCATIONS/ROUTING/DEPTH. RISER DIA. SHALL INCLUDE WIRE SIZES/TYPE & EQUIPMENT TYPE W/ RATINGS & LOADS. CONTRACTOR SHALL PROVIDE 1 COPY OF AS-BUILT DWGS TO OWNER & 1 COPY TO THE PERMIT ISSUING AUTHORITY.