SLAB ASBUILT SURVEY

CURVE TABLE

CURVE	RADIUS	DELTA	ARC	CHORD	CHORD BEARING
C1	245.00'	49°05'38"	209.93'	203.56	S 36°47'47"E
C2	20.00'	90°00'00"	31.42'	28.28	N 36°39'24"E

LINE TABLE

LINE	BEARING	DISTANCE
L1	N 61°20'35"W	28.33

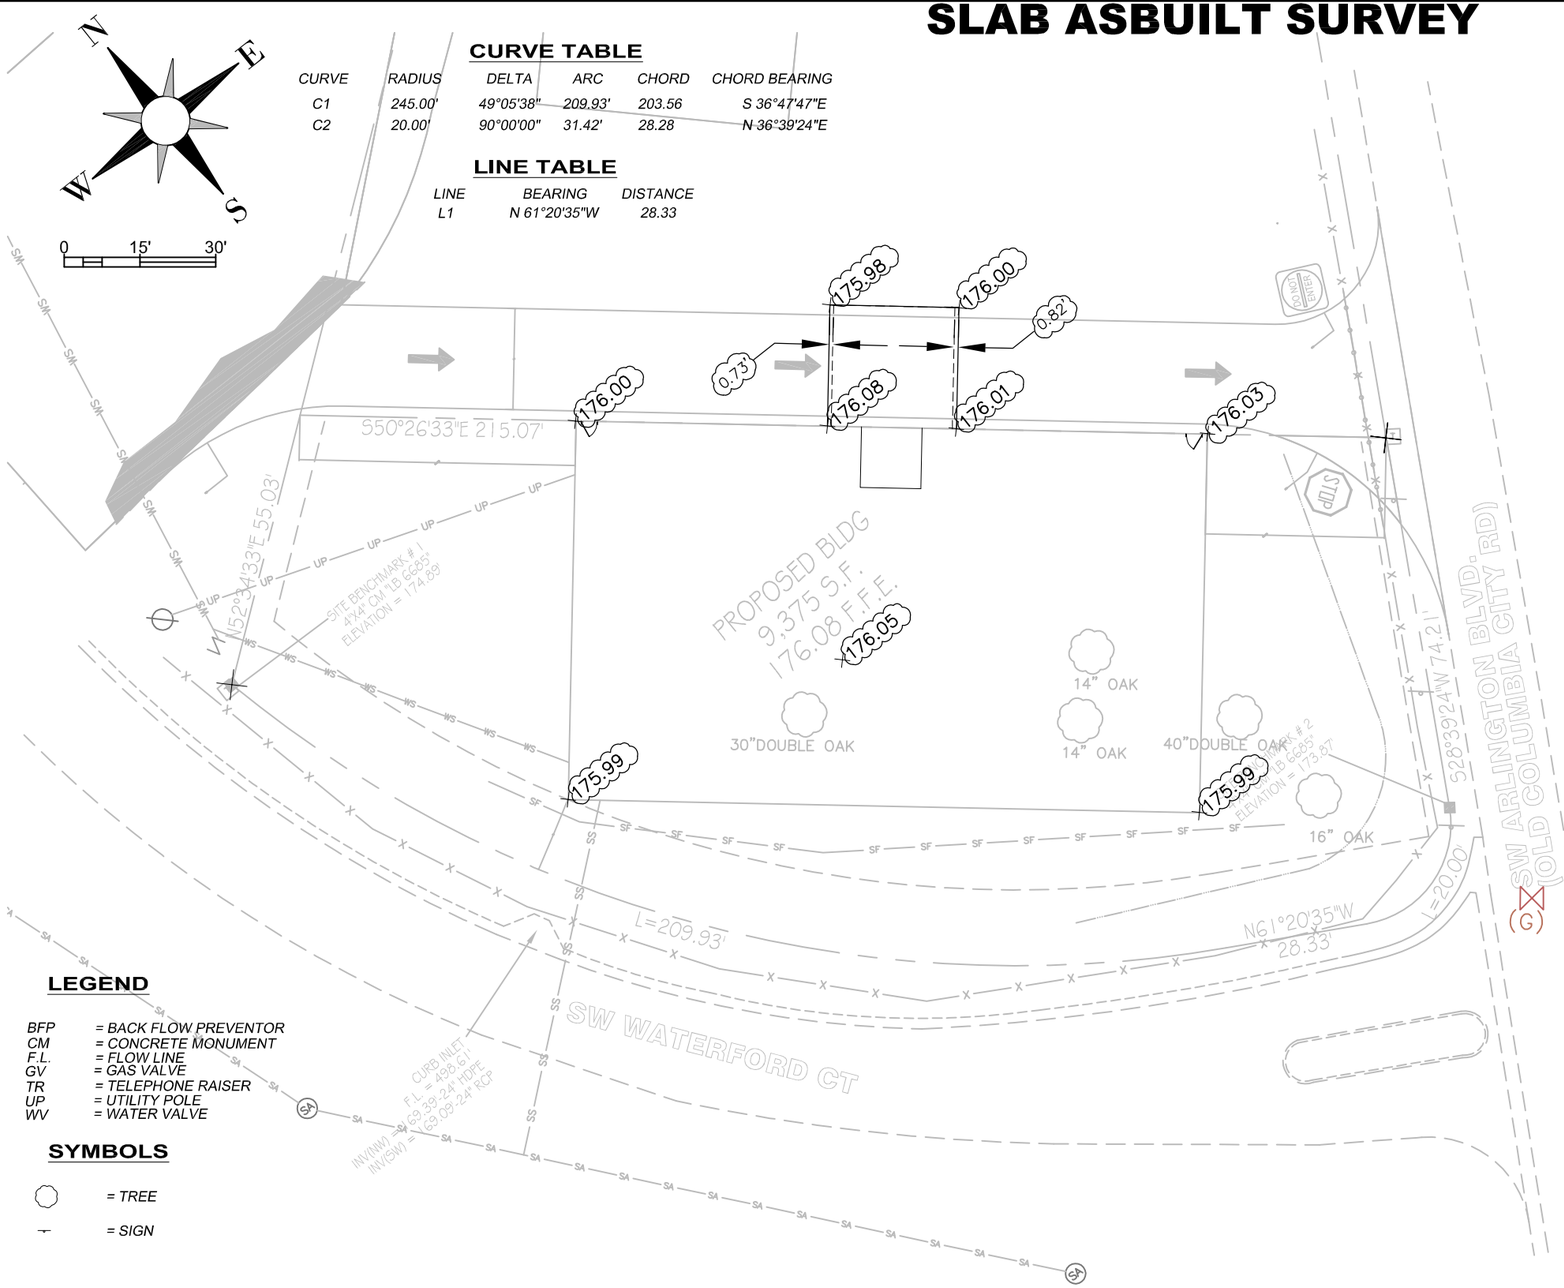

LEGEND

BFP	= BACK FLOW PREVENTOR
CM	= CONCRETE MONUMENT
F.L.	= FLOW LINE
GV	= GAS VALVE
TR	= TELEPHONE RAISER
UP	= UTILITY POLE
WV	= WATER VALVE

SYMBOLS

= TREE

= SIGN

LEGEND

183.0 MEASURED DISTANCE

183.0 SPOT ELEVATION

SURVEYOR'S NOTES

1. This is not a Boundary Survey.
2. Clouded areas denote as–built information. Other information shown hereon without clouds or ghosted is not part of this survey, and is shown for informational purposes only.
3. Utilities were not located during this survey.
4. Elevations shown hereon are based on Benchmark #1 as provided by the client and having an elevation of 174.89 feet. (NAVD datum).
5. This Map of Survey is valid only if digitally signed and sealed in accordance to chapter 5J–17.062 of the F,A,C and Chapter 472 of the Florida Statutes

SURVEYOR'S CERTIFICATION

I hereby certify that this survey, subject to the surveyor's notes contained hereon, meets the applicable "Standards of Practice" set forth by the Florida Board of Professional Surveyors and Mappers in Chapter 5J–17 of the Florida Administrative Code, pursuant to Section 472.027, Florida Statutes.

AFFINE ENGINEERING AND SURVEYING, INC
(Certificate of Authorization Number LB 7828)

Victor O. Marrero
Professional Surveyor and Mapper
Certificate Number LS 6586

Survey Date 4/14/23

This Map of Survey is valid only if digitally signed and sealed in accordance to chapter 5J–17.062 of the F,A,C and Chapter 472 of the Florida Statutes

Victor O Marrero

Digitally signed by Victor O Marrero
Date: 2023.05.03 14:59:41 -04'00'

VICTOR O. MARRERO
LICENSE NUMBER
LS6586
STATE OF FLORIDA
PROFESSIONAL SURVEYOR AND MAPPER

DRAWING 22013–2
SHEET 1 OF 1

PREPARED FOR:

PLUMB LEVEL

LOT 22 MIDTOWN COMMERCIAL CENTER
COLUMBIA COUNTY, FLORIDA.

AFFINE ENGINEERING AND SURVEYING, INC

TELEPHONE NUMBER 407–421–5534
128 NW GREEN LANE, LAKE CITY, FLORIDA 32055
CERTIFICATE OF AUTHORIZATION: LB 7828

CIVIL ENGINEERS SURVEYORS

No.	DATE	REVISIONS

DRAWN BY VM CHECKED BY VM

DATE 4/14/2023 SCALE 1"=30'

FIELD BOOK FB–1 JOB # 22013

THIS SURVEY IS NOT COVERED BY PROFESSIONAL LIABILITY INSURANCE